

14.11.02


Steel Twin Screw Passenger + Cargo Steamer

Longitudinal Plan

Principal Dimensions
Length overall 435'-0"
Length between perpendiculars 420'-0"
Breadth extreme 51'-6"
Depth moulded to upper deck 30'-6"
Depth of hold 27'-8 1/2"
Draft of water 27'-8 1/2"
Scale 1/8" = 1 Foot

No 1

No 139

 

By W. G. & T. R. SHIPYARD, NEWCASTLE-ON-TYNE.
1902.

Messrs Armstrong Whitworth & Co


S. S. — May 39.

Longitudinal Plan

~~"Wm S S Martzburg"~~

"Mrs. S. S. Mendoza"

SP² 49.382

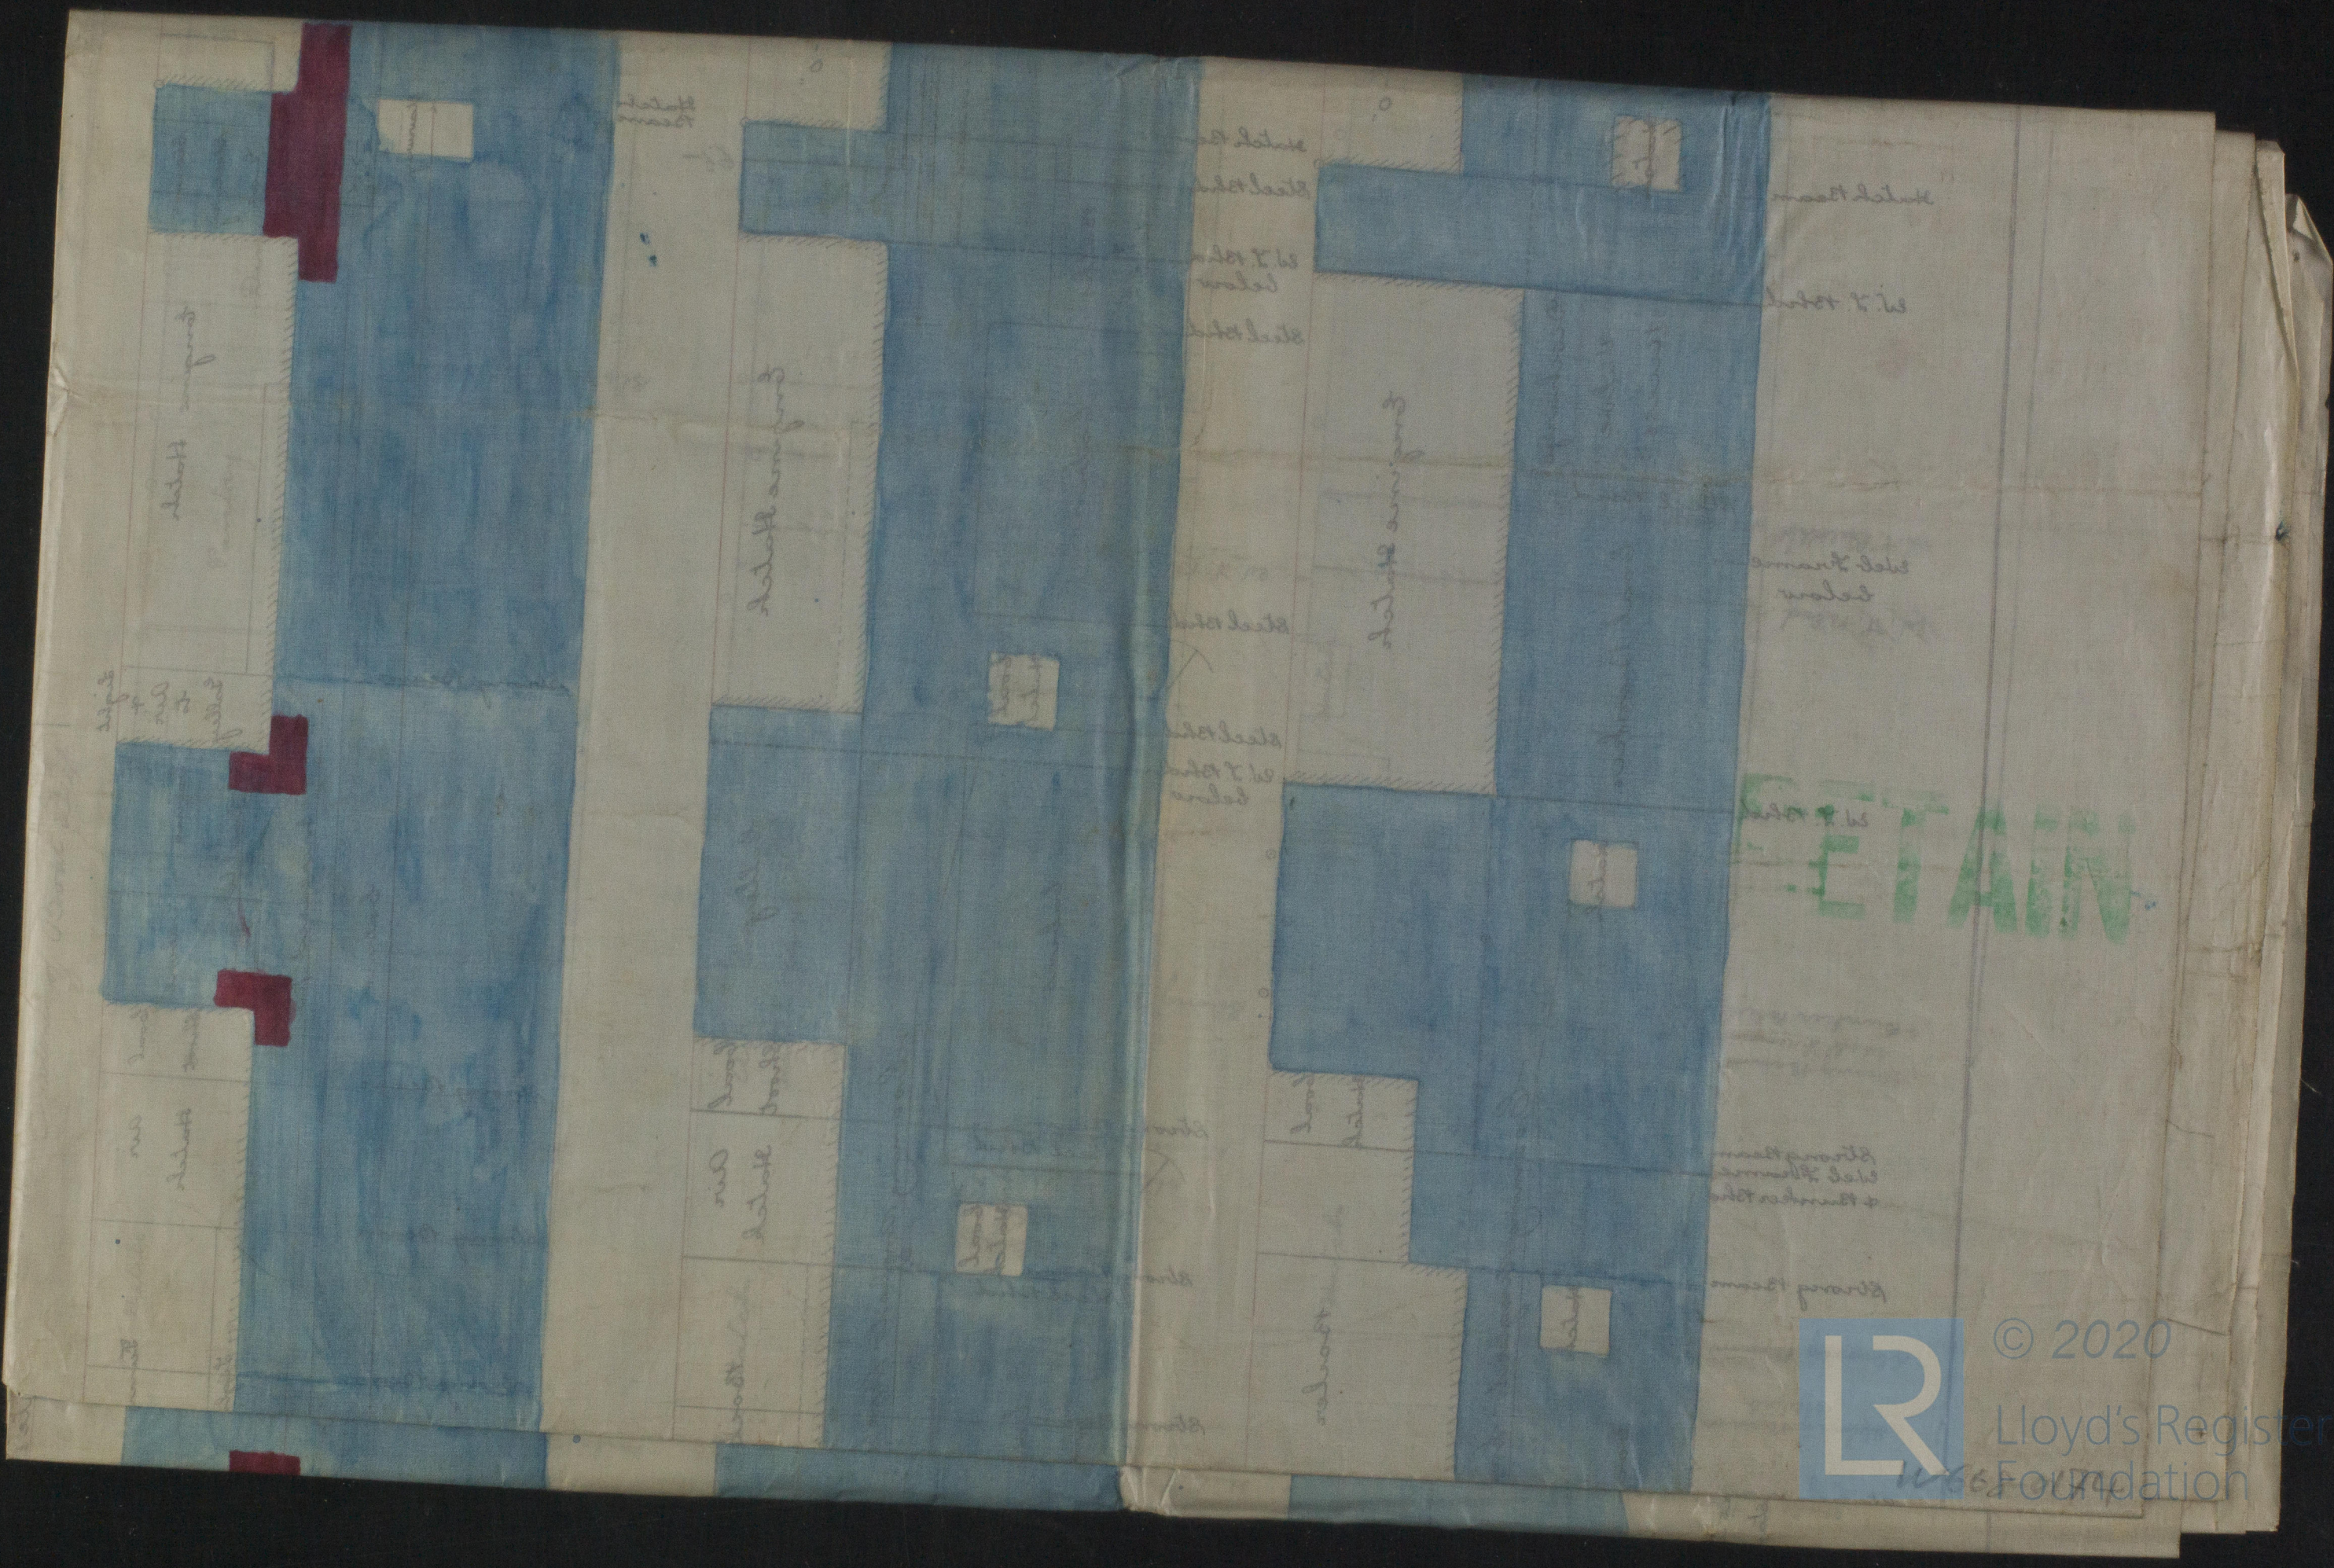

© 2020

Lloyd's Register
Foundation