

DIMENSIONS.
 LENGTH B.P. 342'-0"
 BREADTH MLD 50'-8"
 DEPTH MLD 25'-1 1/2"
 TRACING N° 8257

S.S. N° 117. 120. 121.
MIDSHIP SECTION.
 SCALE 1/2" = 1 FT
 CLASS 100A.1 LLOYDS.


No 117 - "Ederman"
 120 - "Blamorgan"
 121 - "O.A. Knudsen"

NUMERALS
 1/2 BEAM 25.33
 1/2 GIRTH 47.2
 DEPTH 26.17
 FRAMES 98.7 97/103
 987-7 = 91.7
 340.16 x 91.7 = 31193 PLATING N° 287/31200
 5 = 12.9 1/2 = 6.7
 340.16 x 98.7 = 33574

POOP 45.8 x 7.0 = 320.6
 BRIDGE 100 x 7.0 = 700.0
 FORECASTLE 36.75 x 7.0 = 257.25
 12 TIMES 1277.81
 ERECTIONS 1916.71

EQUIPMENT TO UPPER DECK 33574
 ERECTIONS 1916
 HOUSES 357
 EQUIPMENT NUMBER 33847

2-11-05
 10-11-05
 25-11-05
 18-12-05
 8-3-06

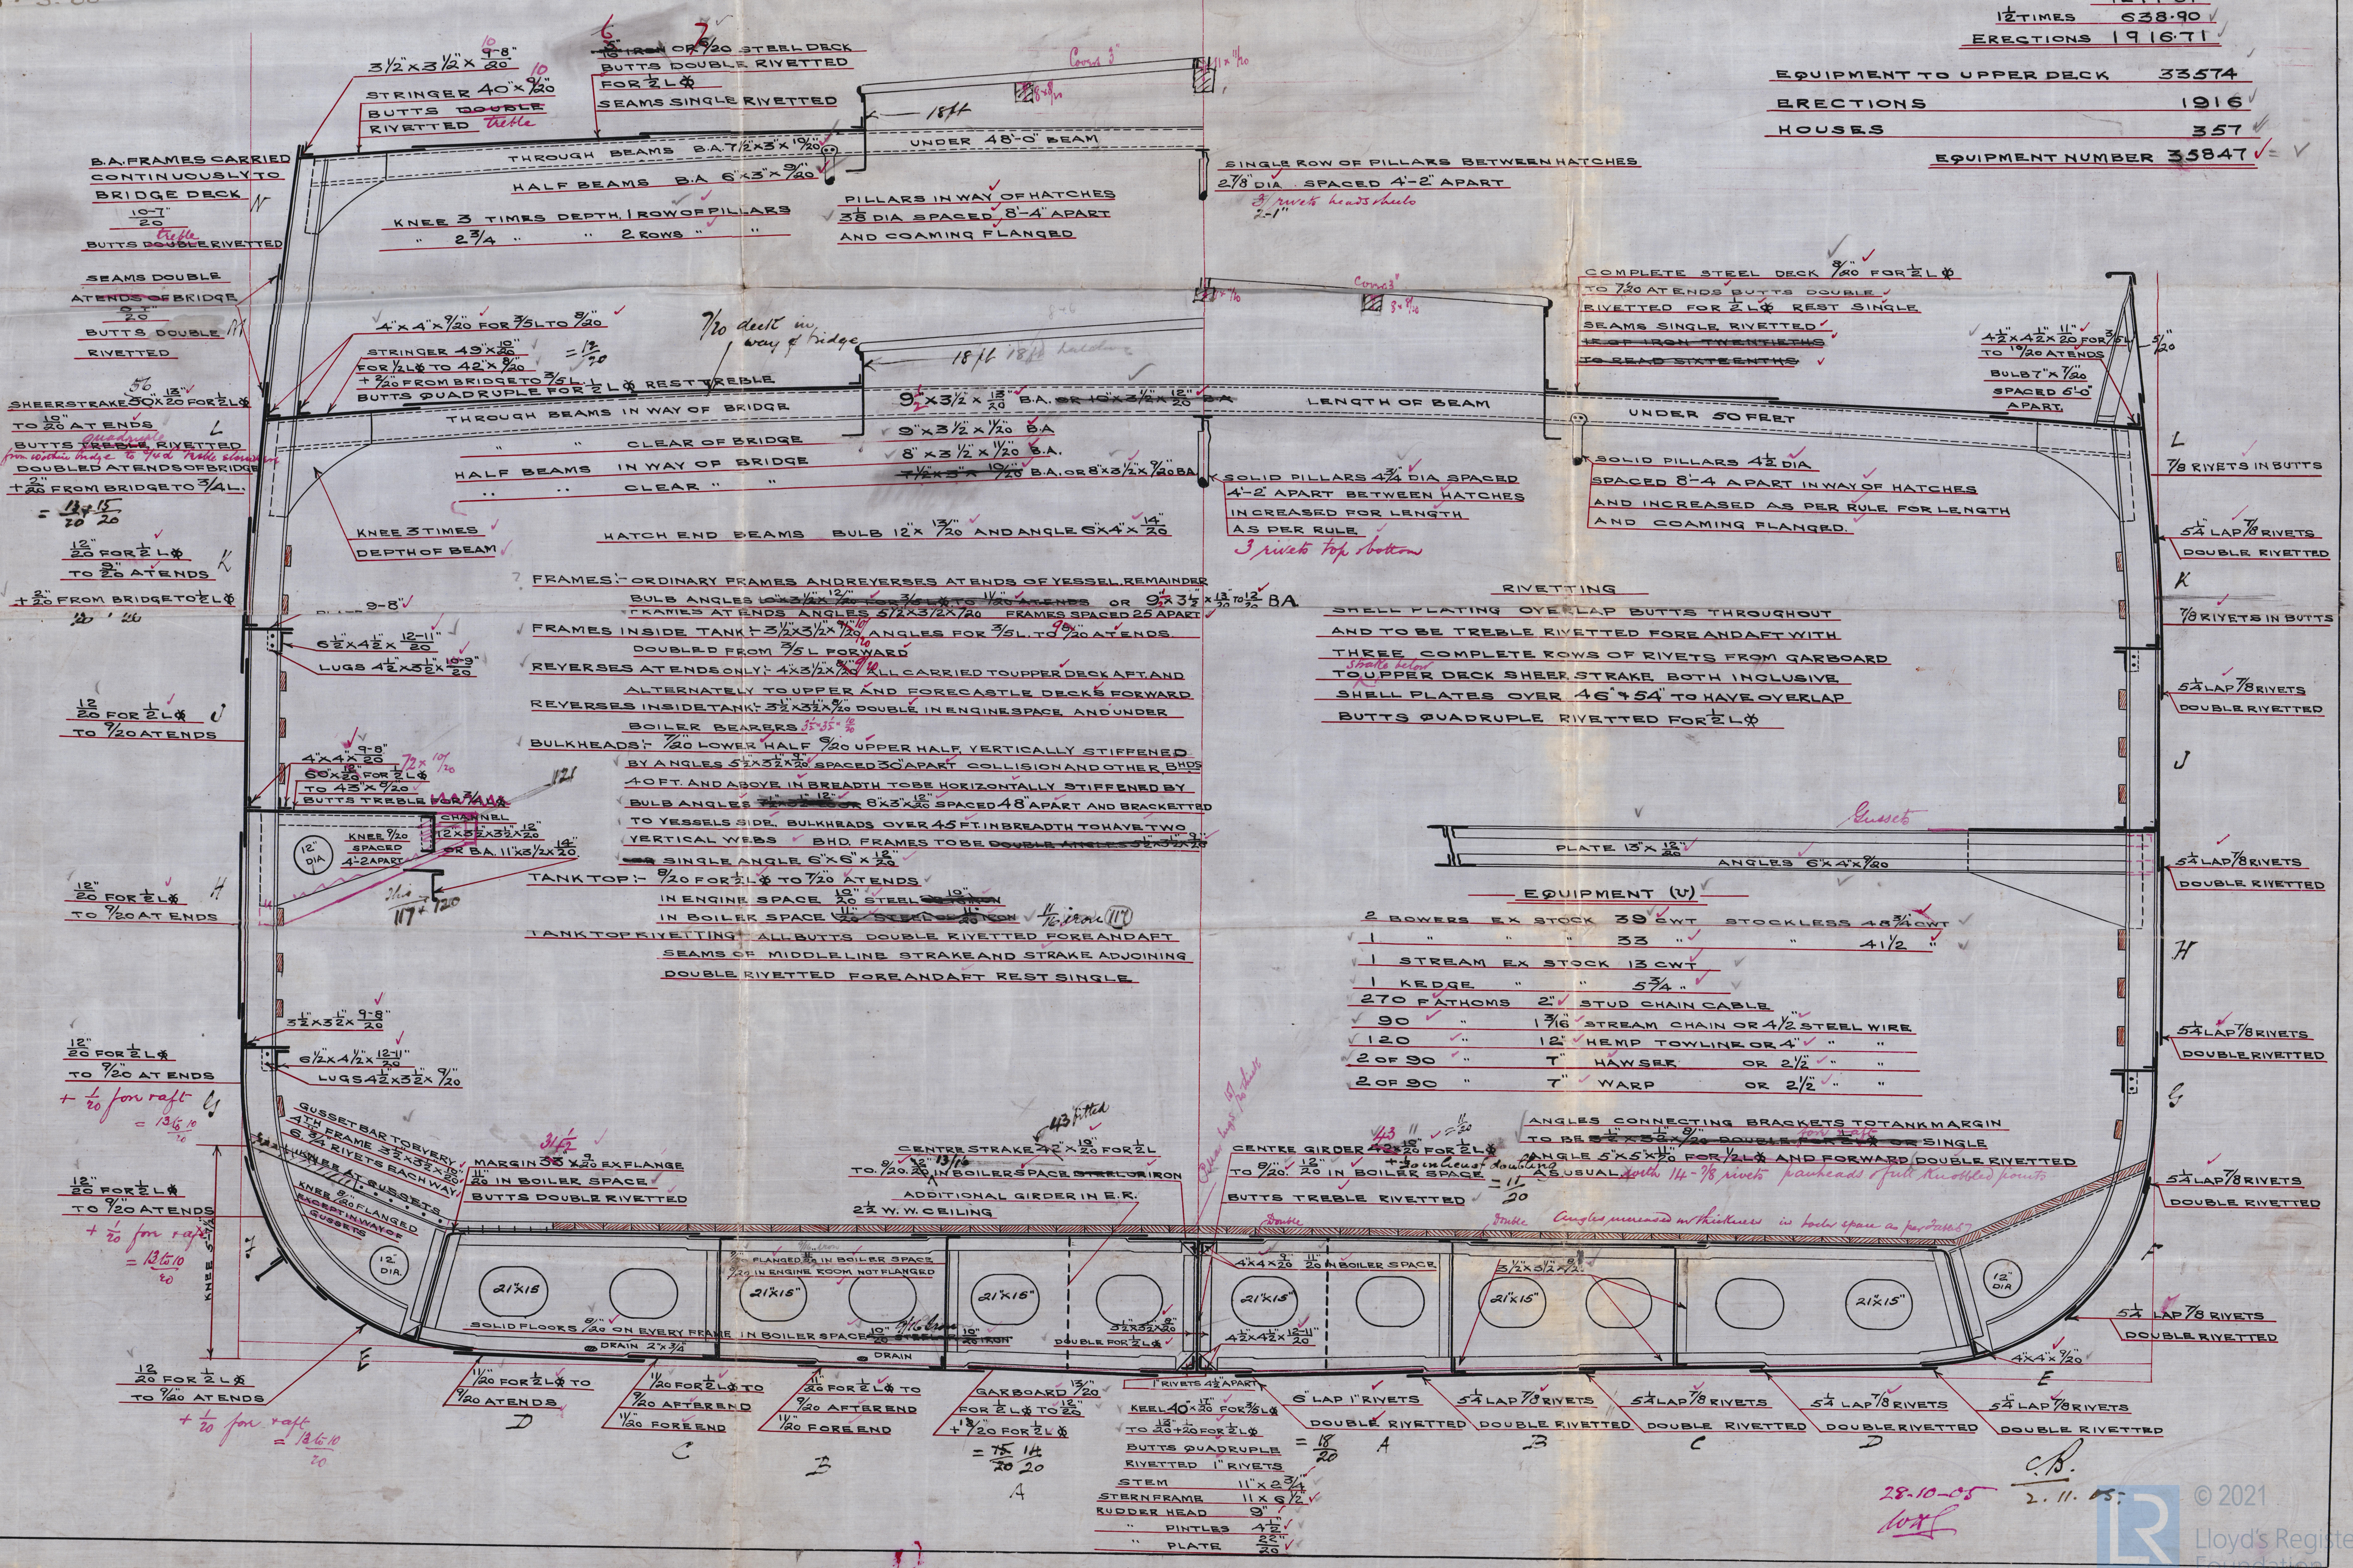

RIVETTING
 SHELL PLATING OVER LAP BUTTS THROUGHOUT
 AND TO BE TREBLE RIVETTED FORE AND AFT WITH
 THREE COMPLETE ROWS OF RIVETS FROM GARBORDE
 TO UPPER DECK SHEER STRAKE BOTH INCLUSIVE
 SHELL PLATES OVER 46" x 54" TO HAVE OVERLAP
 BUTTS QUADRUPLE RIVETTED FOR 2 L & R

EQUIPMENT (V)
 2 BOWERS EX STOCK 39 CWT STOCKLESS 45 1/2 CWT
 1 " " " 33 " " 41 1/2 " "
 1 STREAM EX STOCK 13 CWT
 270 FATHOMS 2" STUD CHAIN CABLE
 90 " 1 3/16" STREAM CHAIN OR 4 1/2" STEEL WIRE
 120 " 12" HEMP TOWLINE OR 4 " "
 2 OF 90 " T HAWSER OR 2 1/2 " "
 2 OF 90 " T WARP OR 2 1/2 " "

ANGLES CONNECTING BRACKETS TO TANK MARGIN
 TO BE 5" x 5" x 20" DOUBLE RIVETTED FOR 2 L & R
 OR SINGLE RIVETTED FOR 1 L & R
 ANGLE 5" x 5" x 20" FOR 2 L & R AND FORWARD DOUBLE RIVETTED
 AS USUAL WITH 14-18 RIVETS PER HEAD OF FULL RIVETED POINTS

28-10-05
 10-11-05
 C.B.
 2. 11. 05

Craig Taylor
No 117, 120 & 121

Midship Section

"Ederman" 117

Mdb Report No 4432

"Hamorgans" 120

Mdb Report No 4815

"O.A. Knudsen" 121

Mdb Report No 4888



© 2021

Lloyd's Register
Foundation