

COPY

GRAMS, "REGISTER, NEWCASTLE"

TELEPHONE N^o CENTRAL 5190 (3 LINES)

Lloyd's Register of Shipping,

Collingwood Buildings, Newcastle-on-Tyne.

LLOYD'S REGISTER
LONDON.

REQD 29 JAN 1924


28th January, 1924.

ANS^d

Dear Sir,

Newcastle Report No. 77447.

Replying to your letter of the 26th instant respecting the steamer "MAID OF SPETSAI", I beg to say that the inlet pipes are fitted as indicated on sketch below, i.e., just above No.1 (hold) tank side line (not fore peak).

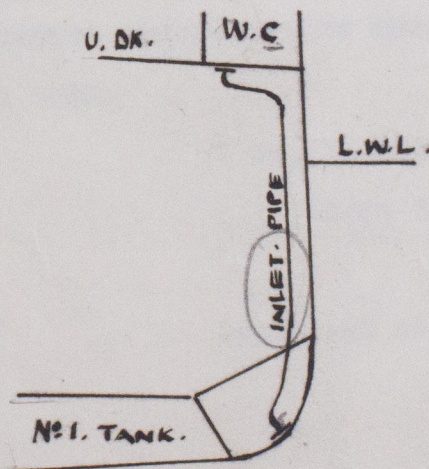

I am, Dear Sir,

Yours faithfully,

The Secretary,
London.



Lloyd's Register
Foundation

W678-0282


Lloyd's
192

Referred to Mr. S. A. Hill.

Handwritten signature

Handwritten signature

29 JAN 1924

 

© 2021

Lloyd's Register
Foundation