

SCALE $\frac{1}{8} \pm$ 1 FOOT

240-0 BP x 36-0 x 18-6 MOULDED


TO CLASS 100 A.I. AT LLOYDS

SCALE $\frac{1}{8}'' = 1 \text{ FOOT}$


240-0" BP x 36-0" x 18-6" MOULDED

TO CLASS 100 A.I. AT LLOYDS

2.6.20.

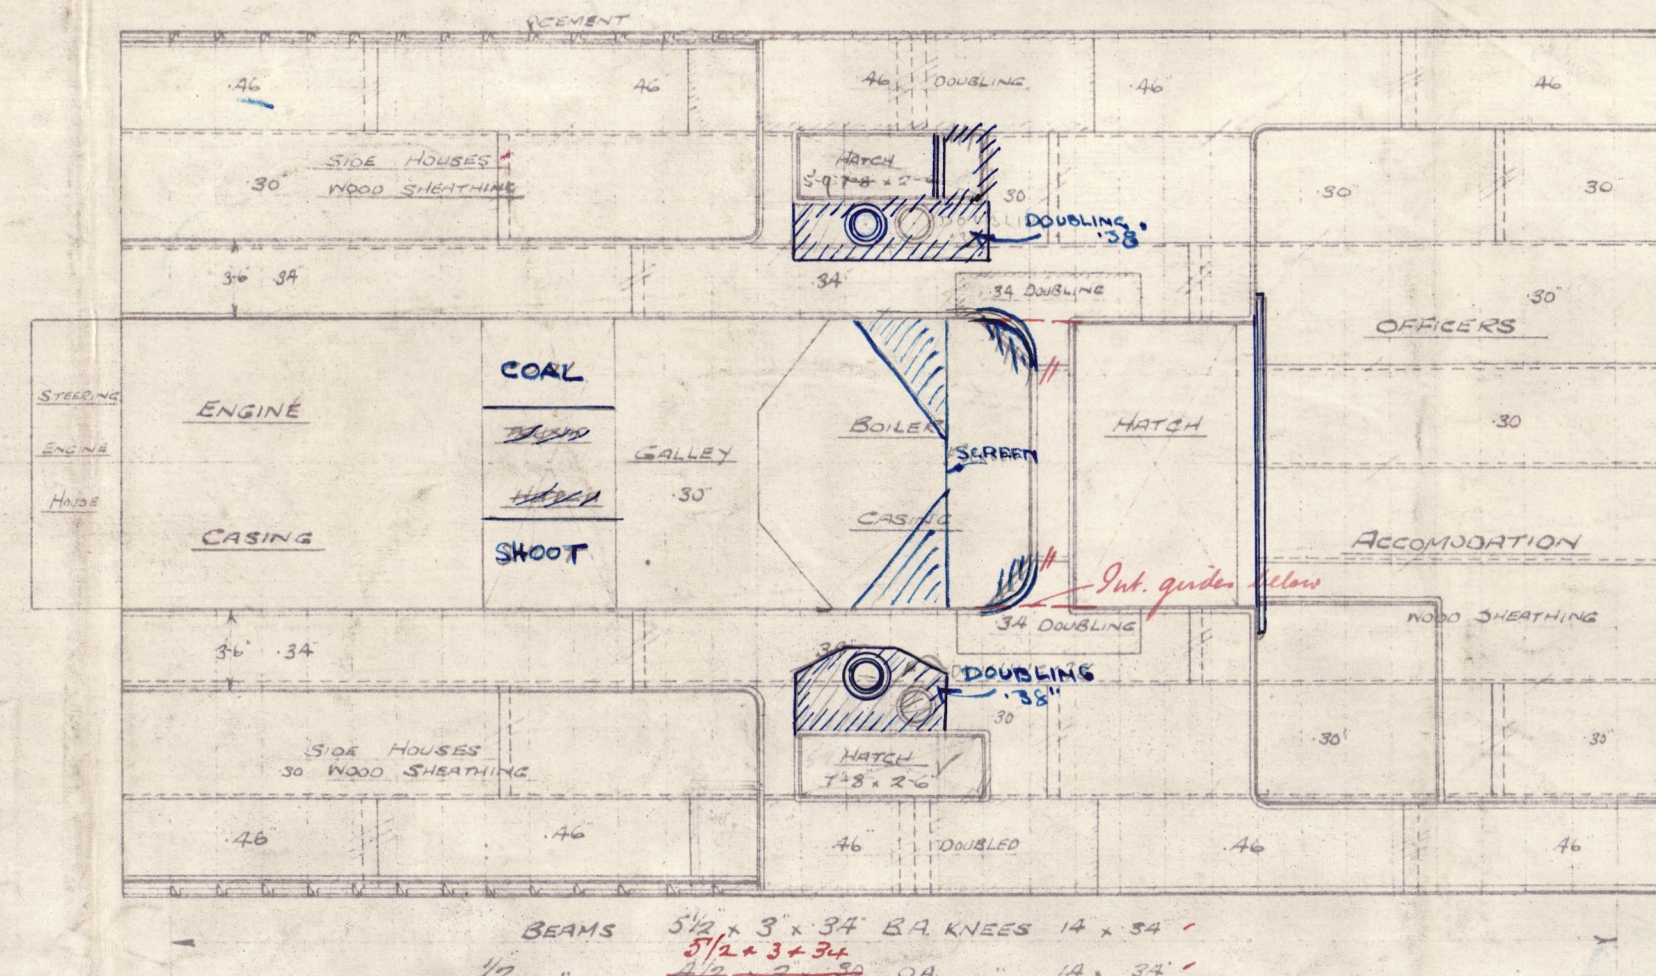


BRIDGE DECK ✓

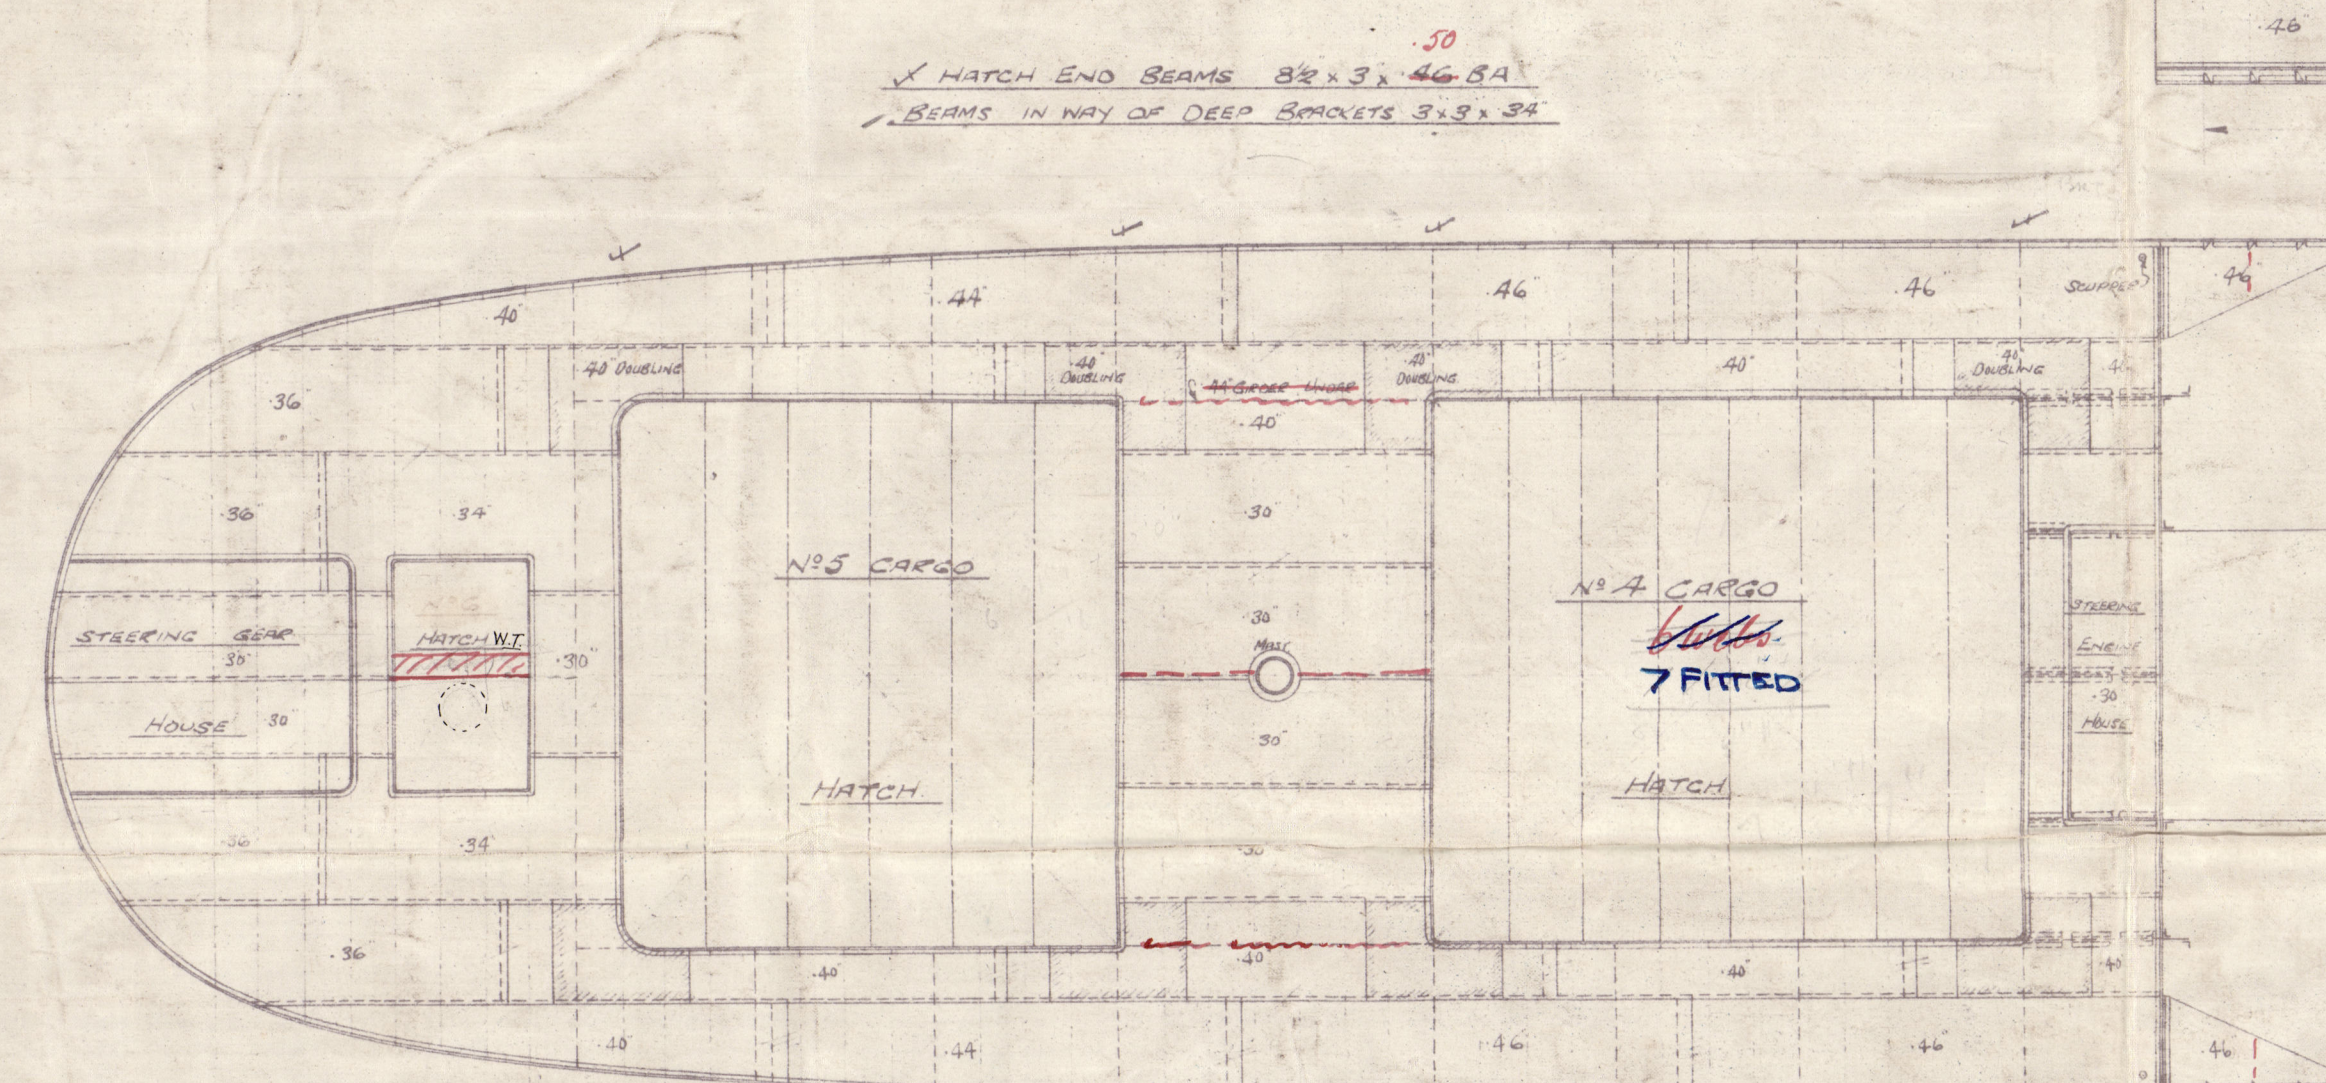

RAISED QUARTER DECK.

PLAN OF BUNKERS TO BE SUBMITTED SEPARATELY WHEN
OWNERS DECISION IS MADE RE CARRYING OIL THEREIN

ALL RIVETING AS PER RULE

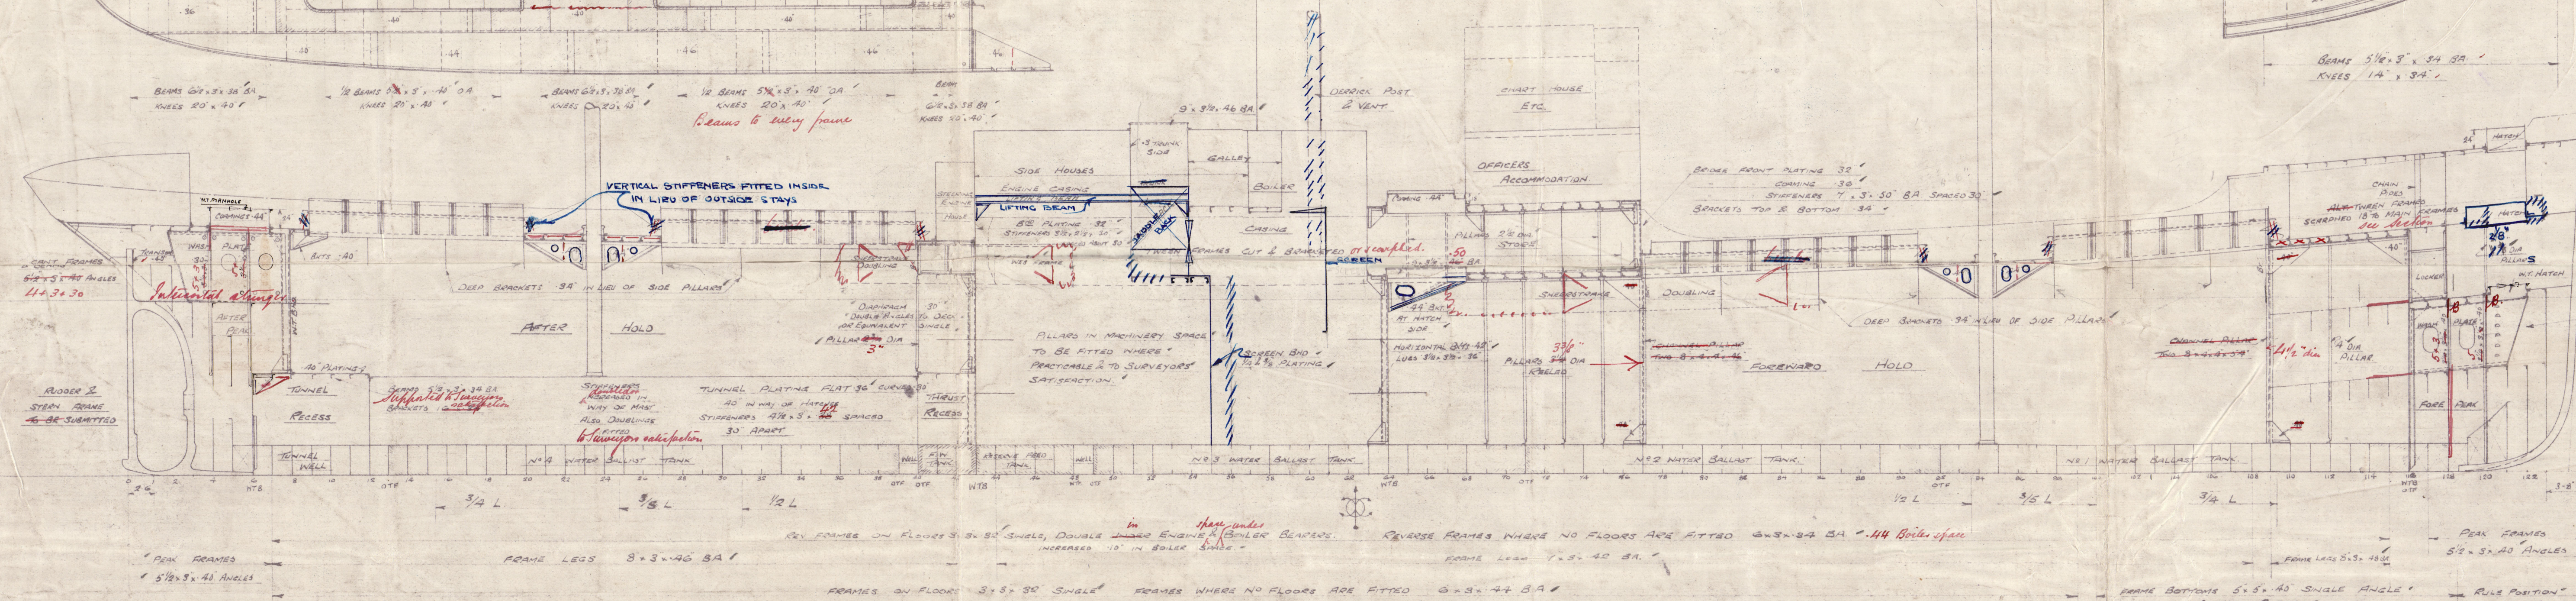


NOTE - TANK NOS 1 2 3 & 4 TO CARRY OIL

1. CENTRE LINE GROOVE IN TANK NO 3 + 2 3/4" TO BE ^{NEW} ~~MAINTAINED~~ TIGHT (~~PROPER~~ CAULKED)


* RIVETING IN ~~OUTSIDE~~ PLATING, INNER BOTTOM PLATING, BOUNDARY BARS TO OIL TIGHT FLOORS & DECK PLATING

~~BE IN ACCORDANCE WITH LOCAL SECTION OF LAW IN THESE COUNTRIES~~


W.T. BULKHEADS					
TO BE SUBMITTED					

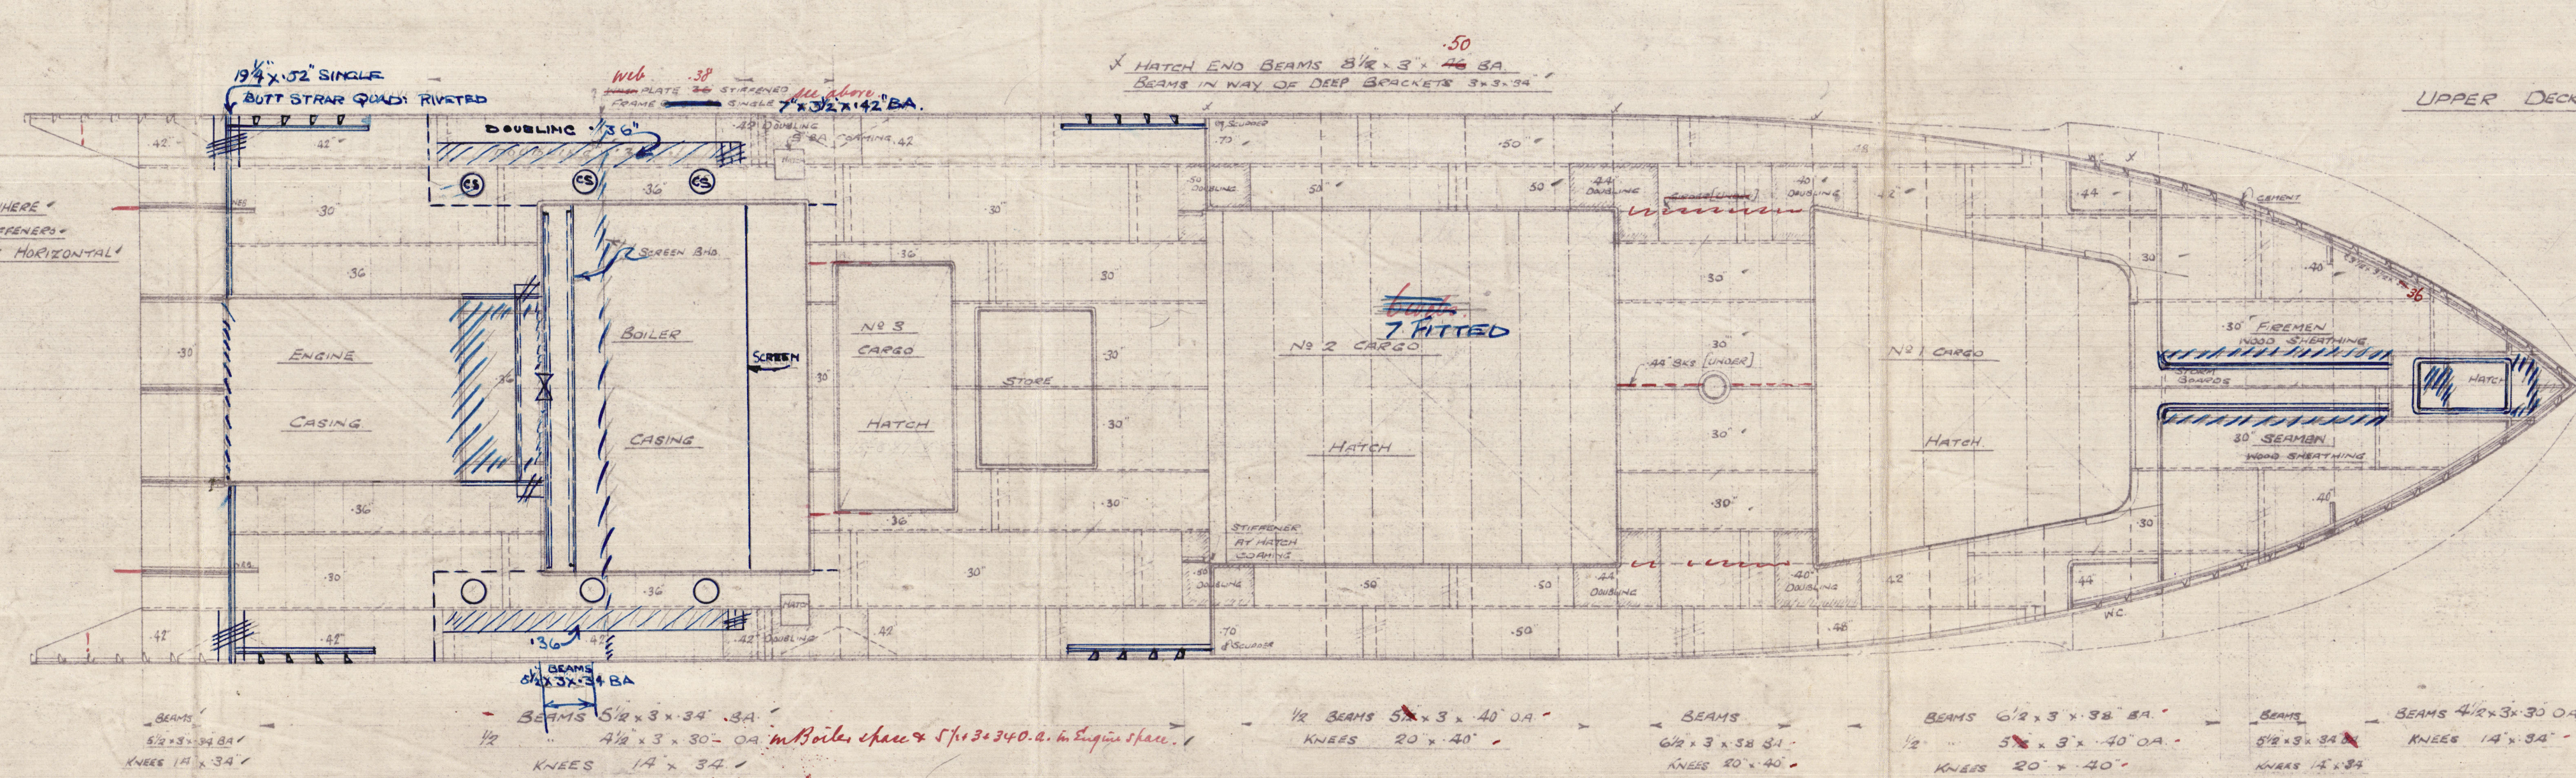


UPPER DECK

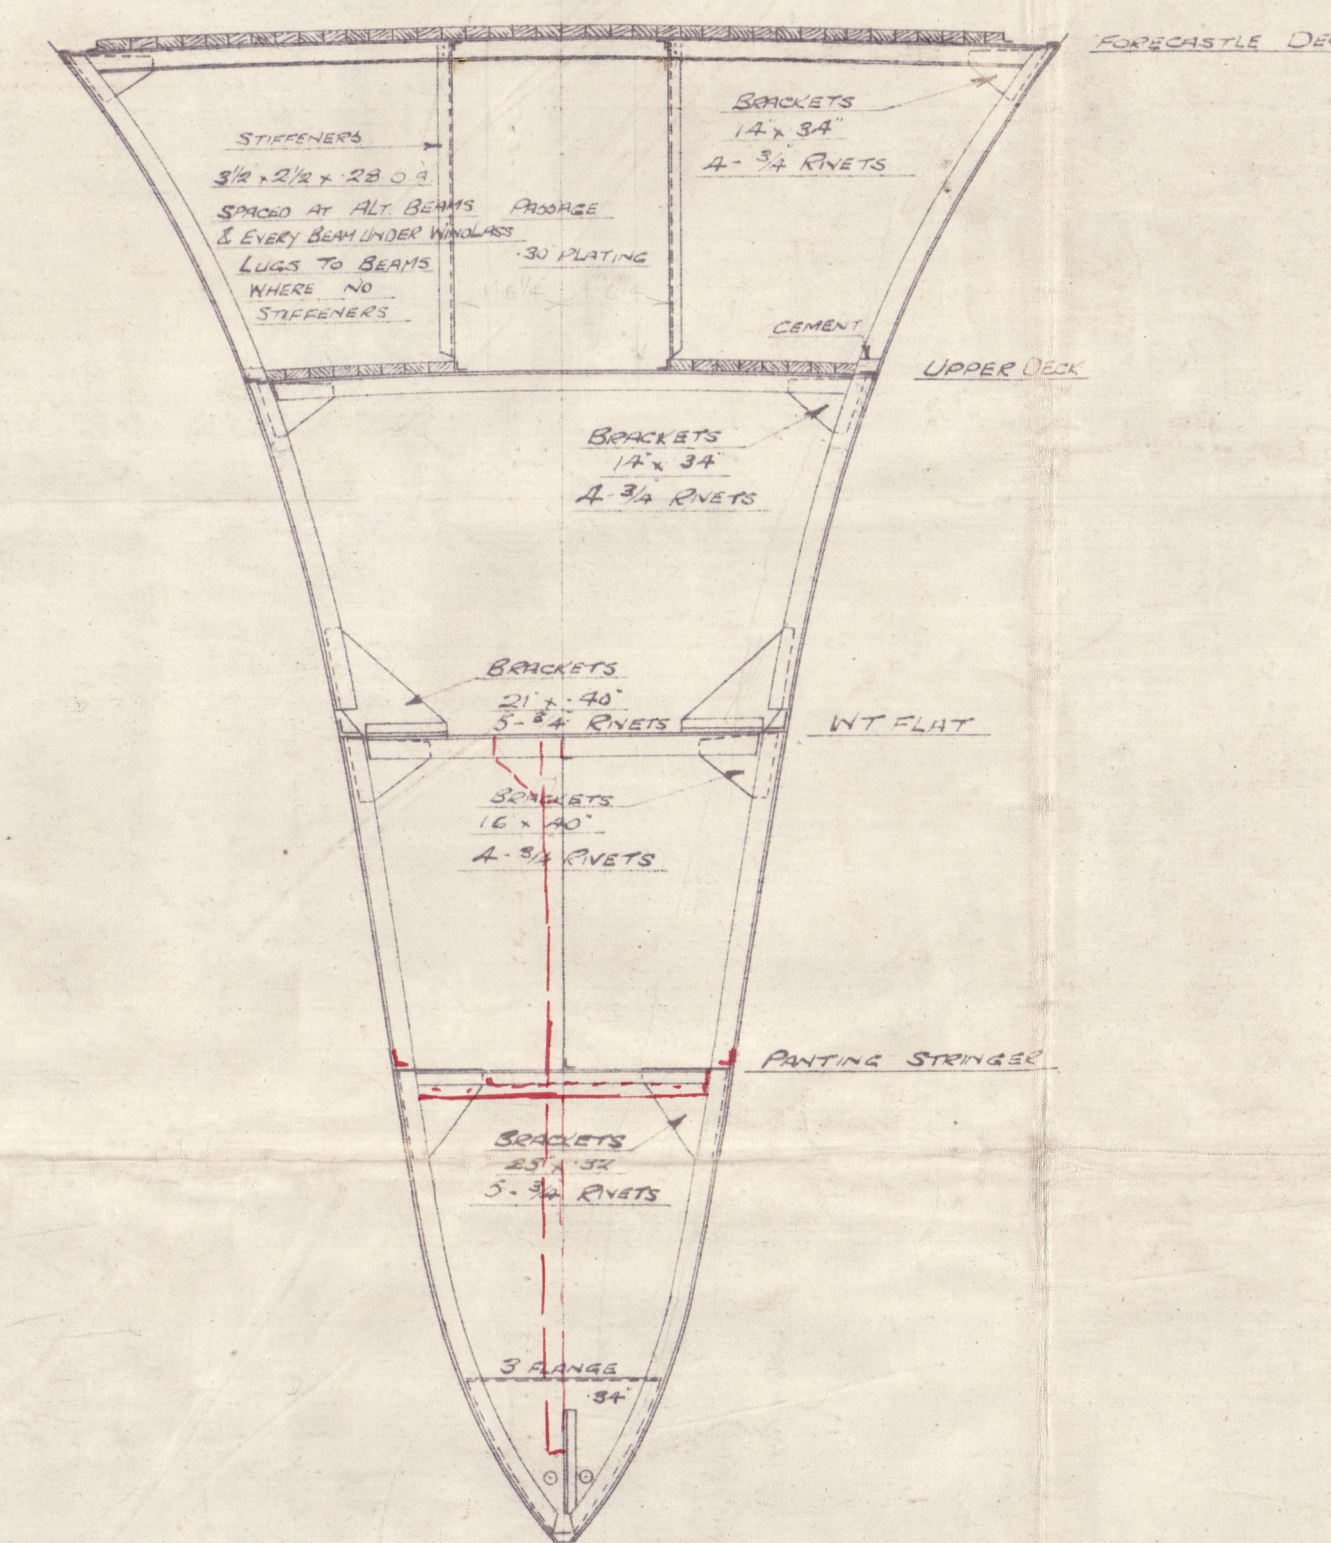


SECTION AT FRAME N° 119

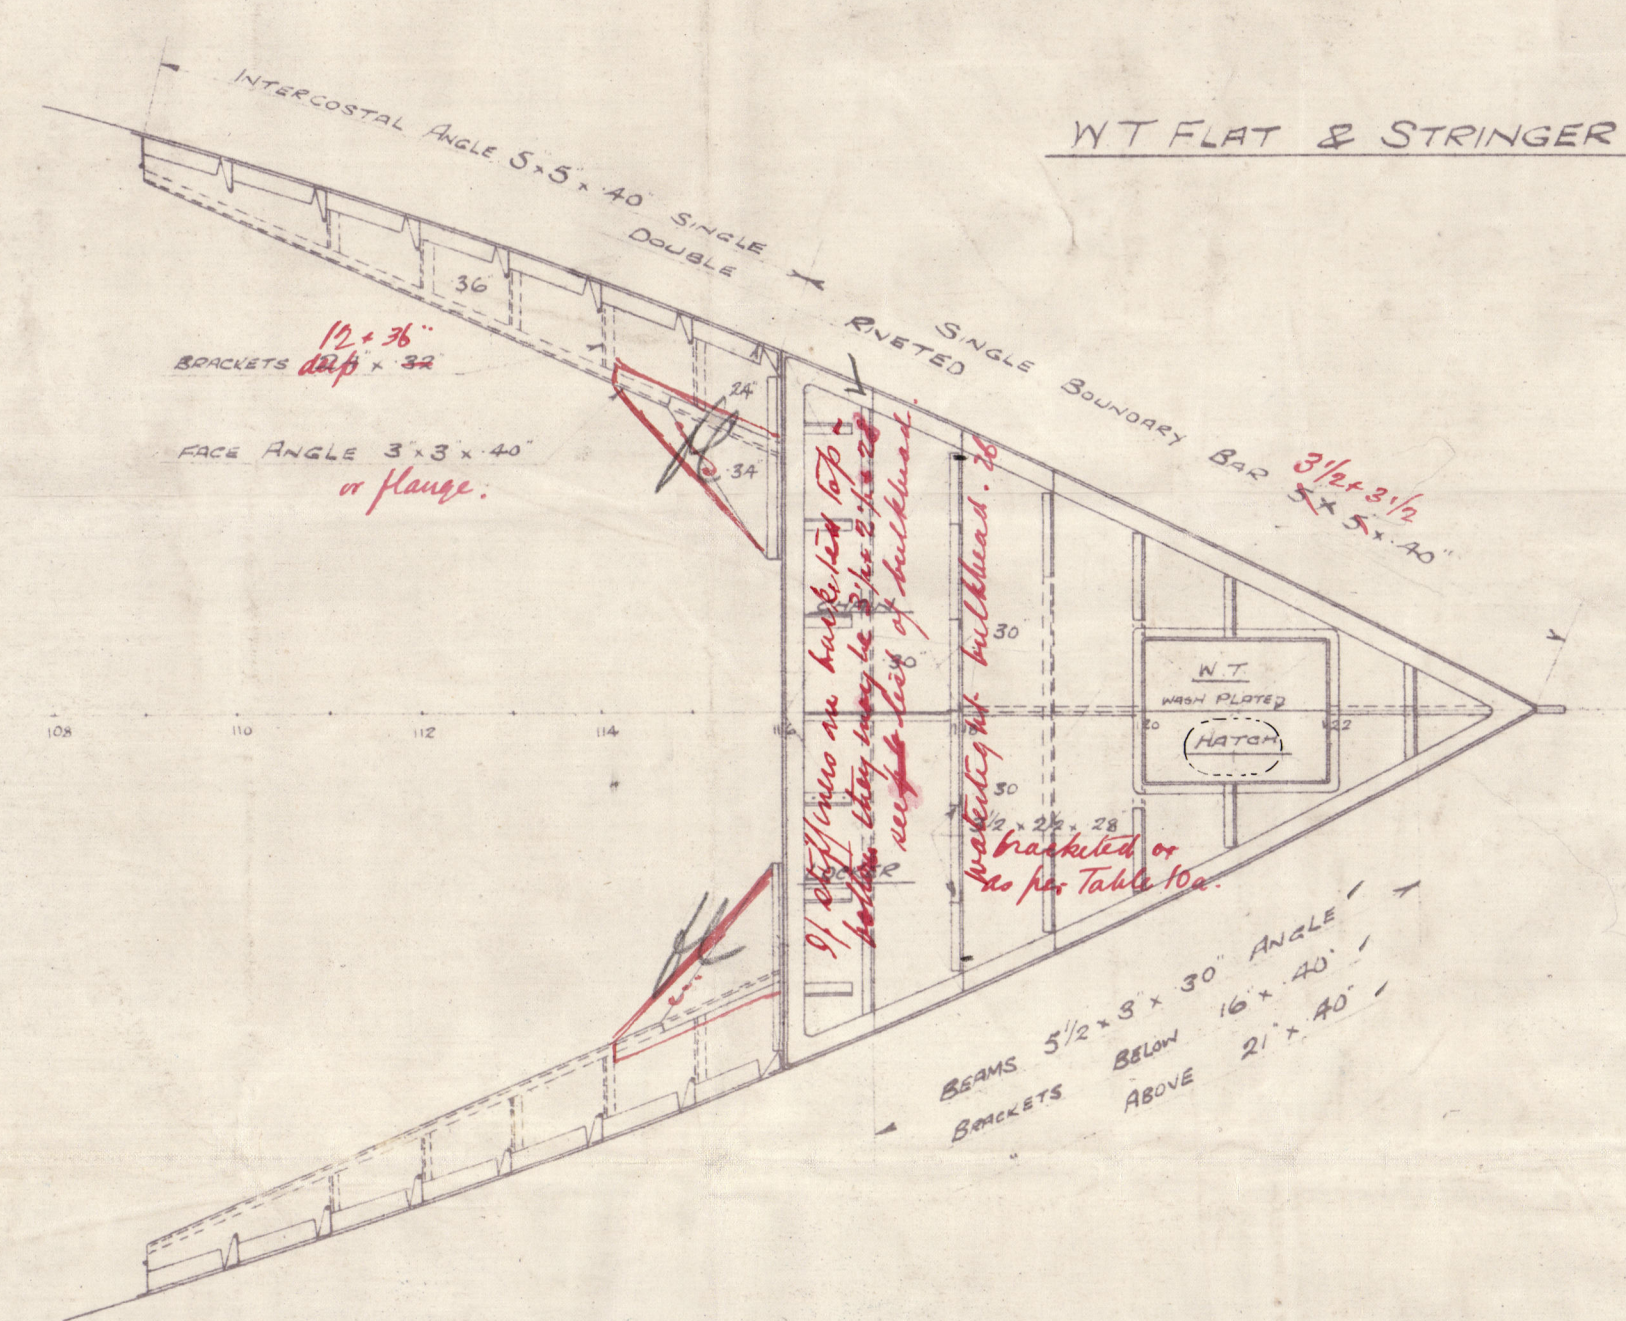

WT FLAT & STRINGER

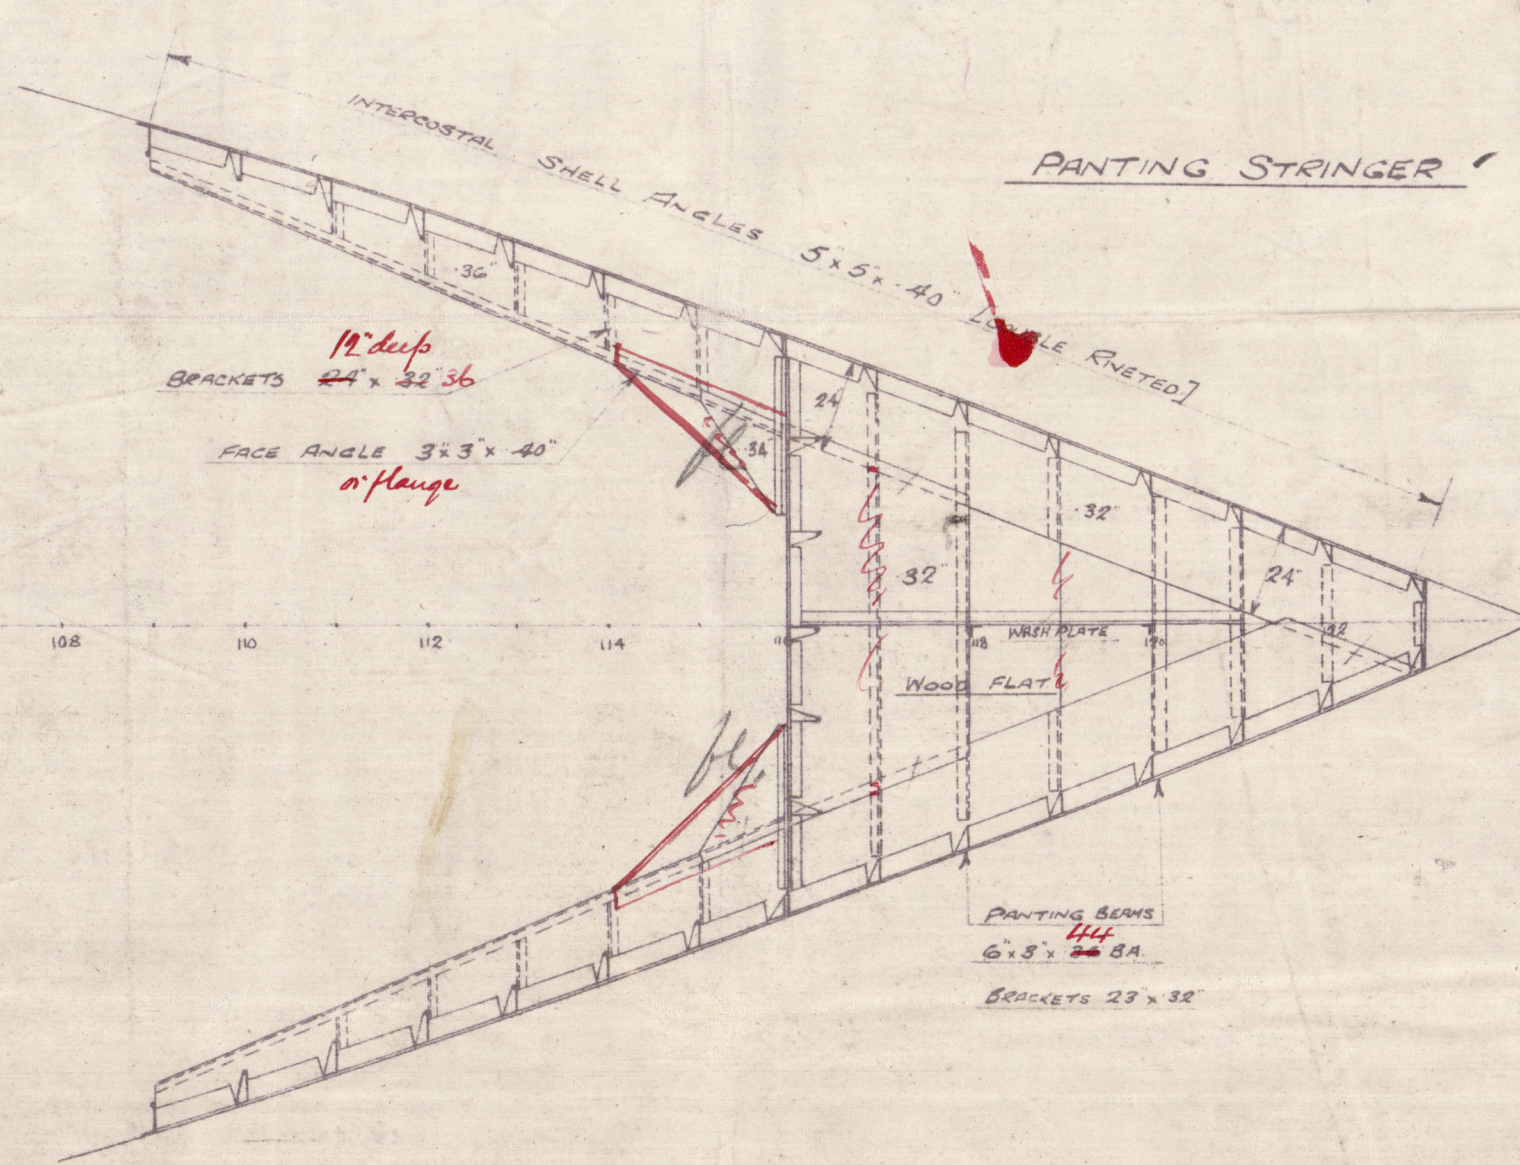


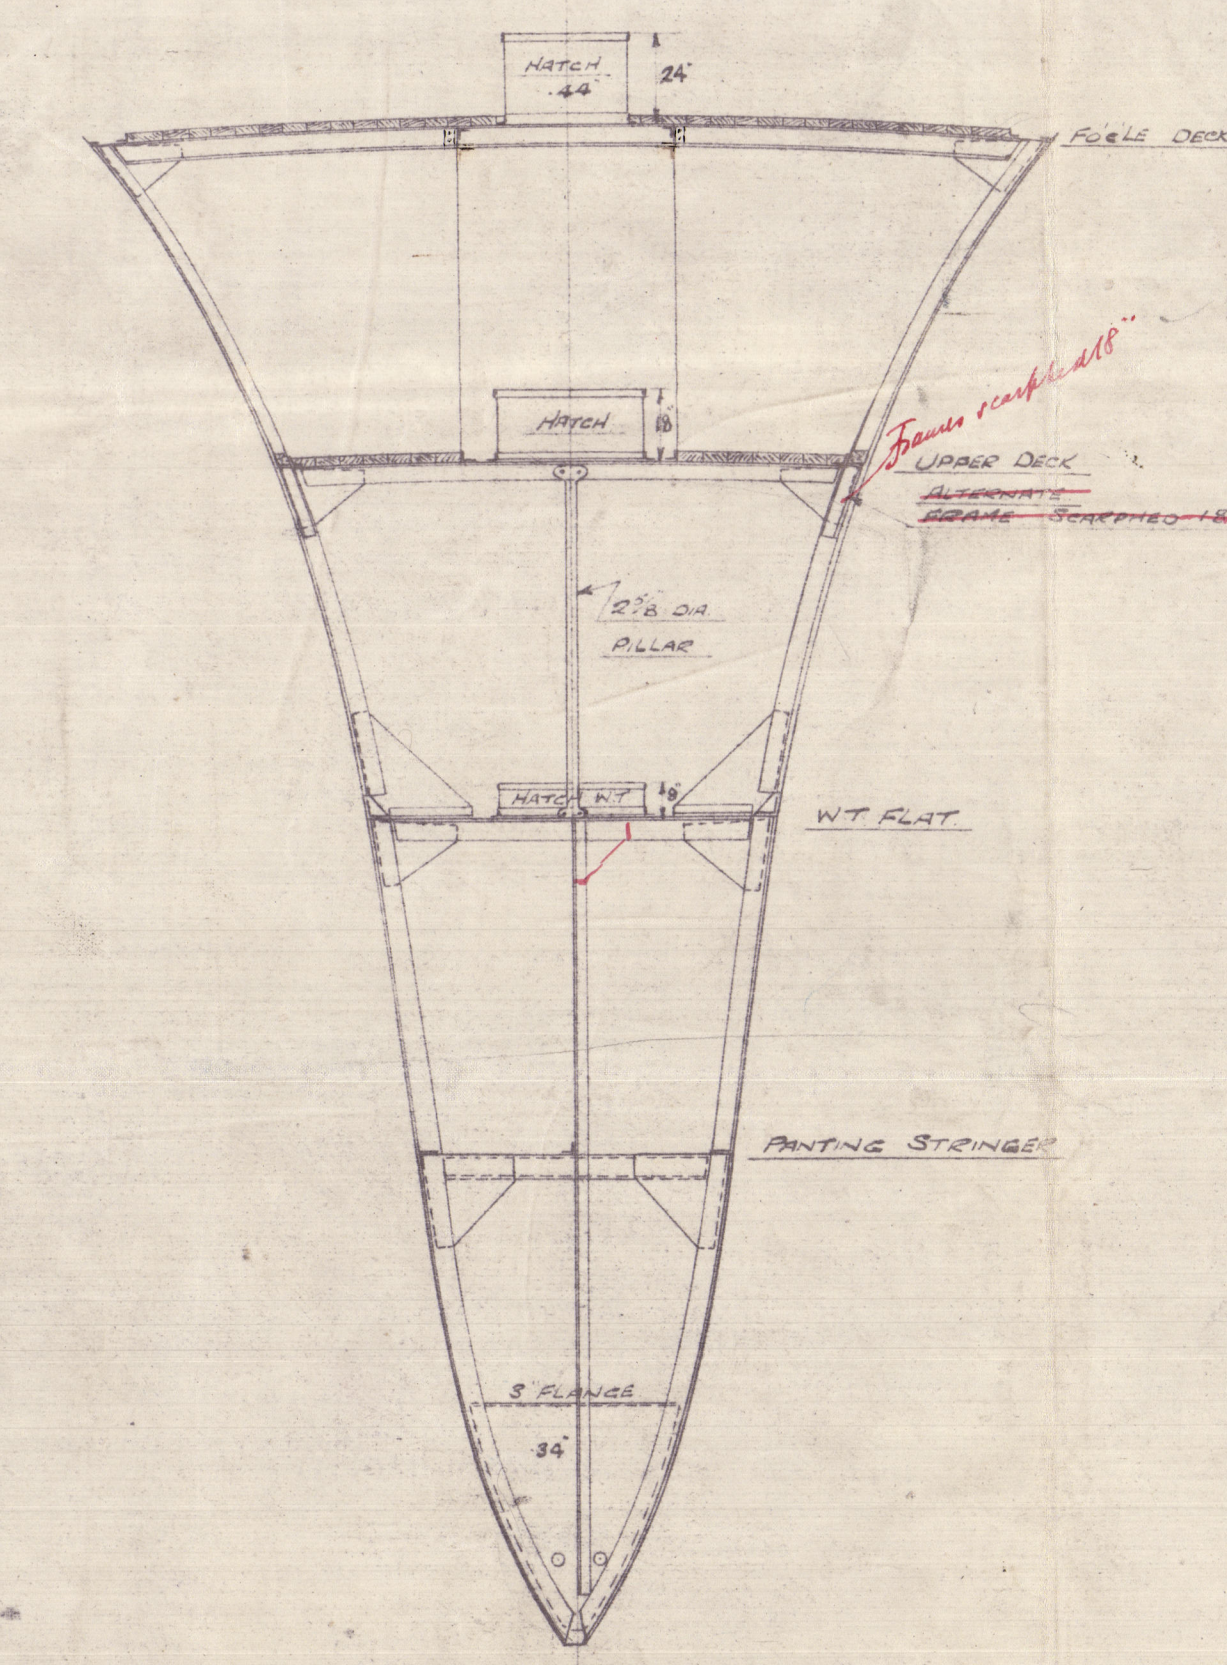

SECTION AT FRAME No 120

col.
1.6. no.

1000 & 1001

Messrs John S. Thornycroft & Co Ltd
Southampton.

Profile & Deck Plan for

"Jane" Nos 1000 + 1001.

"Maid of Speteai"

Lon. Rpt. 11115.

"Maid of Hydra"

Lon. Rpt. 11162.



© 2021

Lloyd's Register
Foundation