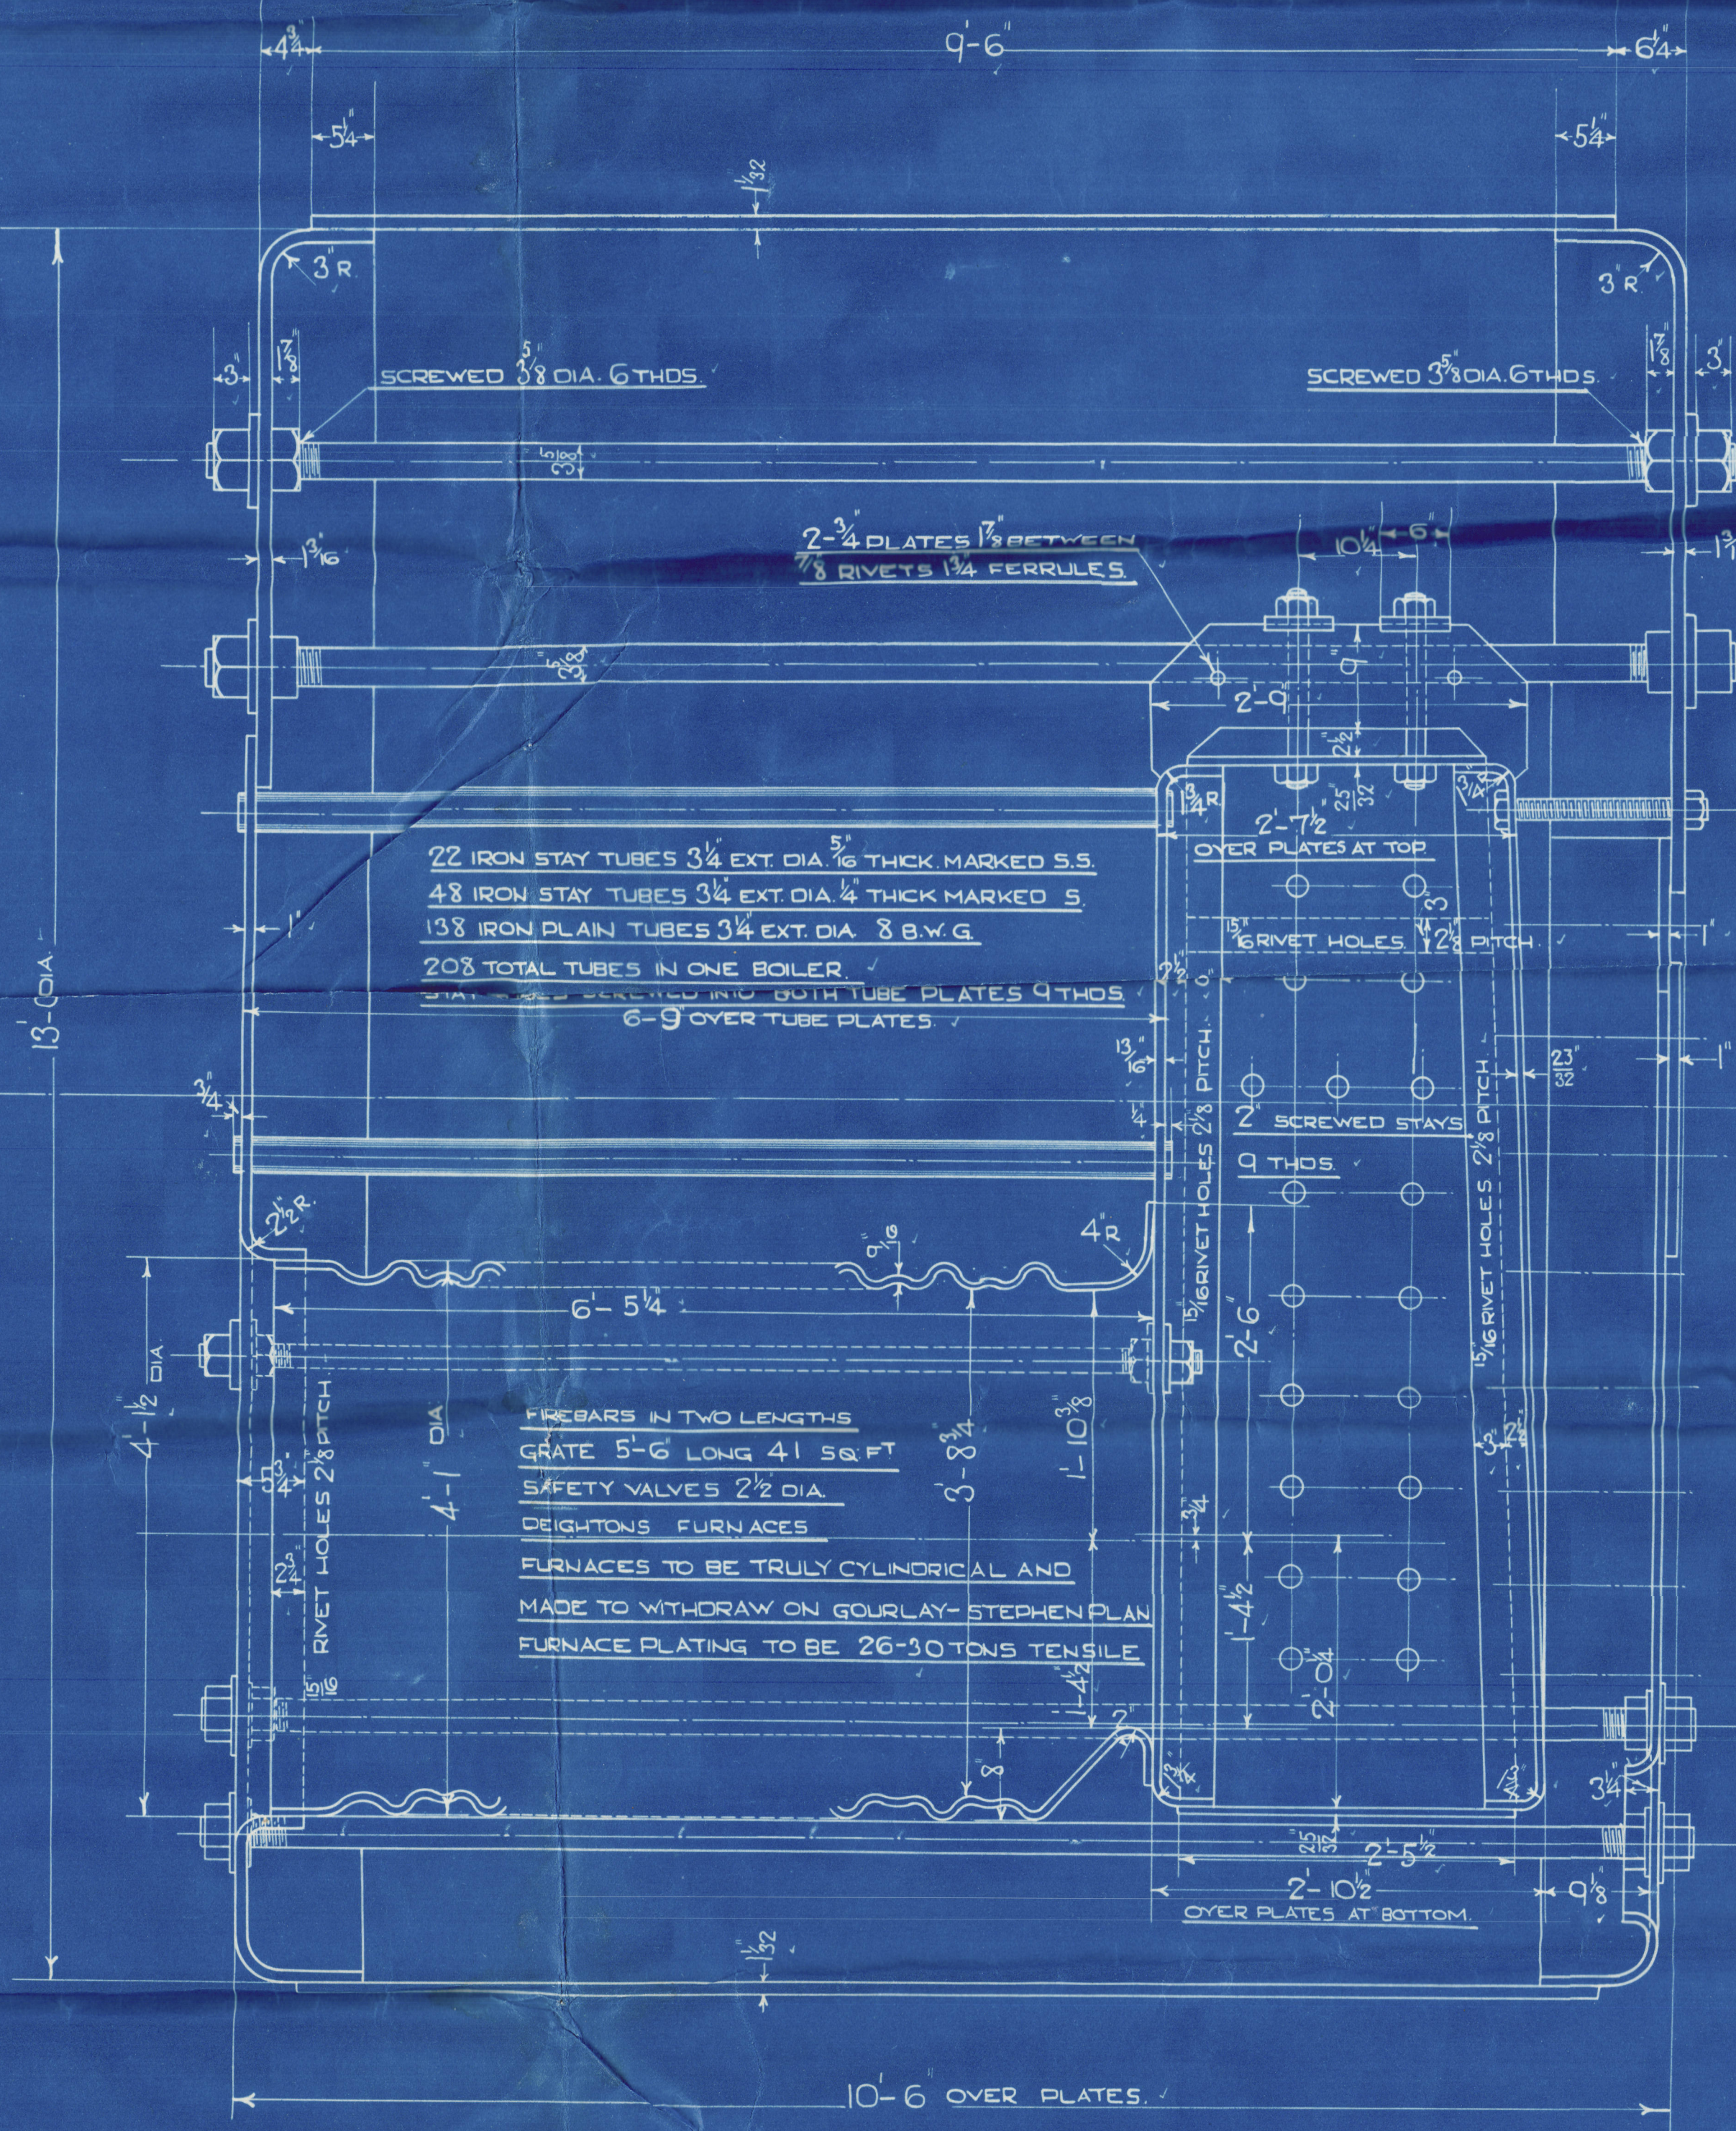
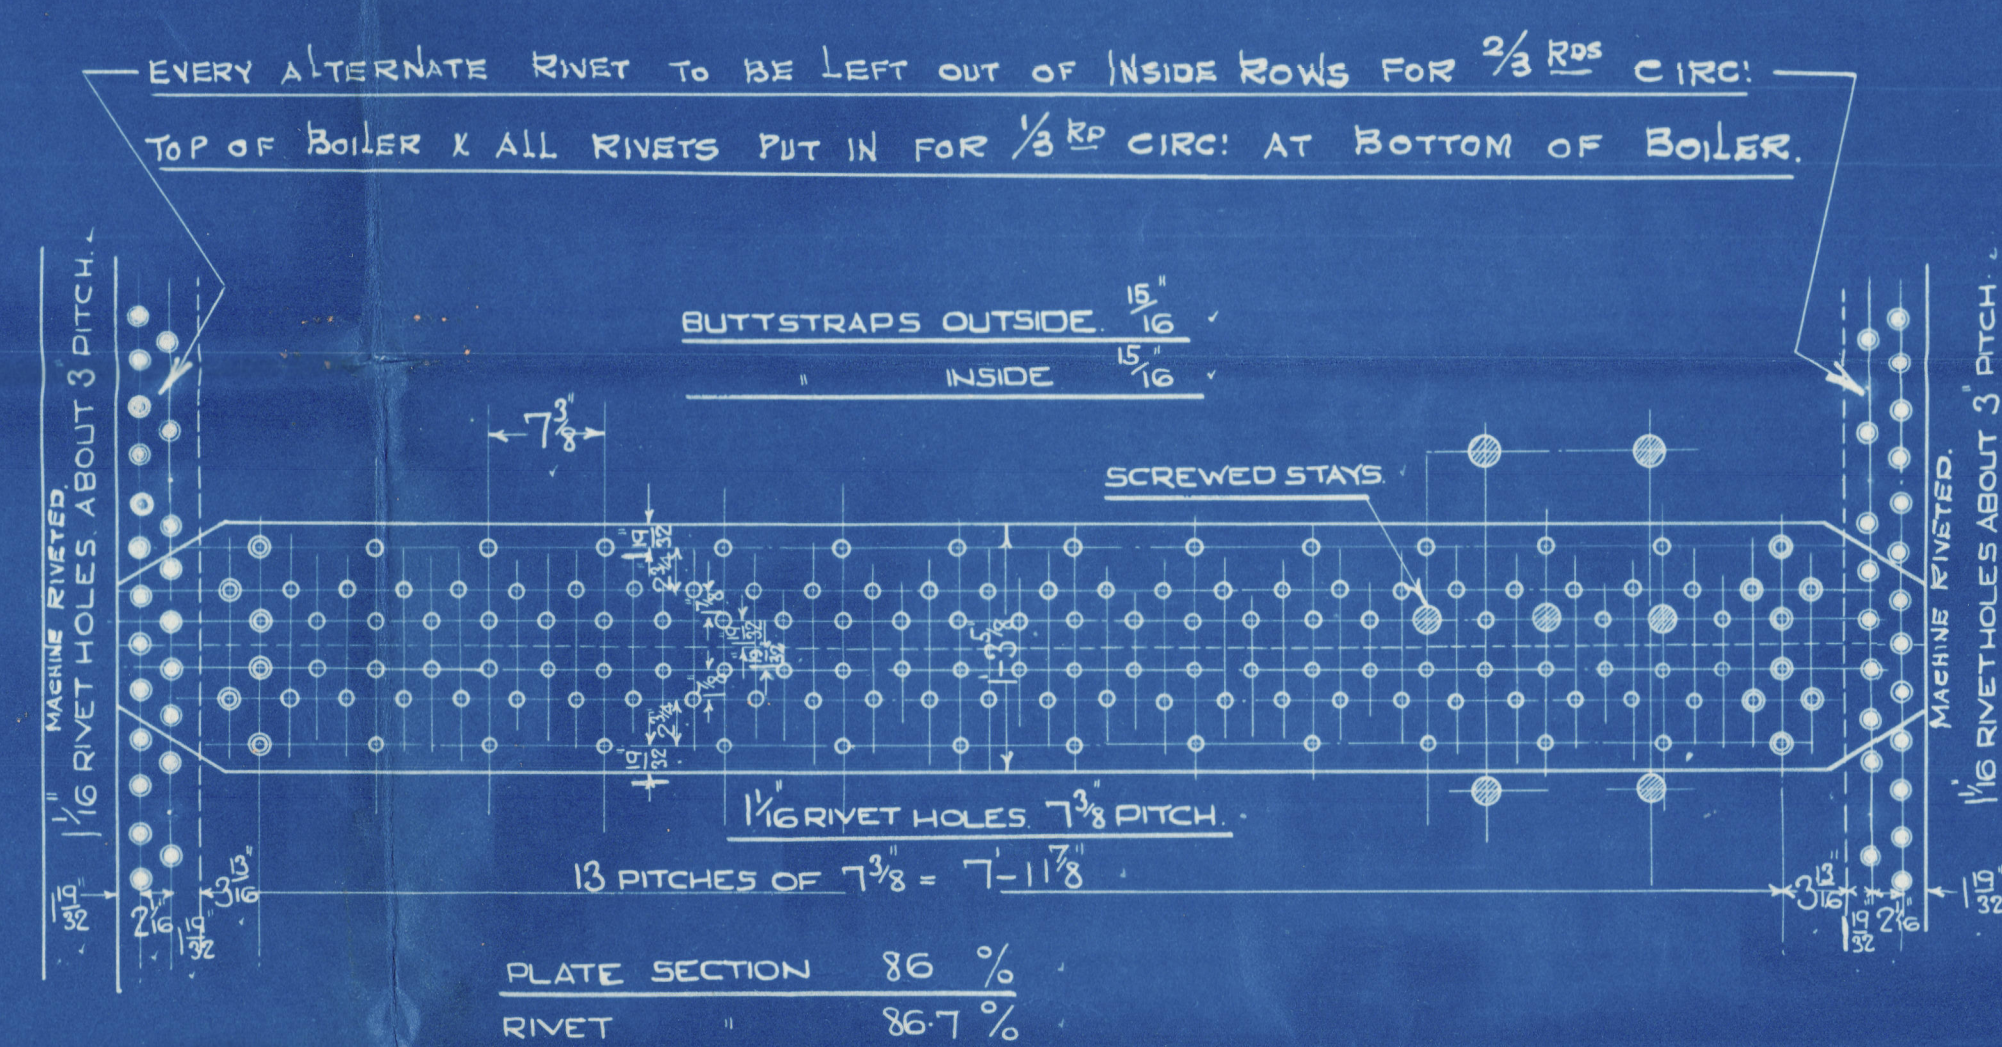
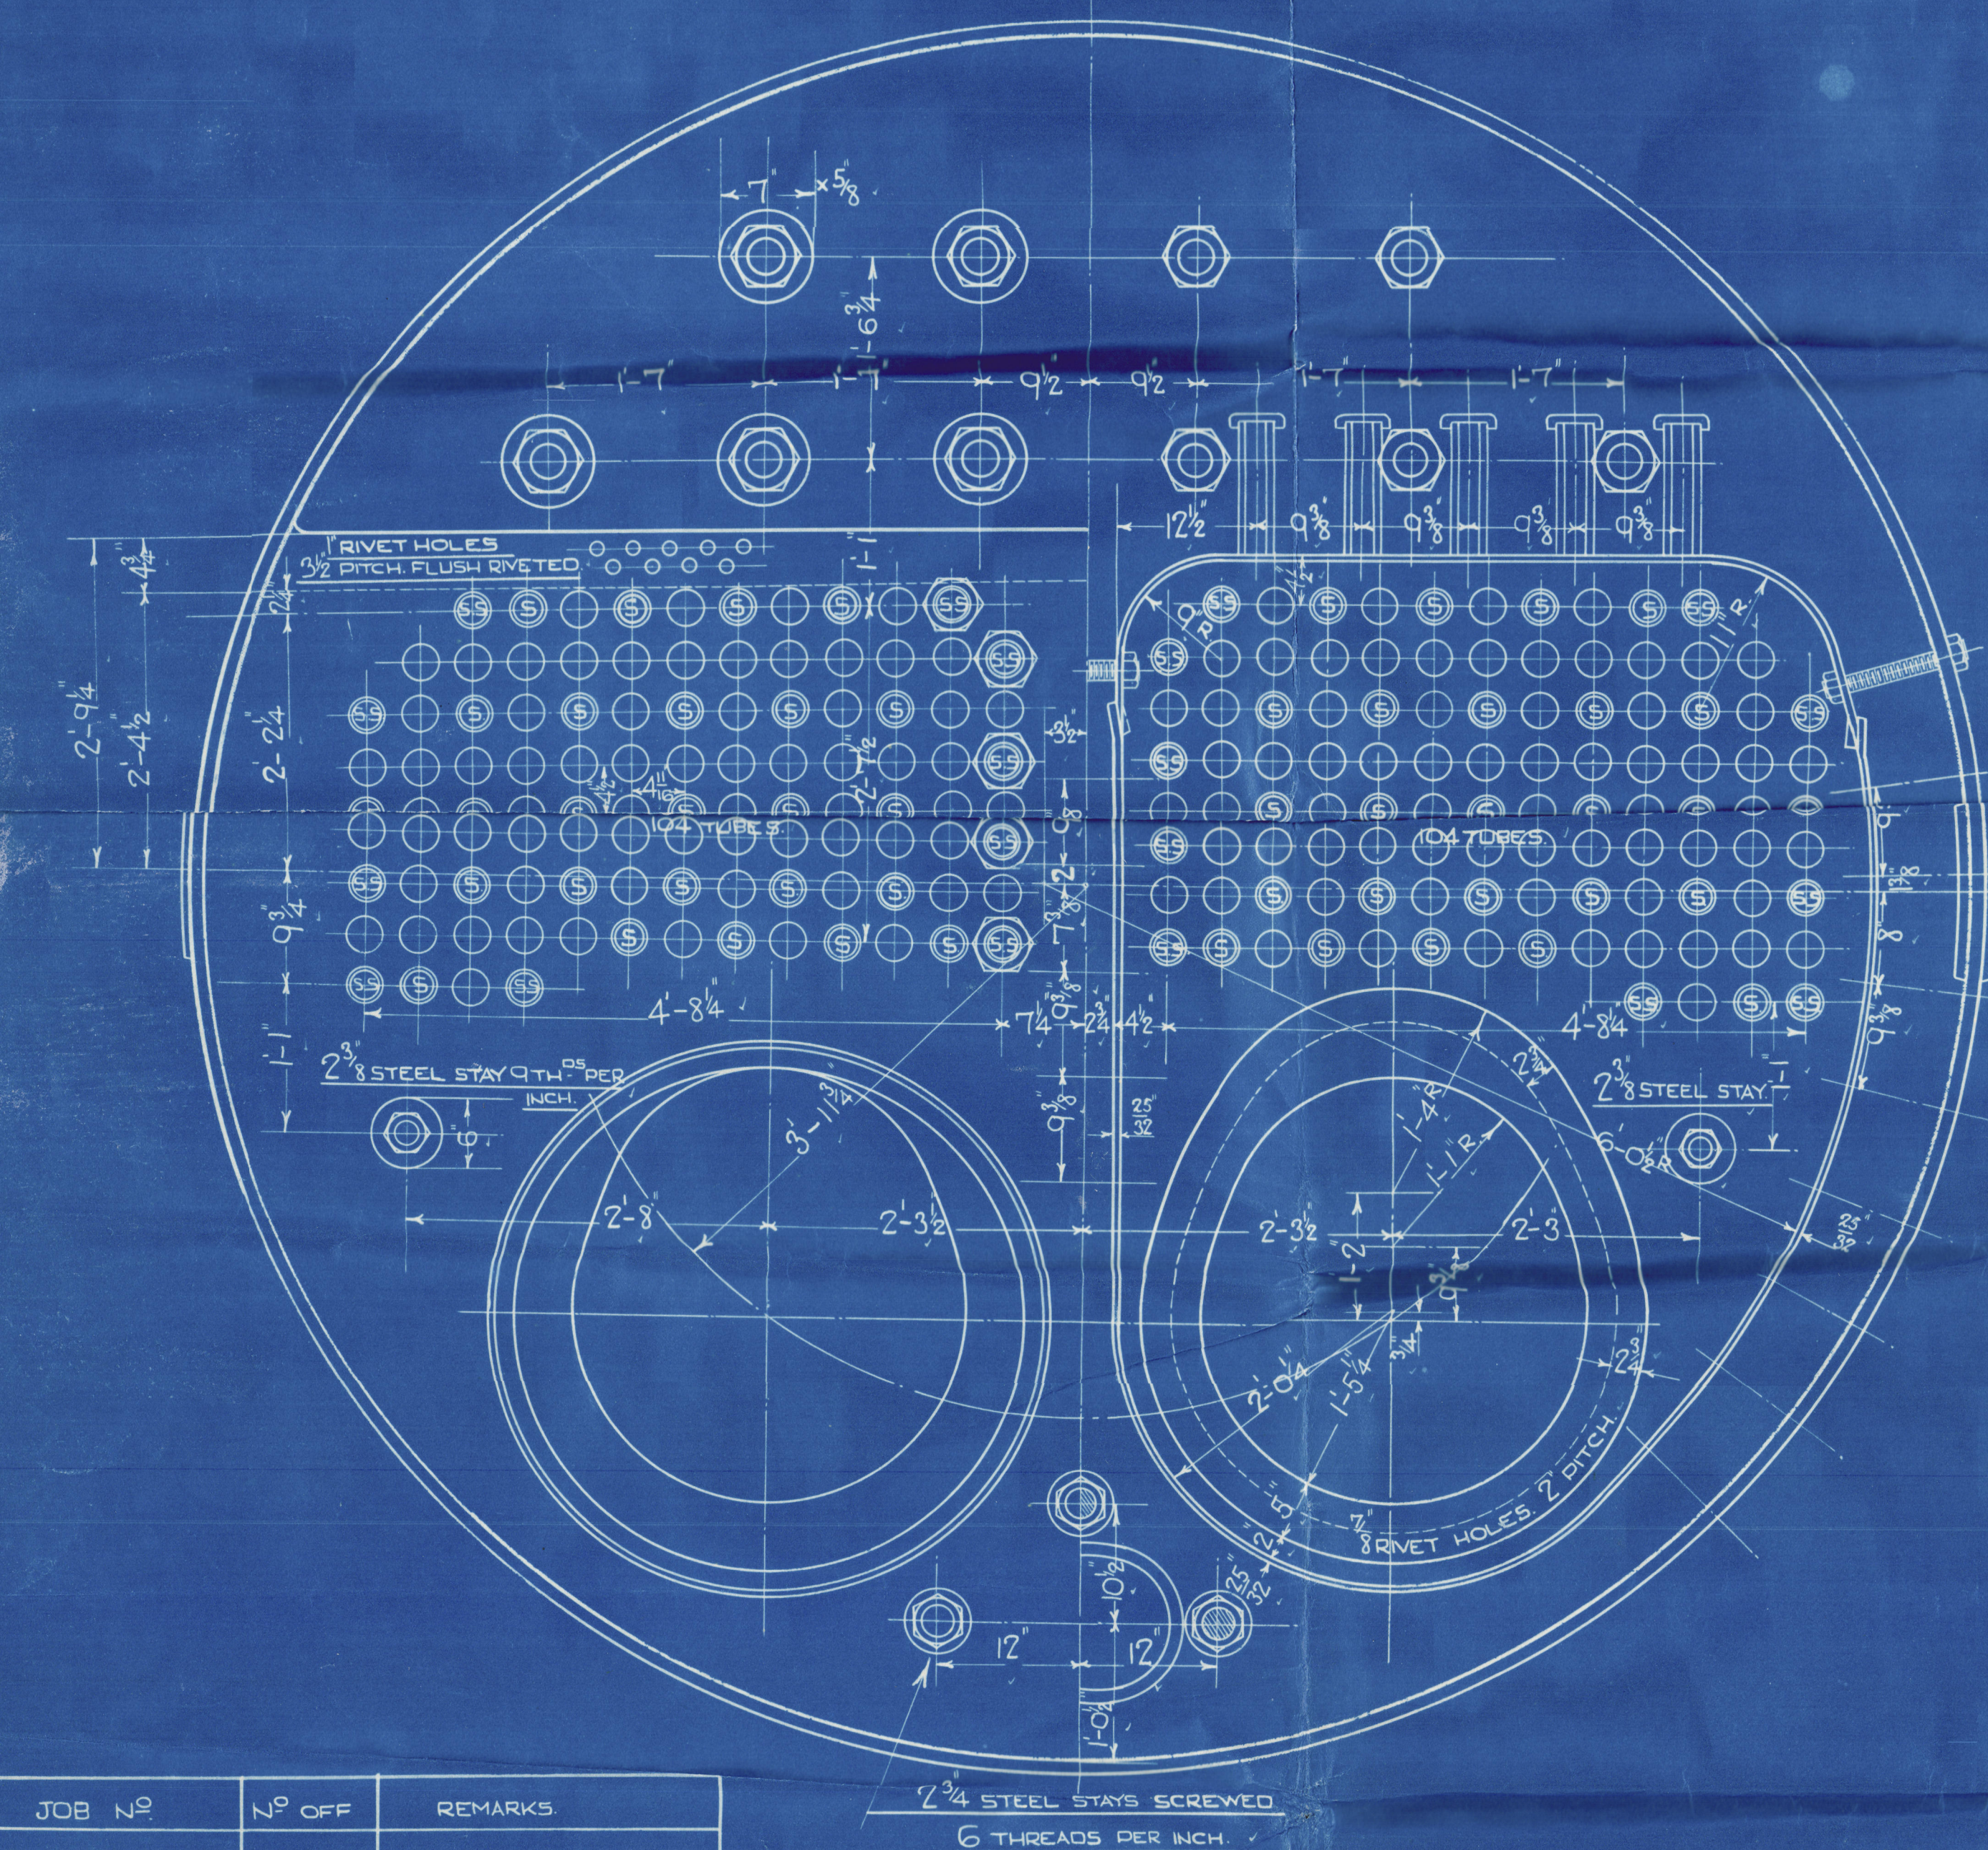


[illegible]

SEE DETAILS FOR POSITION OF MANHOLES
AND LIFTER LUGS.

STAYS MARKED THUS © 2¹/₄" DIA.
SCREWED 9 THOS.
ALL OTHER STAYS 2¹/₄" DIA 9 THOS.
ALL STAYS SCREWED INTO PLATES & FITTED WITH NUTS

NOTE :- MAIN STAYS ARE $3\frac{3}{8}$ " IN EXCESS OF LLOYDS REQU^{TS}
SCREWED " " $1\frac{1}{4}$ " " " " " " " "

BOILER.

SCALE 1" = 1 FOOT.

24134.



J. J. Thorneycroft

Borden for Nos 1000/1

RECEIVED
JAN 10 1891
LLOYD'S REGISTER



© 2021

Lloyd's Register
Foundation

W678-0293

JOHN I. THORNYCROFT & Co., Ltd.,
SOUTHAMPTON.

Enclosures.

Misses Alice & Constance

151

W678-0293 1/2