

# MARINE BOILER

UNDER LLOYD'S SURVEY.


SCALE 1" = 1 FOOT

N<sup>(S)</sup> 755-756



Marine Boilers

755 x 756

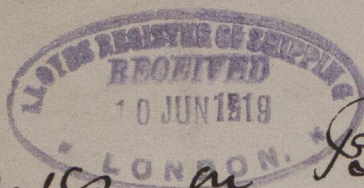


Marine Boilers

BoILER No 756.

No 15049  
LLOYDS TEST  
360 lbs.  
W.P. 180 lbs.  
23.1.20. P.T.B.

Free by Board  
BoILER No 755


No 15089  
LLOYDS TEST  
360 lbs  
W.P. 180 lbs  
10.2.20 P.T.B.

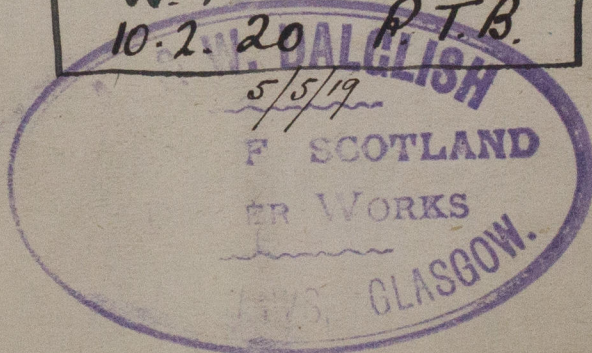

GLASGOW REPORT No. 4034/0

5/5 Beatty Rose

W688-0191

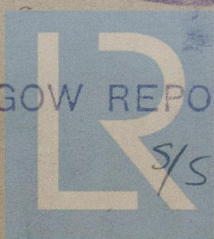

© 2021

Lloyd's Register  
Foundation