
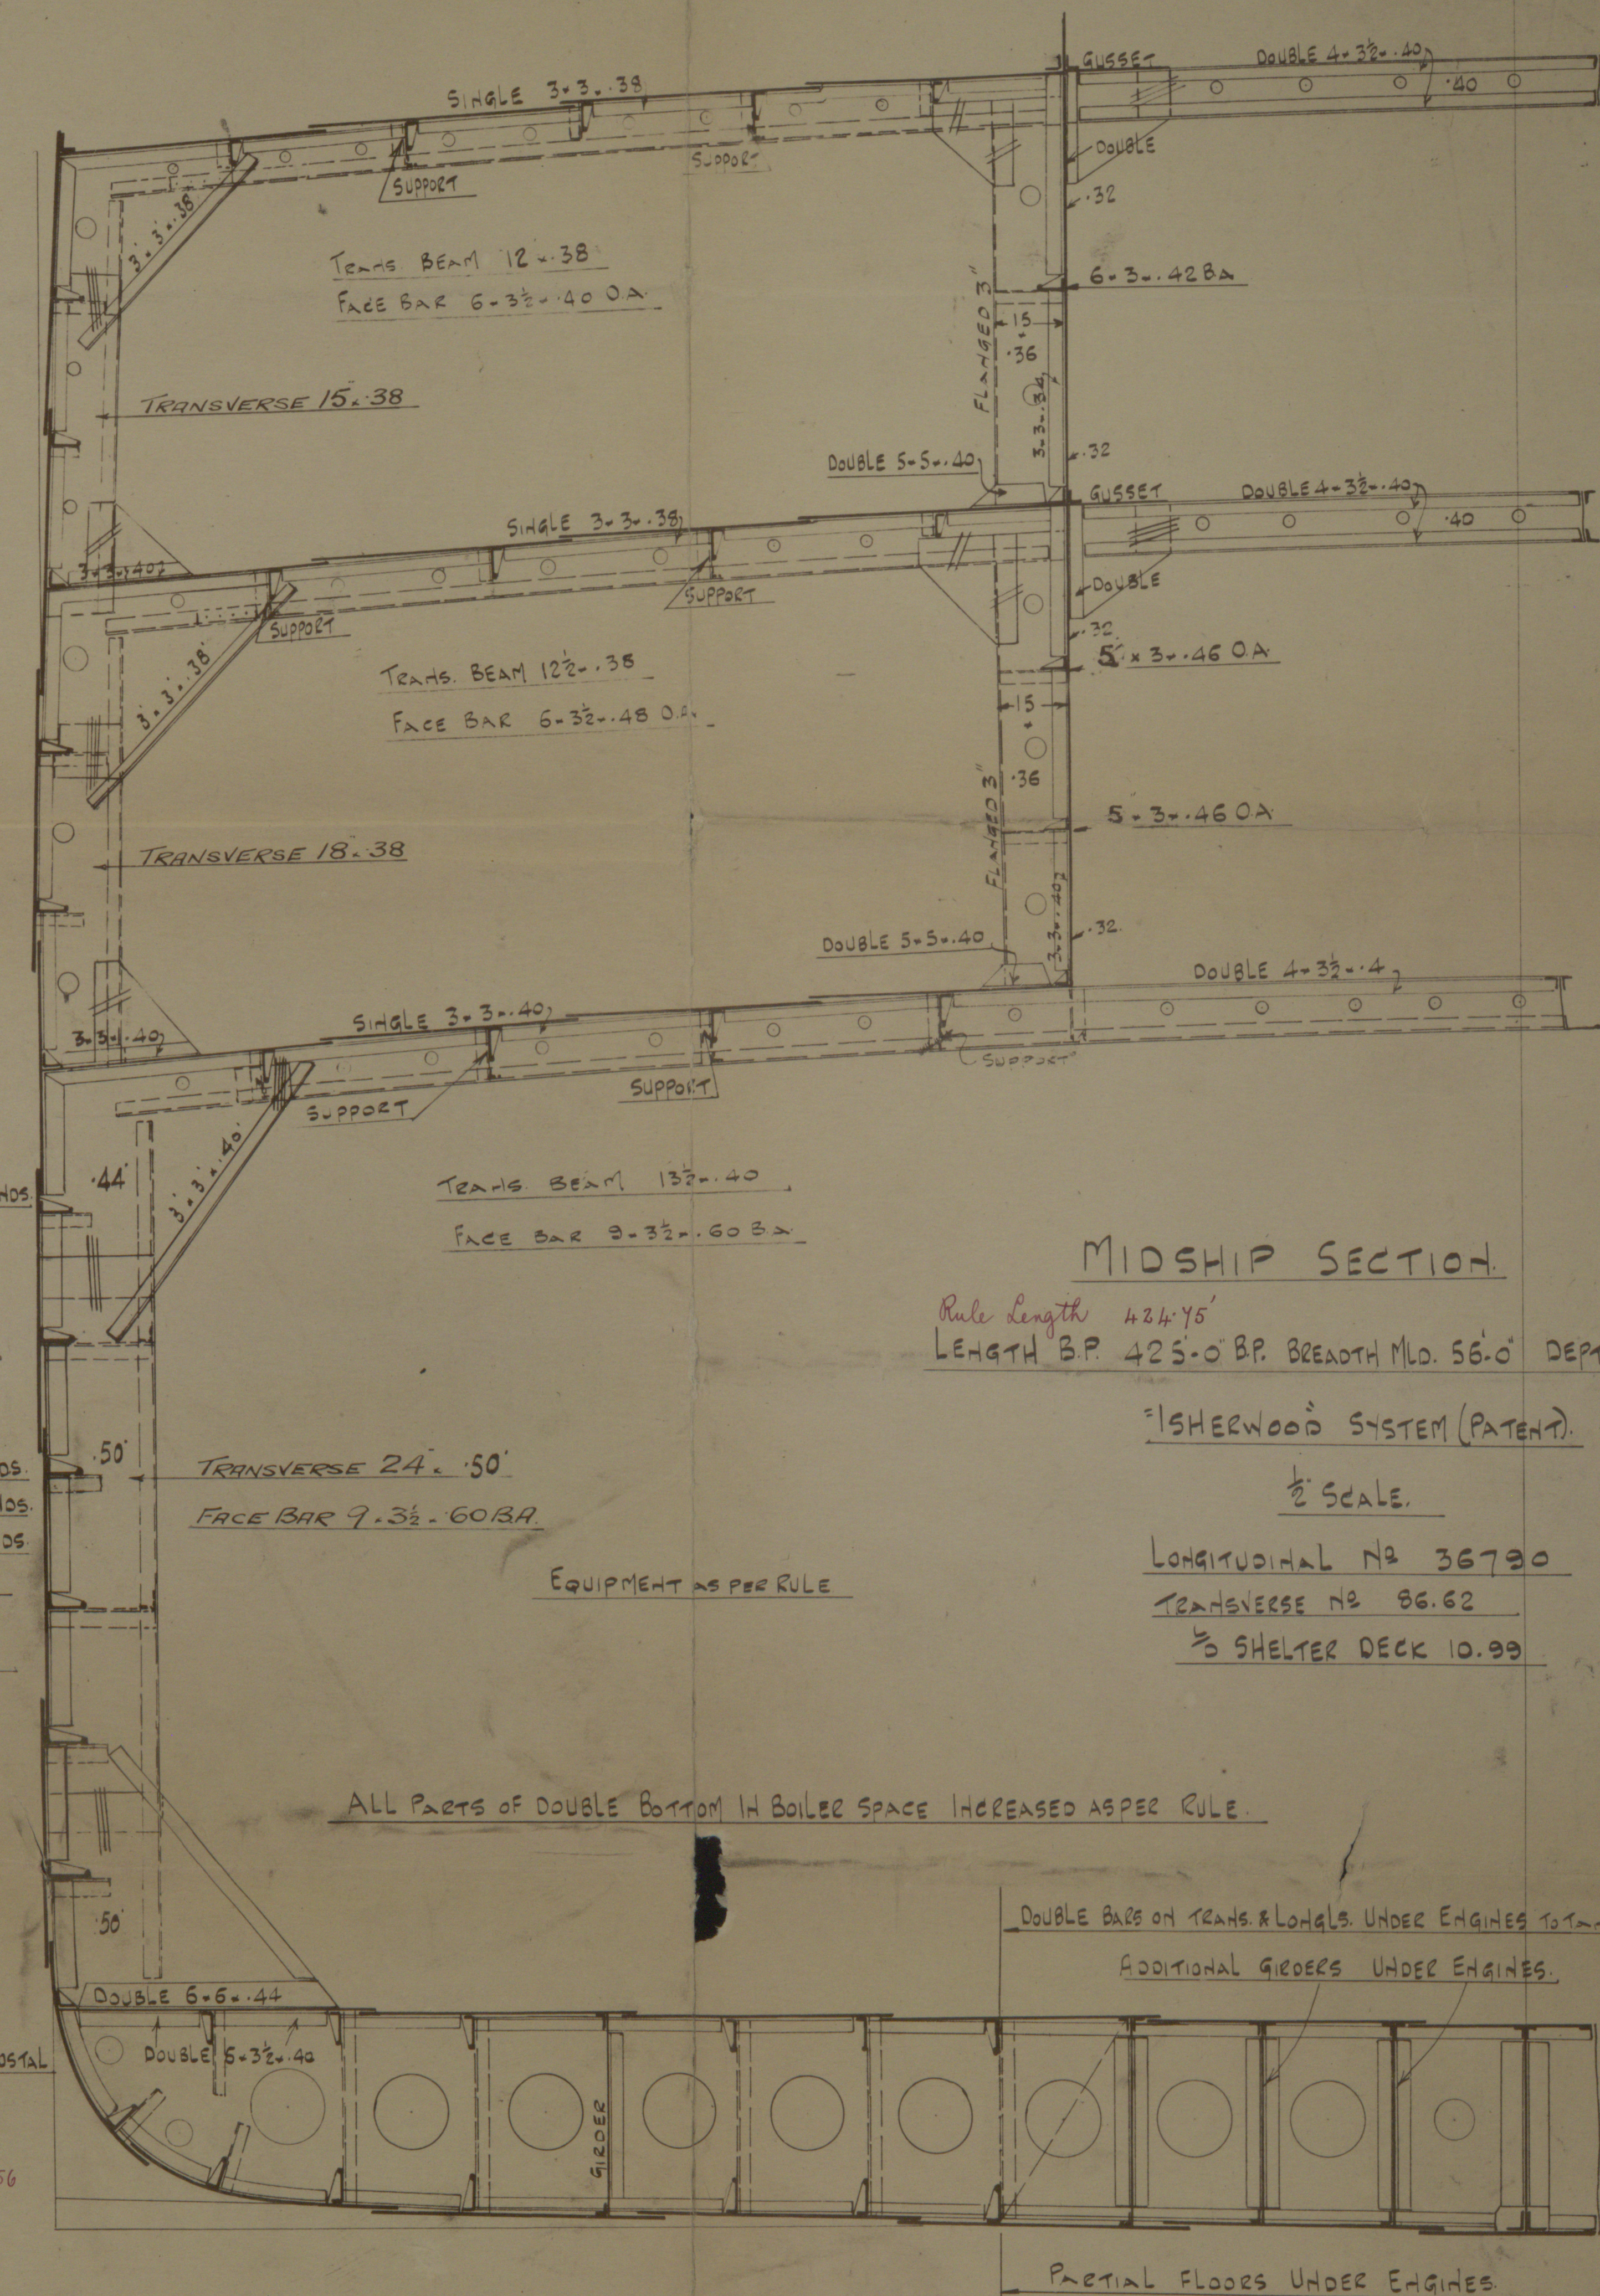


PLATE LISTS AT BOTTOM OF PAGES SPACED 7 INCHES APART

MESSES. SHORT BROS. LTD
SUNDERLAND. No 381.

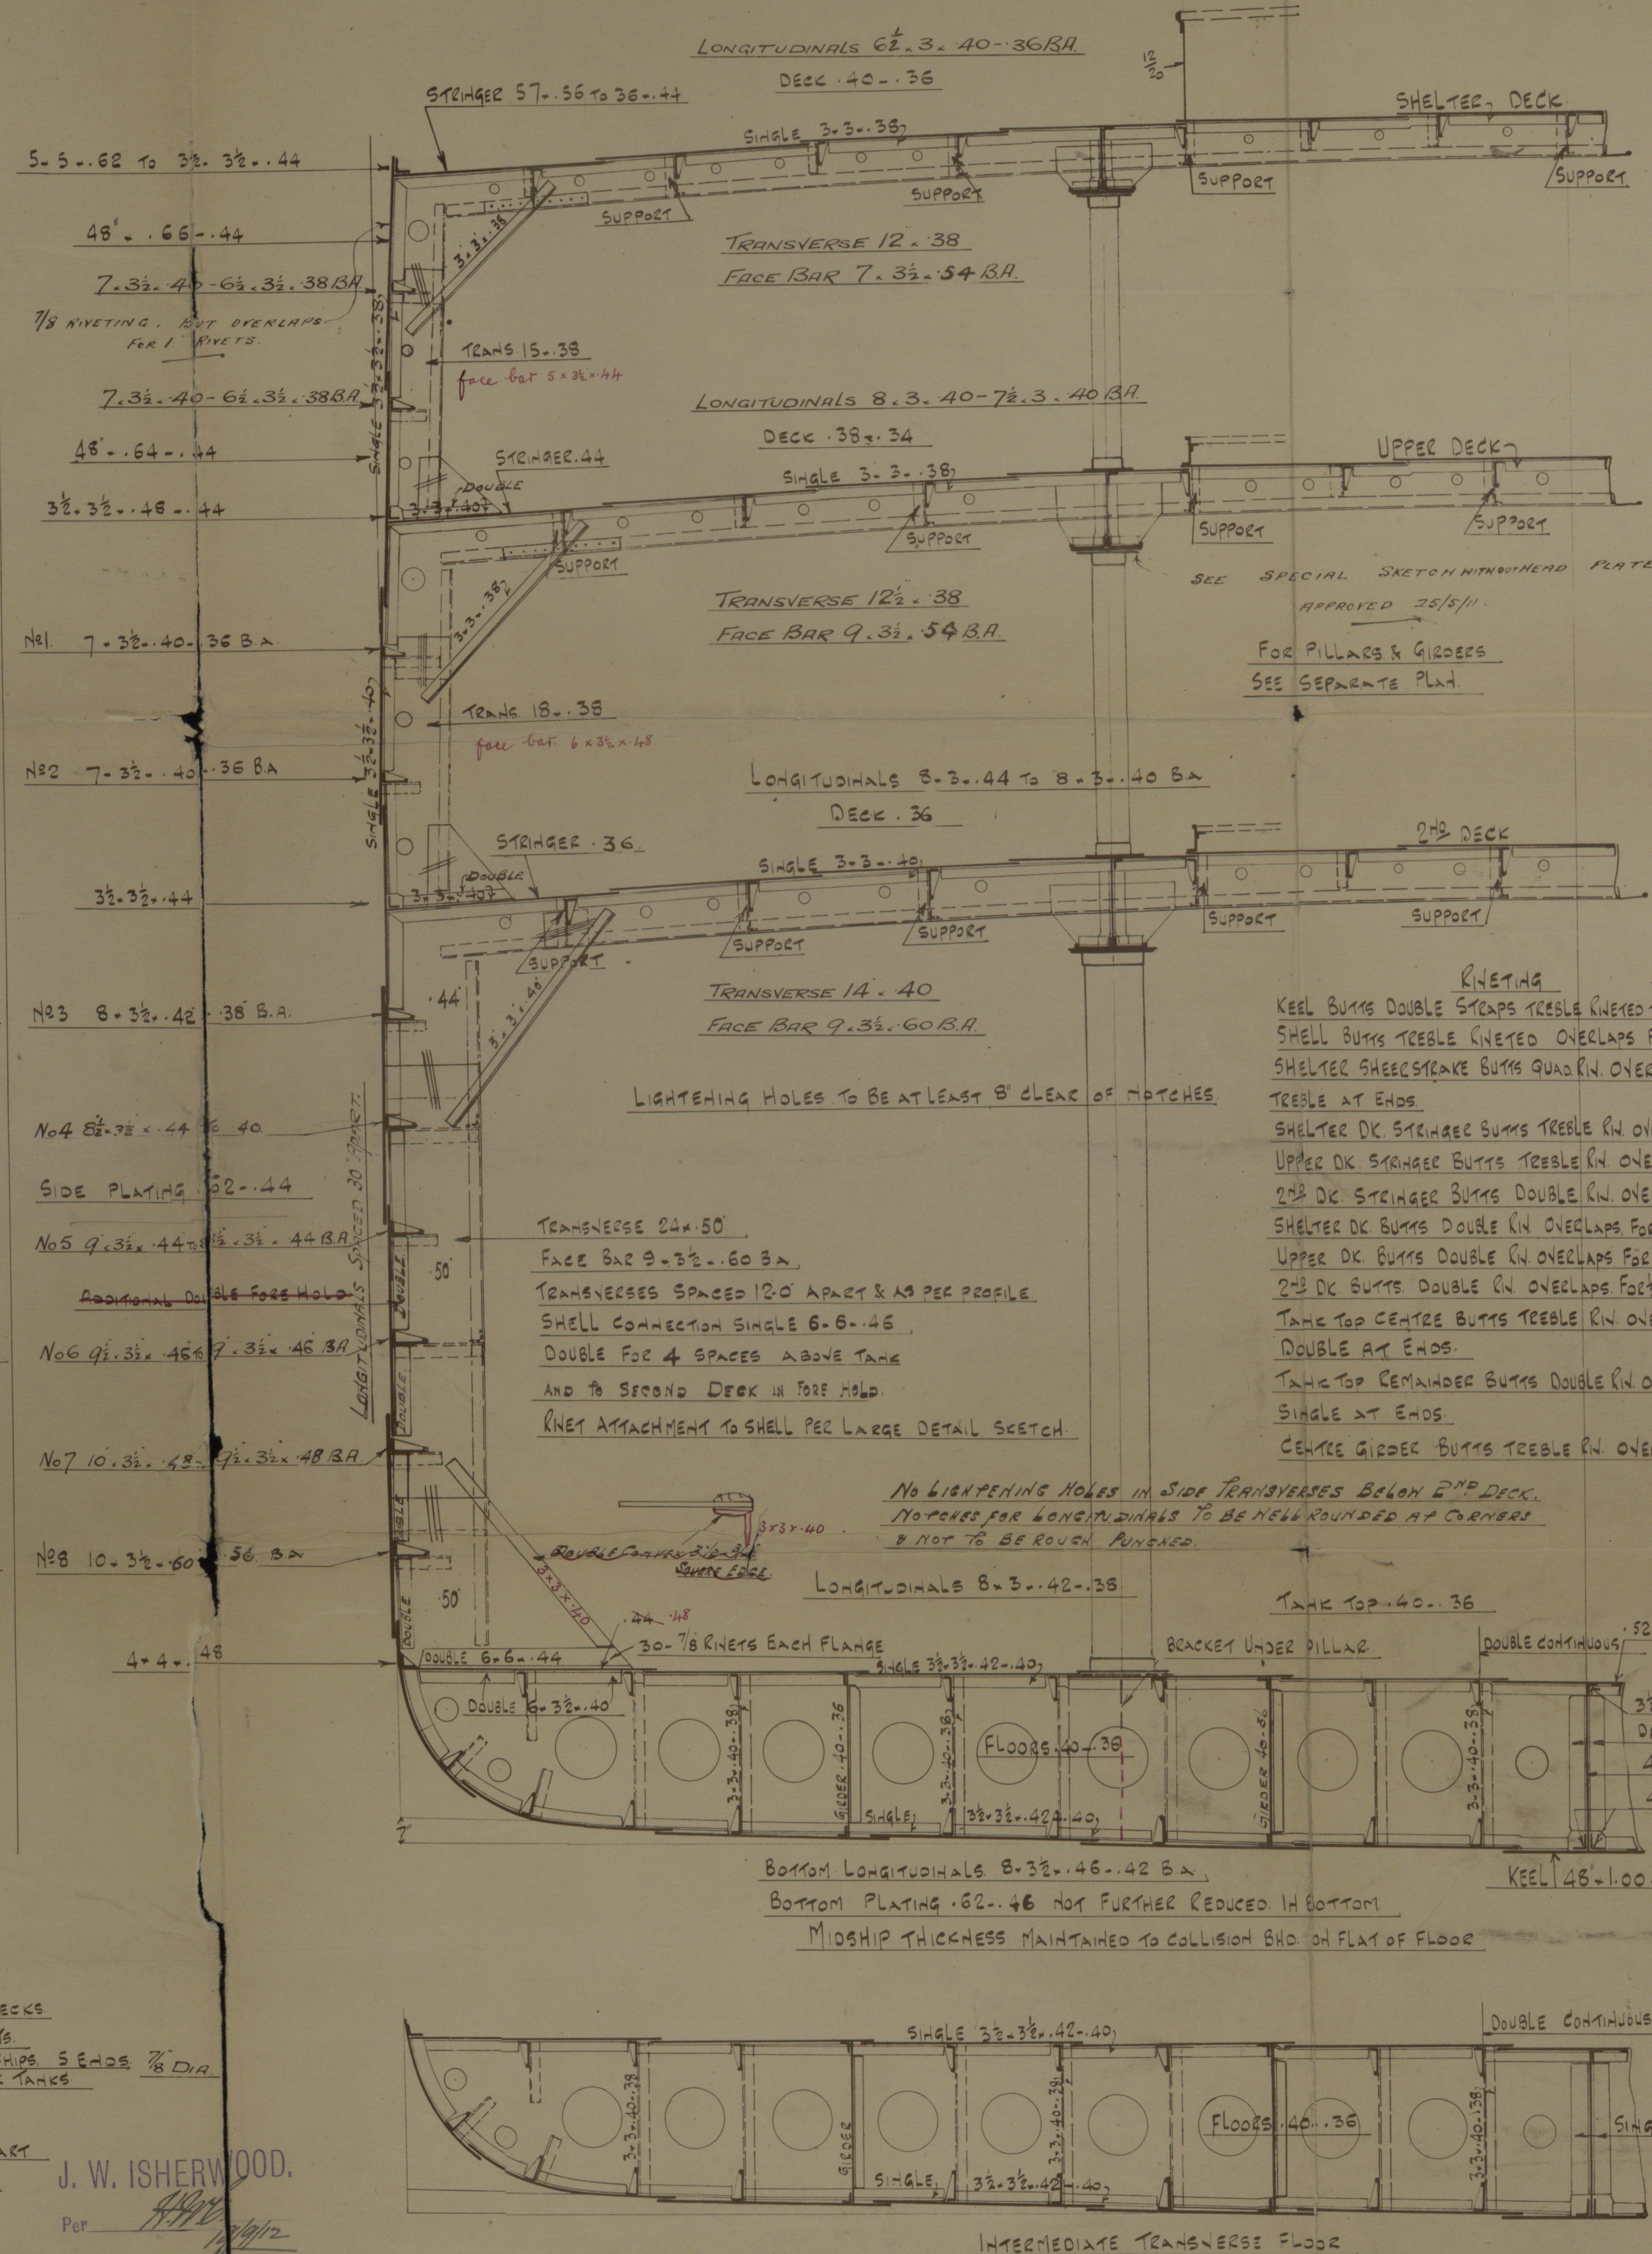

MIDSHIP SECTION.

Rule Length 424.45'
LENGTH B.P. 425'-0" B.P. BREADTH M.L.D. 56'-0" DEPTH M.L.D. 30'-7 1/2"

"SHERWOOD" SYSTEM (PATENT).

1/2" SCALE.

LONGITUDINAL NO 36790


TRANSVERSE NO 86.62

TO SHELTER DECK 10.99

ALL PARTS OF DOUBLE BOTTOM IN BOILER SPACE INCREASED AS PER RULE.

DOUBLE BARS ON TRANS. & LONGLS. UNDER ENGINES TO TAKE TOP.
ADDITIONAL GIRDERS UNDER ENGINES.

PARTIAL FLOORS UNDER ENGINES

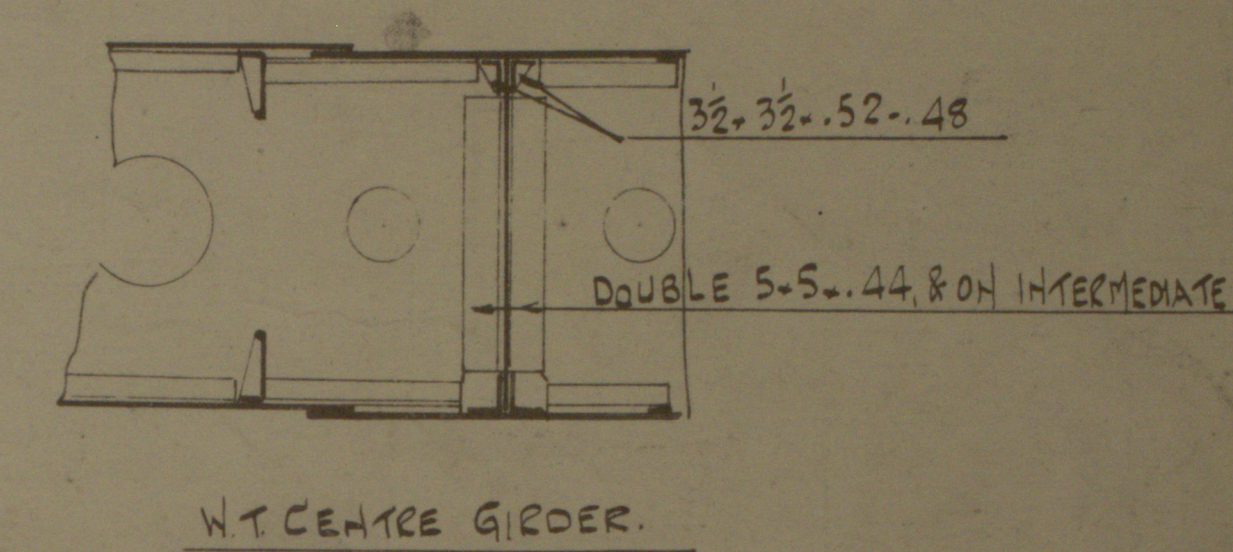

Midship Section

Messrs Short Bros Ltd

No 381



SUNDERLAND

Messrs Short Bros Ltd

MIDSHIP SECTION




No. 381

S.S. ANGLO BRAZILIAN

No. Report No 25933

SEE AMENDED PLAN FOR
SCANTLINGS IN WAY OF BRIDGE

See Plan as Built

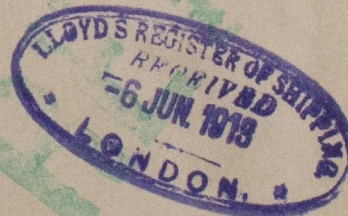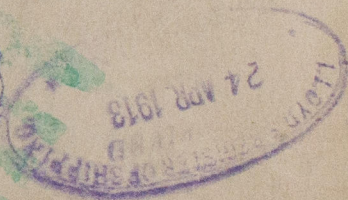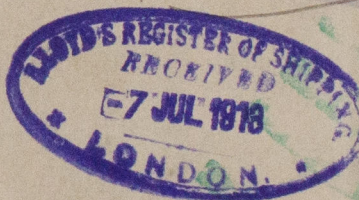

© 2021

Lloyd's Register
Foundation