

to Register E  
 Voyage  
 of Classificati  
 y as in Register  
 FACTER.  
 cial Survey.  
 Survey and of  
 al Surveys.

For the information of Surveyors and the Committee only.  
 Received at \_\_\_\_\_ Office \_\_\_\_\_ 27 APR 1932

# Lloyd's Register of Shipping.

(Report on Vessel No. 88489 Port Newcastle)

## No. F4936 SHIP FORGINGS OR CASTINGS.

I have to report that the undermentioned Iron or Steel Forgings or Castings, manufactured by The Sunderland Forge Co. Ltd. of Sunderland for the Vessel No. \_\_\_\_\_, being built by SS "Walford" of \_\_\_\_\_ have been inspected by me as set forth below and found to be, so far as can be seen, Sound.

be struck out as may be required.


Mark on Forgings or Castings.

Lloyd's  
 No. 6540  
 J.D. 10.4.32

*J. Dale*  
Sunderland  
 12.4.32

	STERN FRAME.	RUDDER FRAME.	STEM.
Material* ...	Scrap iron	/	/
How made ...	Forged & Smithed.		
annealed ...			
Dimensions ...	11 - 9 1/2 x 7 3/4		
Progress on Inspection ...	Forging & Smithing.		
Date when Inspected ...	10.4.32		
CASTINGS.			
Tests on Standard Test Pieces.			
Tensile Test—			
Tons per square inch			
Extension per cent. ...			
Cold Bending Test—			
Angle before fracture			
Drop Test—			
Height from ground ...			
Hammering Test—			
If made according to Rules and found satisfactory ...			

SKETCHES OF FRAMES SHOWING POSITION AND DESCRIPTION OF WELDS OF FORGINGS.

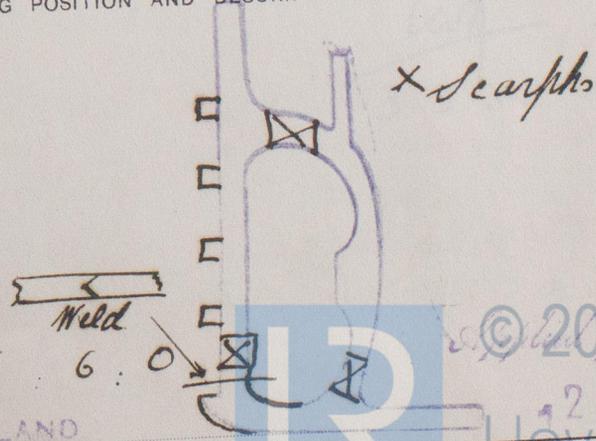

Fee (if any chargeable) £ 6 6 0  
 To be paid at SUNDERLAND

© 2021  
 2 APR 1932  
 Lloyd's Register Foundation

\* If of Iron, state whether scrap or puddled Iron. If of Steel, state whether made on the Open Hearth process.

Engineer Surveyor to

FRI. 6 MAY 1932

2E

489

itee.

1

WORK