

### DETAILED SECTIONS SHOWING CONNECTION

## IRON STEM AND STERN POST TO WOOD KEEL.


— OF —  
COMPOSITE CARGO STEAMER

—THE ABERDEEN LIME COMPANY LTD.

SCALE 1" = ONE FOOT.

—PARTICULARS.

CONNECTION OF WOOD SHEATHING TO FRAMES AND STEEL  
HODDENDS TO BE CARRIED OUT IN ACCORDANCE WITH RULES.  
AND TO THE SATISFACTION OF LLOYDS SURVEYORS.  
ALL OTHER BOLTING AND RIVETING TO BE CARRIED OUT TO  
THE SURVEYORS SATISFACTION.

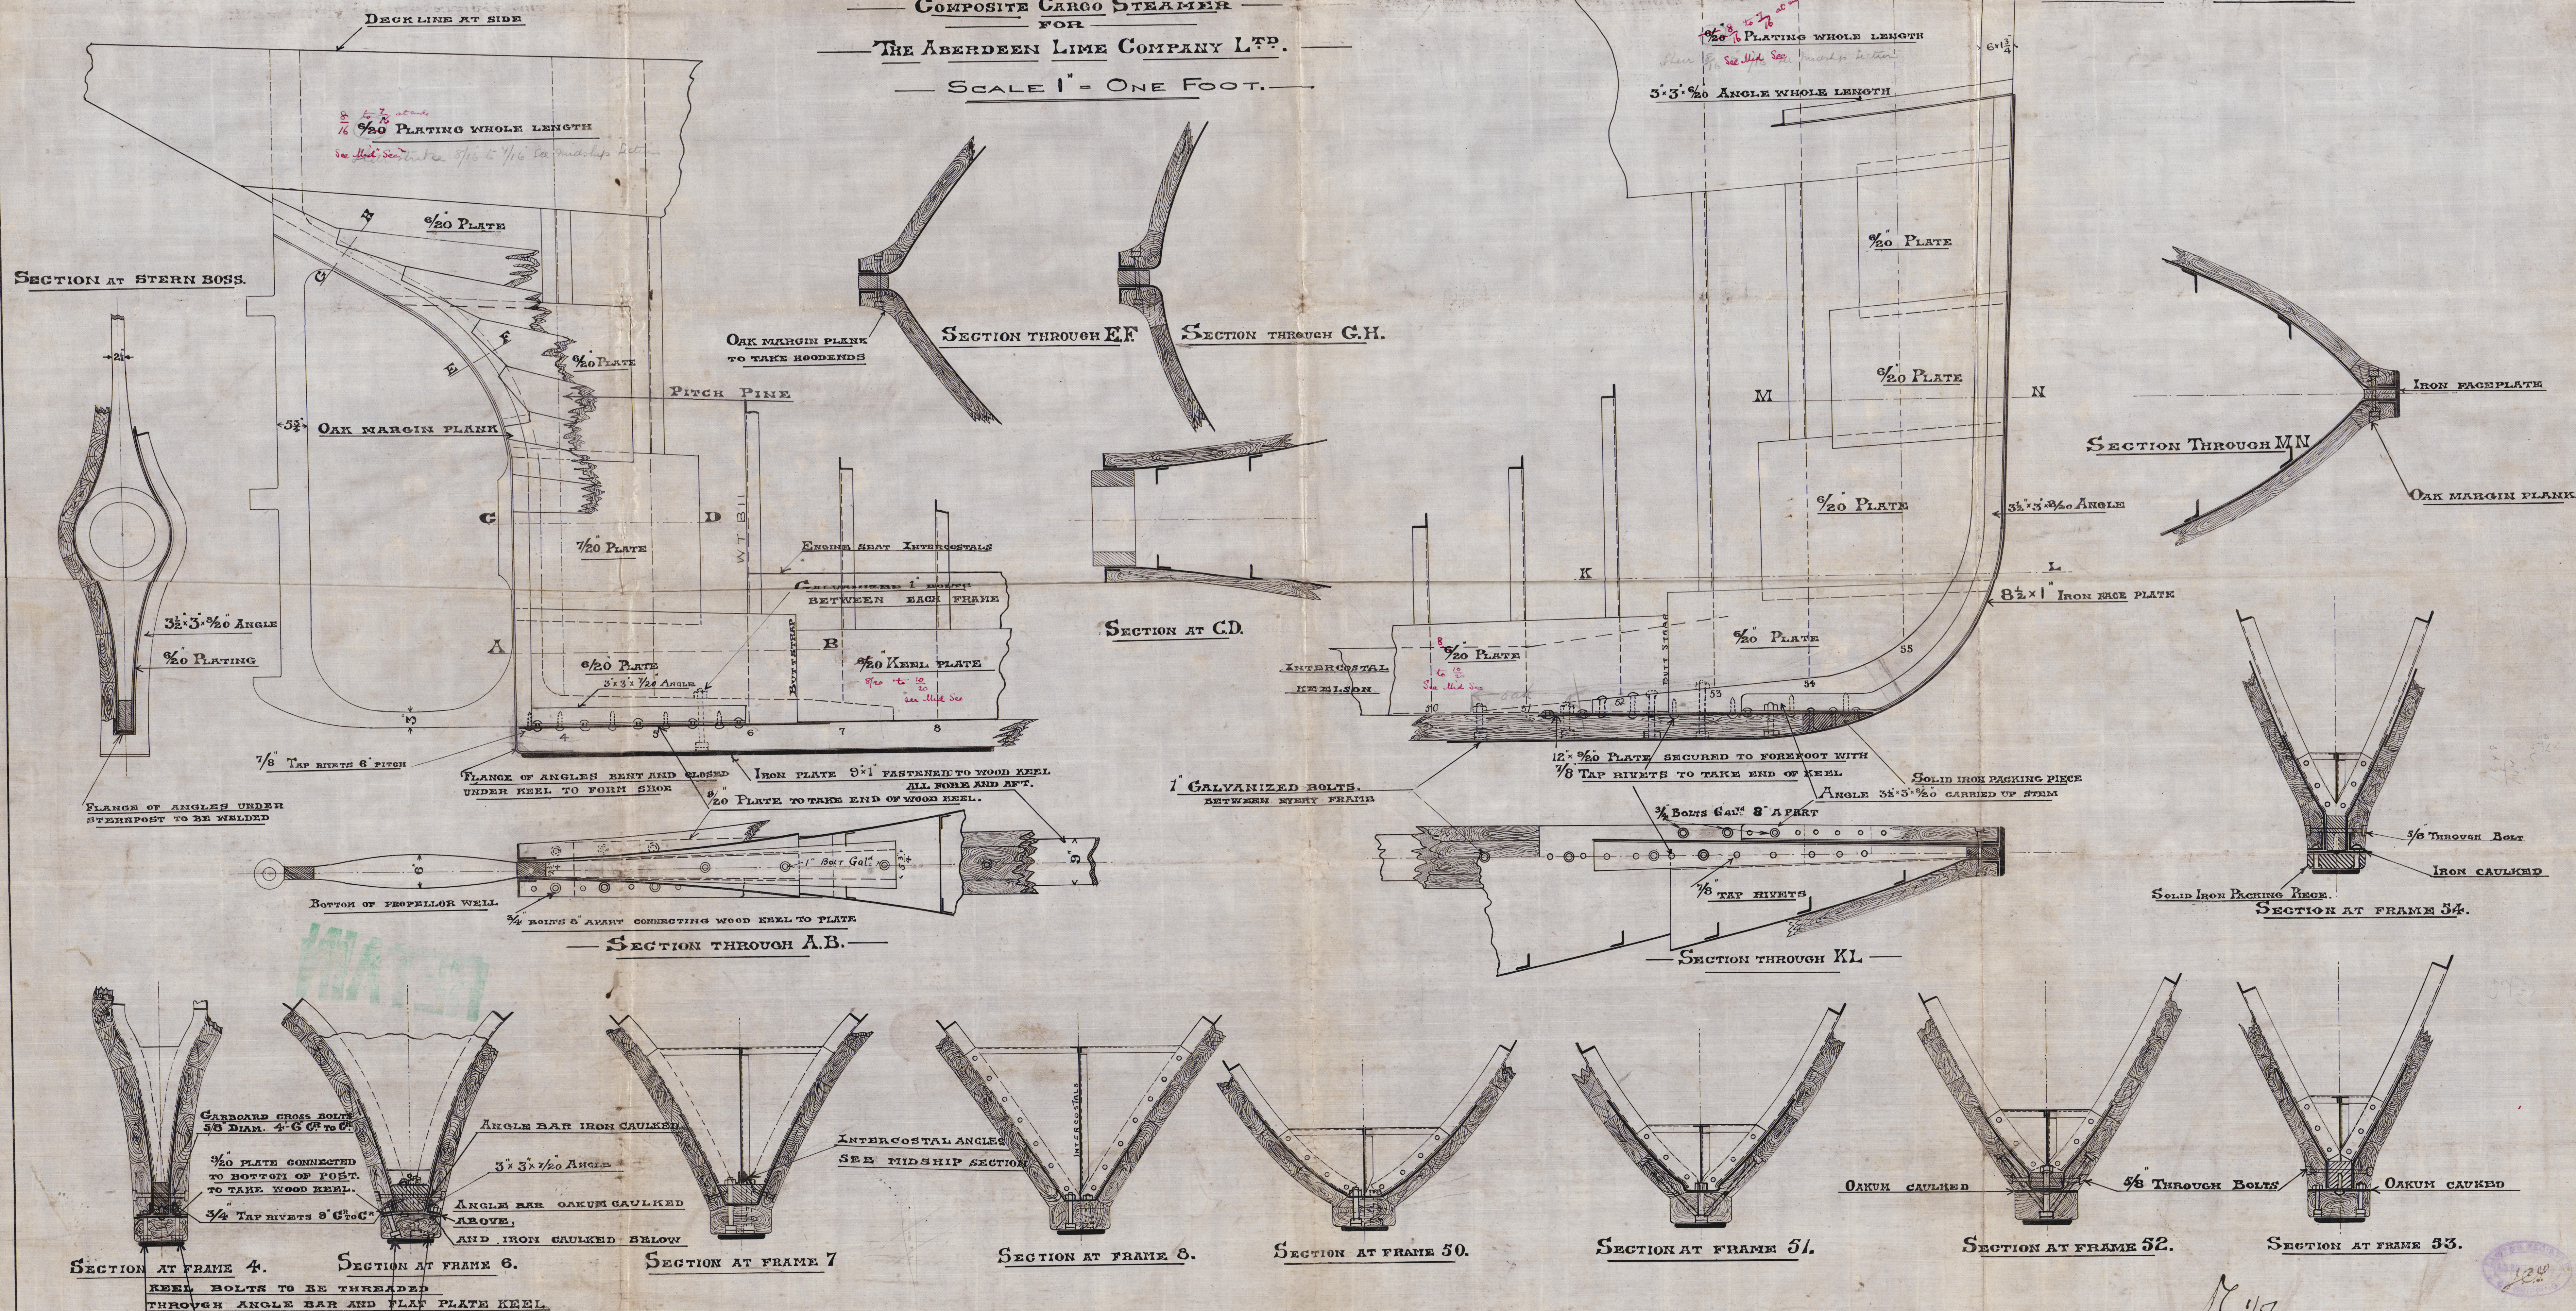

B. 1/50



The Aberdeen Line Co.

Revised Composite vessel

Sections through Stem  
& Stem frame.

Dunda S.B. Coys S.S. No. 196  
S.S. PORTLETHEN

Dunda Report No. 7331

