

CRANK SHAFT FOR YARD N° 561

**8 CYLINDER 4 S.C.S.A. DIESEL ENGINE**


CYL. DIAM. 630 M/M - STROKE 1300 M/M

THIS DRAWING AND THE DESIGN SHOWN  
THEREIN, IS THE PROPERTY  
OF BURMEISTER & WAIN LIMITED, AND  
IS ONLY ALLOWED TO BE USED BY  
EXPRESS PERMISSION AND LICENSE FROM  
BURMEISTER & WAIN LIMITED  
COPENHAGEN

AKTIESELSKABET  
BURMEISTER & WAIN'S MASIN- OG SKIBSBYGGERI


Oct. 18 - 12 - 1928  
J. S. Folger



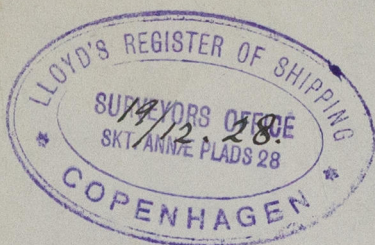

Plan of  
CRANK SHAFT 8 Cyl.  
for 4 S.C.S.A. MAIN Diesel Oil Engines  
for the Twin Screw Motor Vessel  
Yard N<sup>o</sup> 561  
being built by  
**AKTIESELSKABET**  
**BURMEISTER & WAIN'S MASKIN- OG SKIBSBYGGERI**  
Copenhagen.

M/S "PACIFIC RANGER" of London  
Copenhagen Report N<sup>o</sup> 8079.

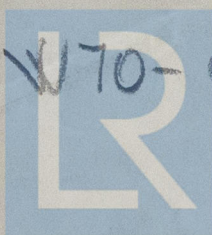

© 2019  
0044

Lloyd's Register  
Foundation