


S.S. "GREBE" (YARD No. 397)

PROFILE AND DECK PLAN

SCALE 1/8" = 1 FOOT

DIMENSIONS:- 220'-0" B.P. x 35'-0" B.M.L.D. x 14'-0" D.M.L.D. TO LOWER DECK, 21'-6" TO UPPER DECK

CLASSED LLOYD'S 100 A.I. 1924-5 RULES

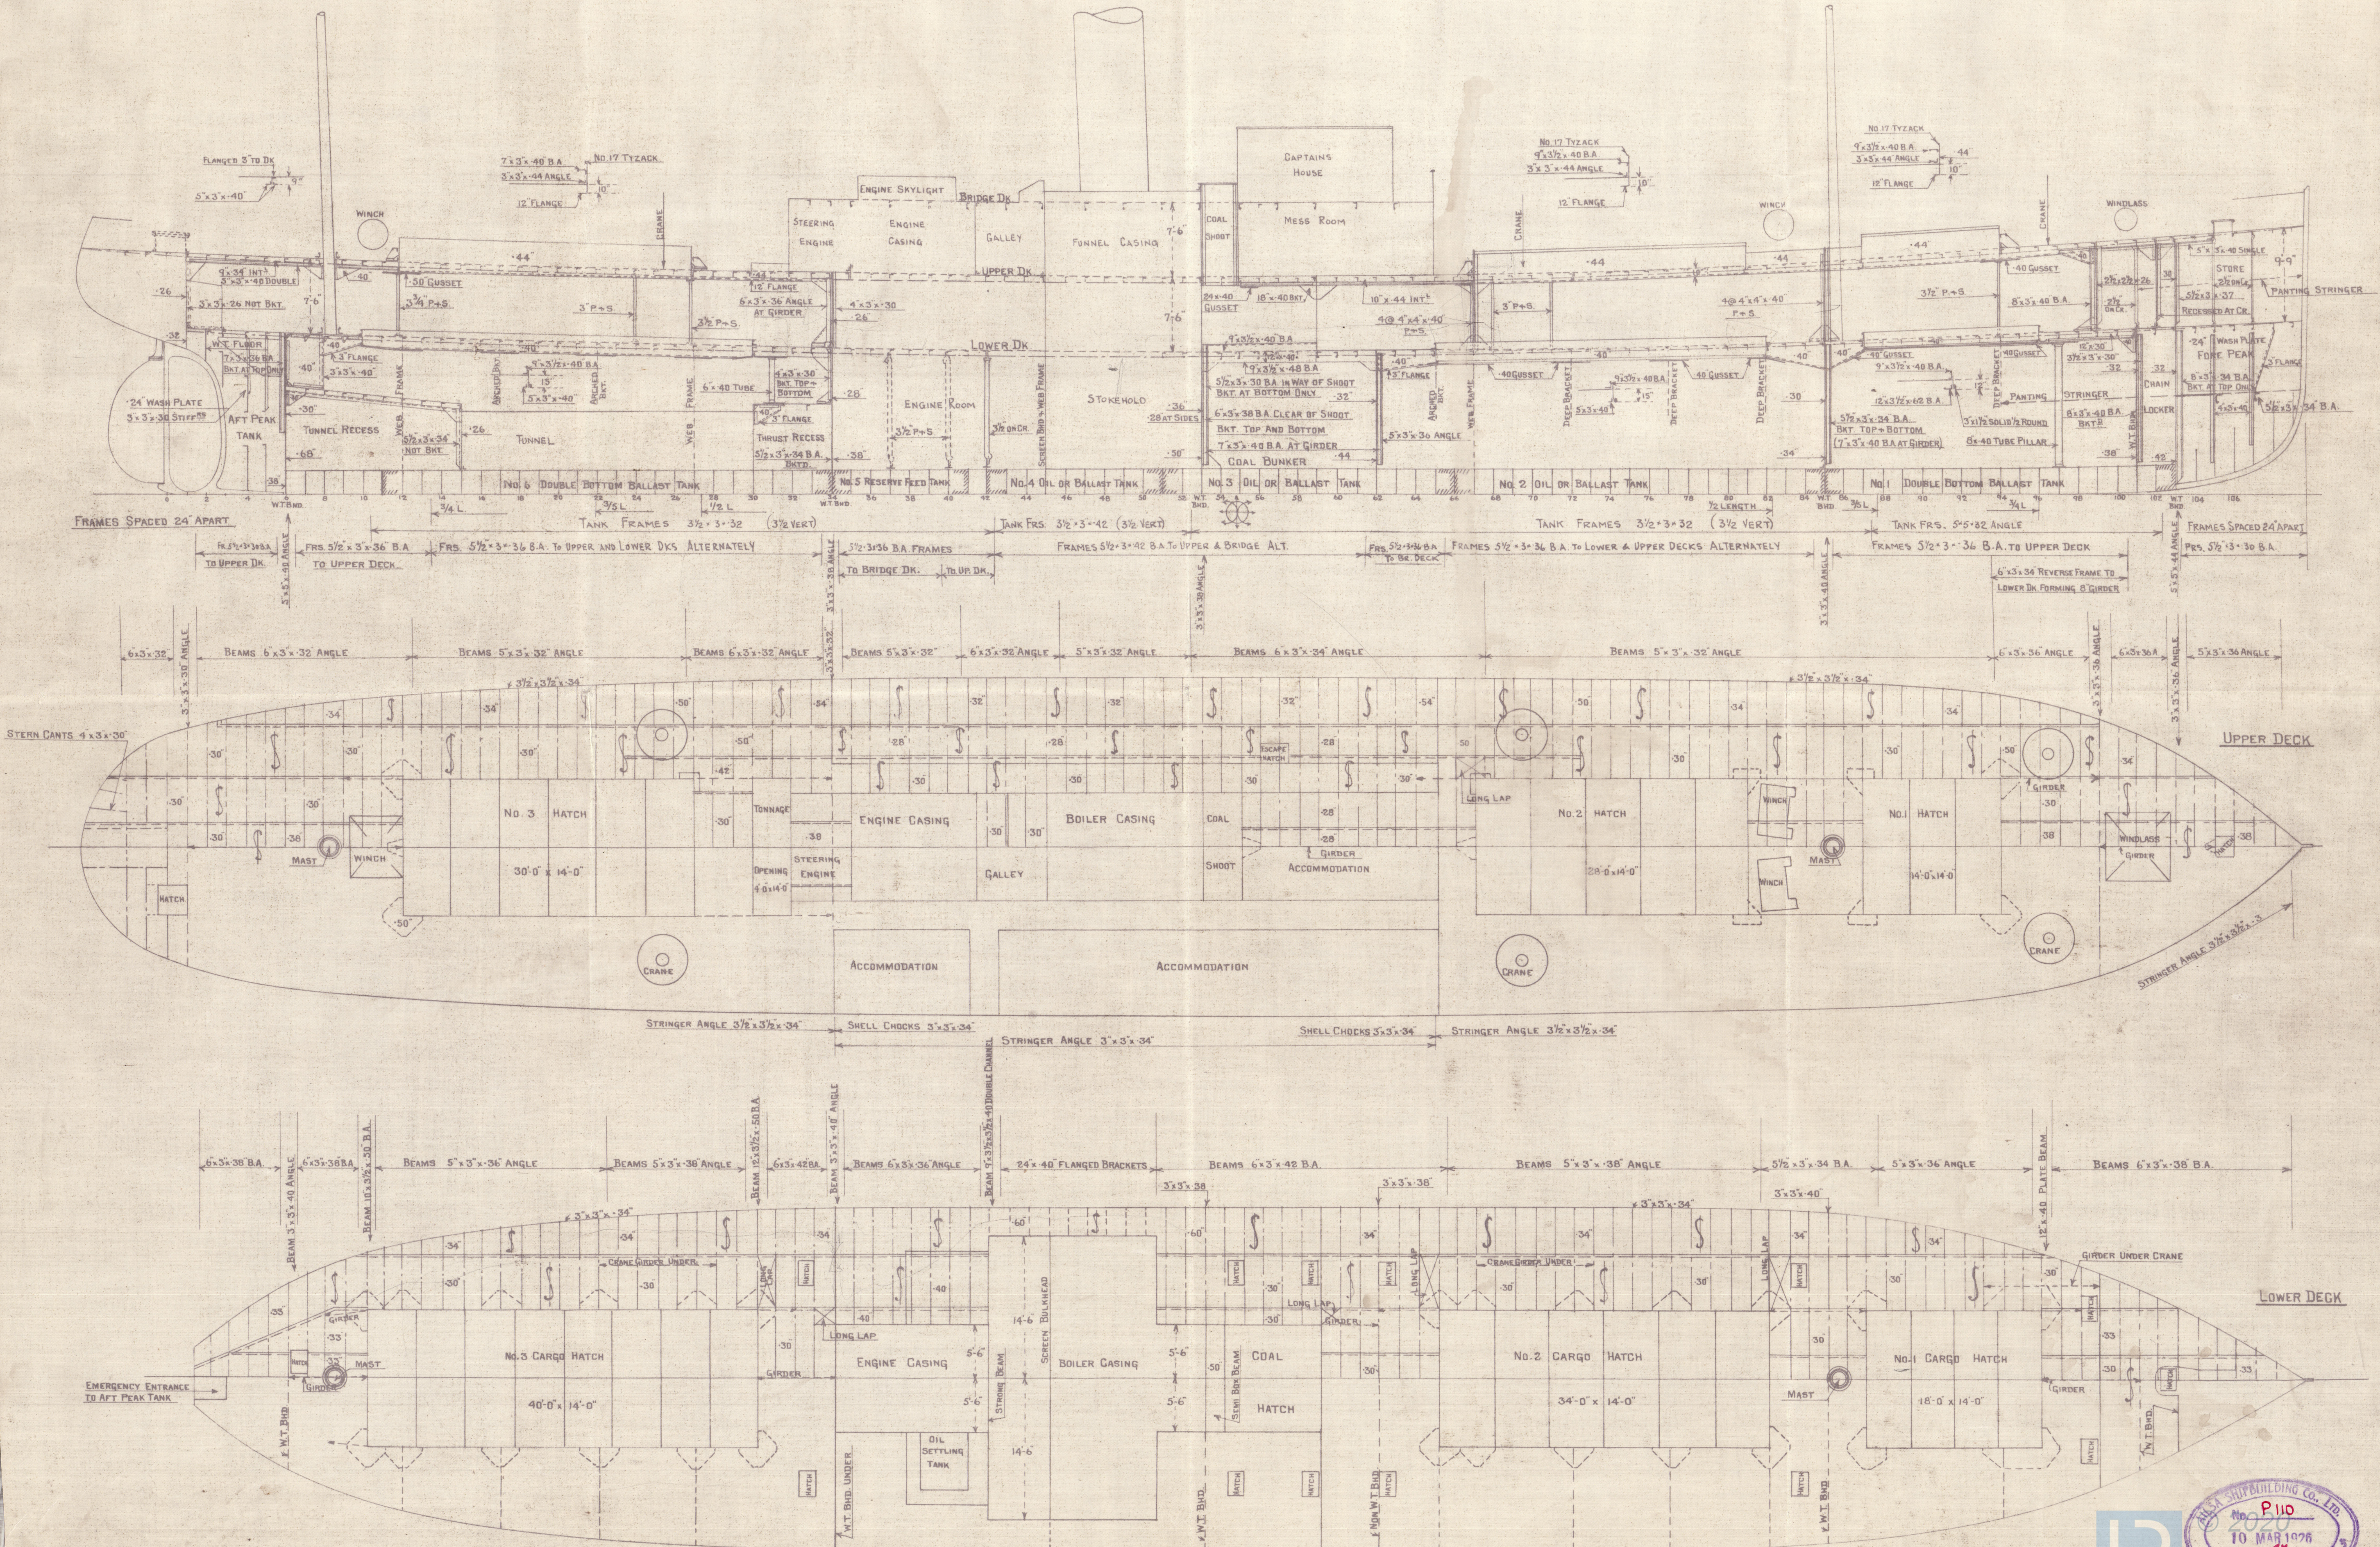

S.S. "GREBE."

(Ailsa S.B. Co's No 397).

Profile and Deck Plan (as built).

GLASGOW REPORT No 45481

W70- 0193



© 2020

Lloyd's Register
Foundation