

TRACING 8049

ALL STAYS SCREWED INTO PLATE & FITTED © 2020
WITH NUTS

CONTRACT Nº 535

535

Lloyd's Register
Foundation


SUNDERLAND

W. DOXFORD & SONS L^d

(3) BOILERS NO 535

W.P. = 180 LBS

F" TYPE

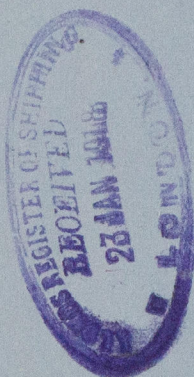

No. 3553
LLOYD'S TEST
360 lbs.
GAH 1.4.19

Port
Bly


No. 3554
LLOYD'S TEST
360 lbs.
GAH 8.4.19

Star
Bly

No. 3556
LLOYD'S TEST
360 lbs.
EWR 15.4.19

Ambr
Bly

RETAIN

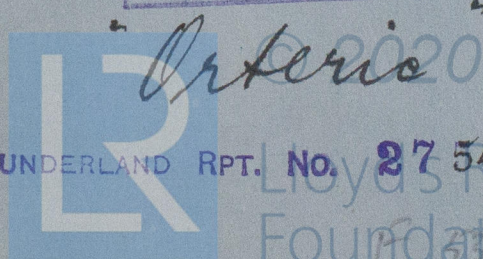

SUNDERLAND RPT. No. 27 544
Lloyd's Register
Foundation