
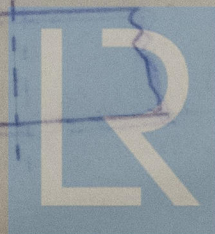
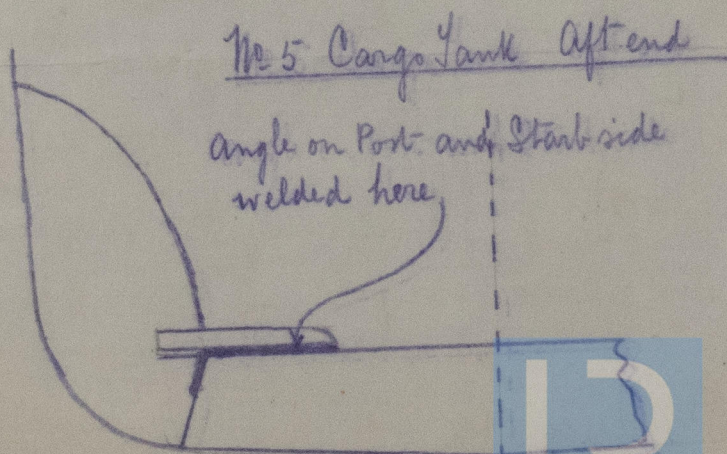
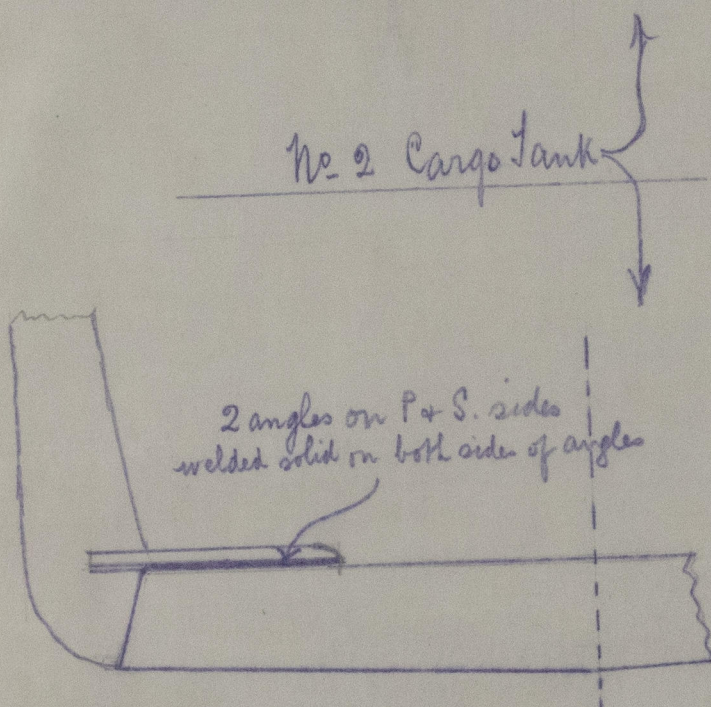
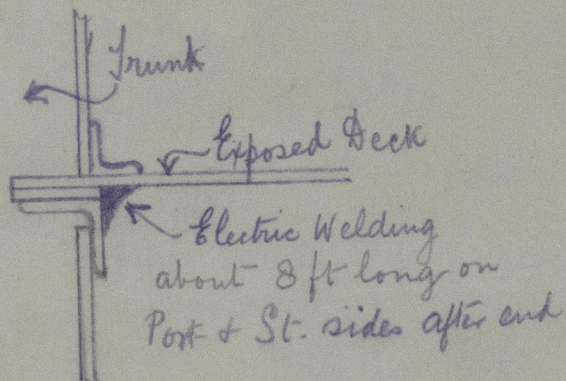


S. S. Boylet Report No 135. Rouen
Sketches showing position of E. weldings in Cargo Tanks

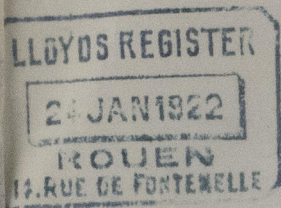

© 2020

Lloyd's Register
Foundation