



— Scale: $1/8'' = 1'$. —

14/9/05 R8

Girders at heads of pillars
of intercostal plate + single chan
 $7\frac{1}{8} \times 2\frac{1}{4} \times 2\frac{1}{4} = \frac{97}{32} \times \frac{66}{32}$

 

No 4

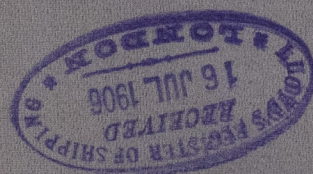

© 2020

Lloyd's Register
Foundation



Longitudinal
Section.

S.S. VORWÄRTS

RETAIN



© 2020

W711-Lloyd's Register
Foundation