





11:30 AM
11:30 AM

LONG SEAMS DOUBLE BUTT STRAPS
18 HOLES 6" PITCH

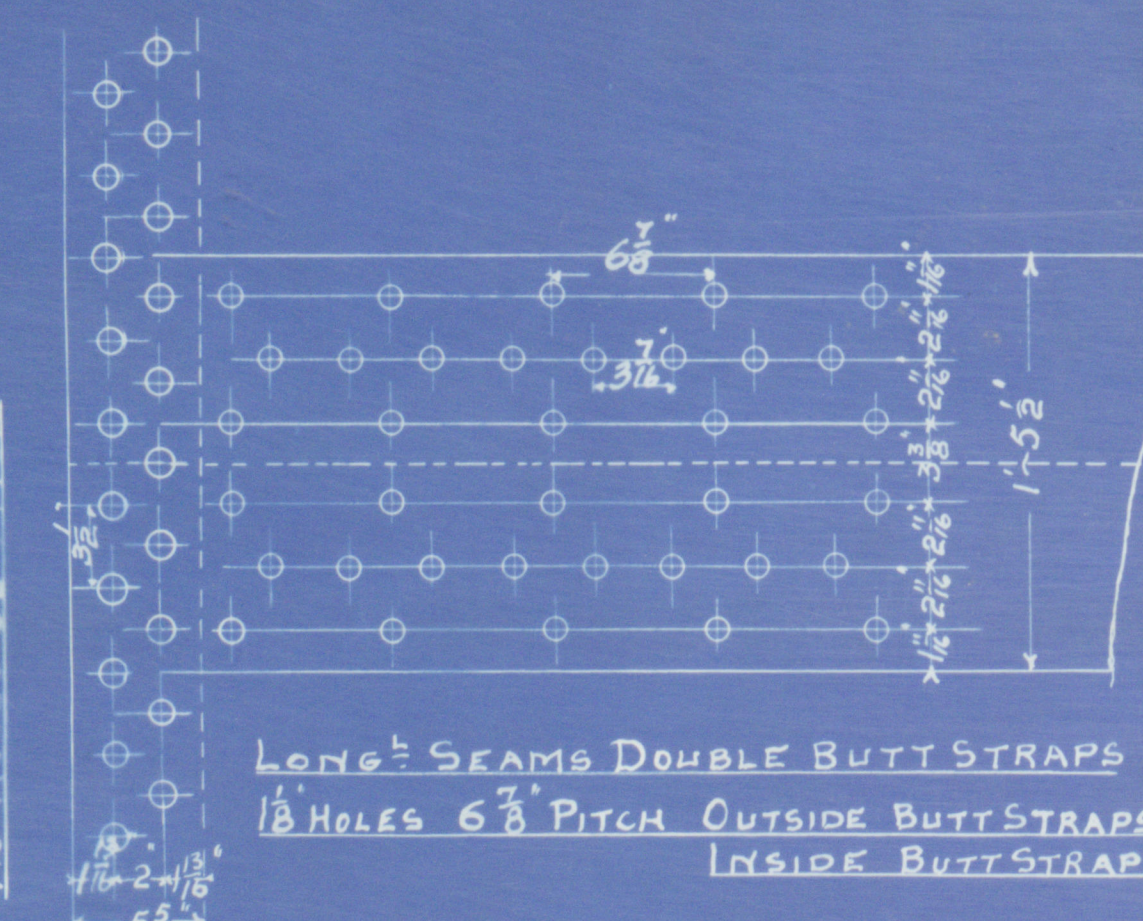

STEEL PLATES, BARS & RIVETS
ALL HOLES DRILLED IN PLACE

LONG SEAMS DOUBLE BUTT STRAPS

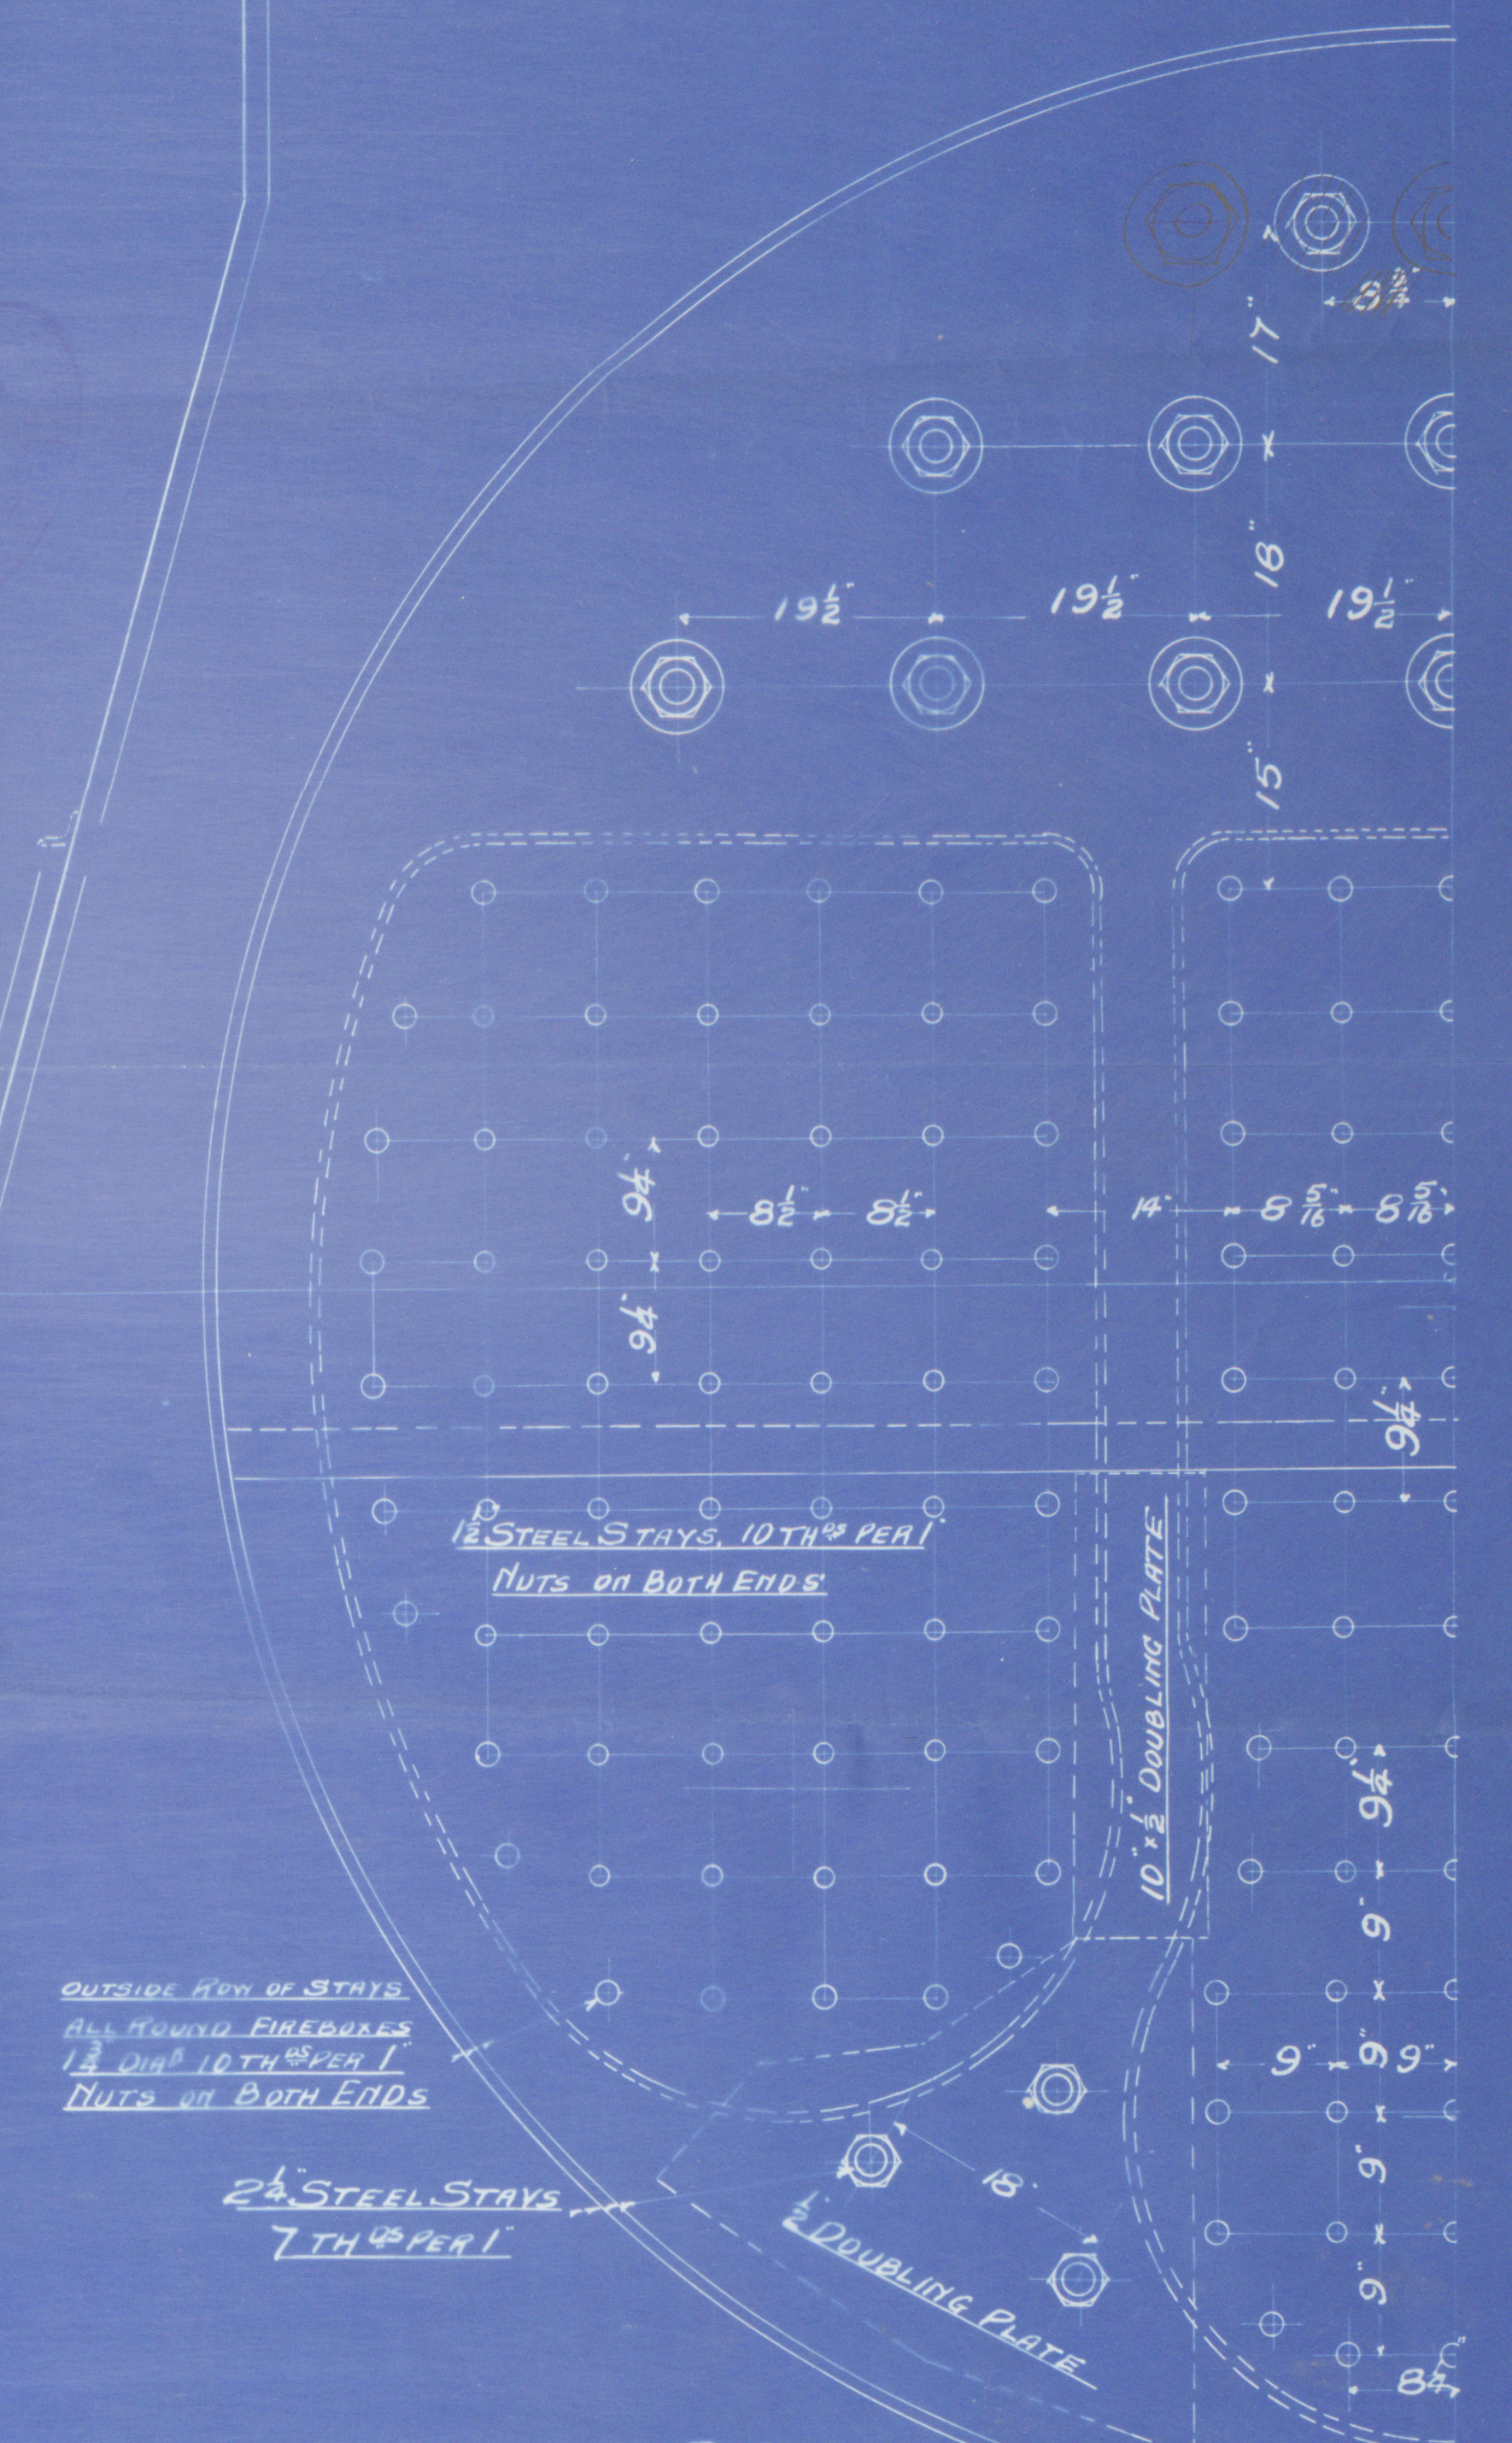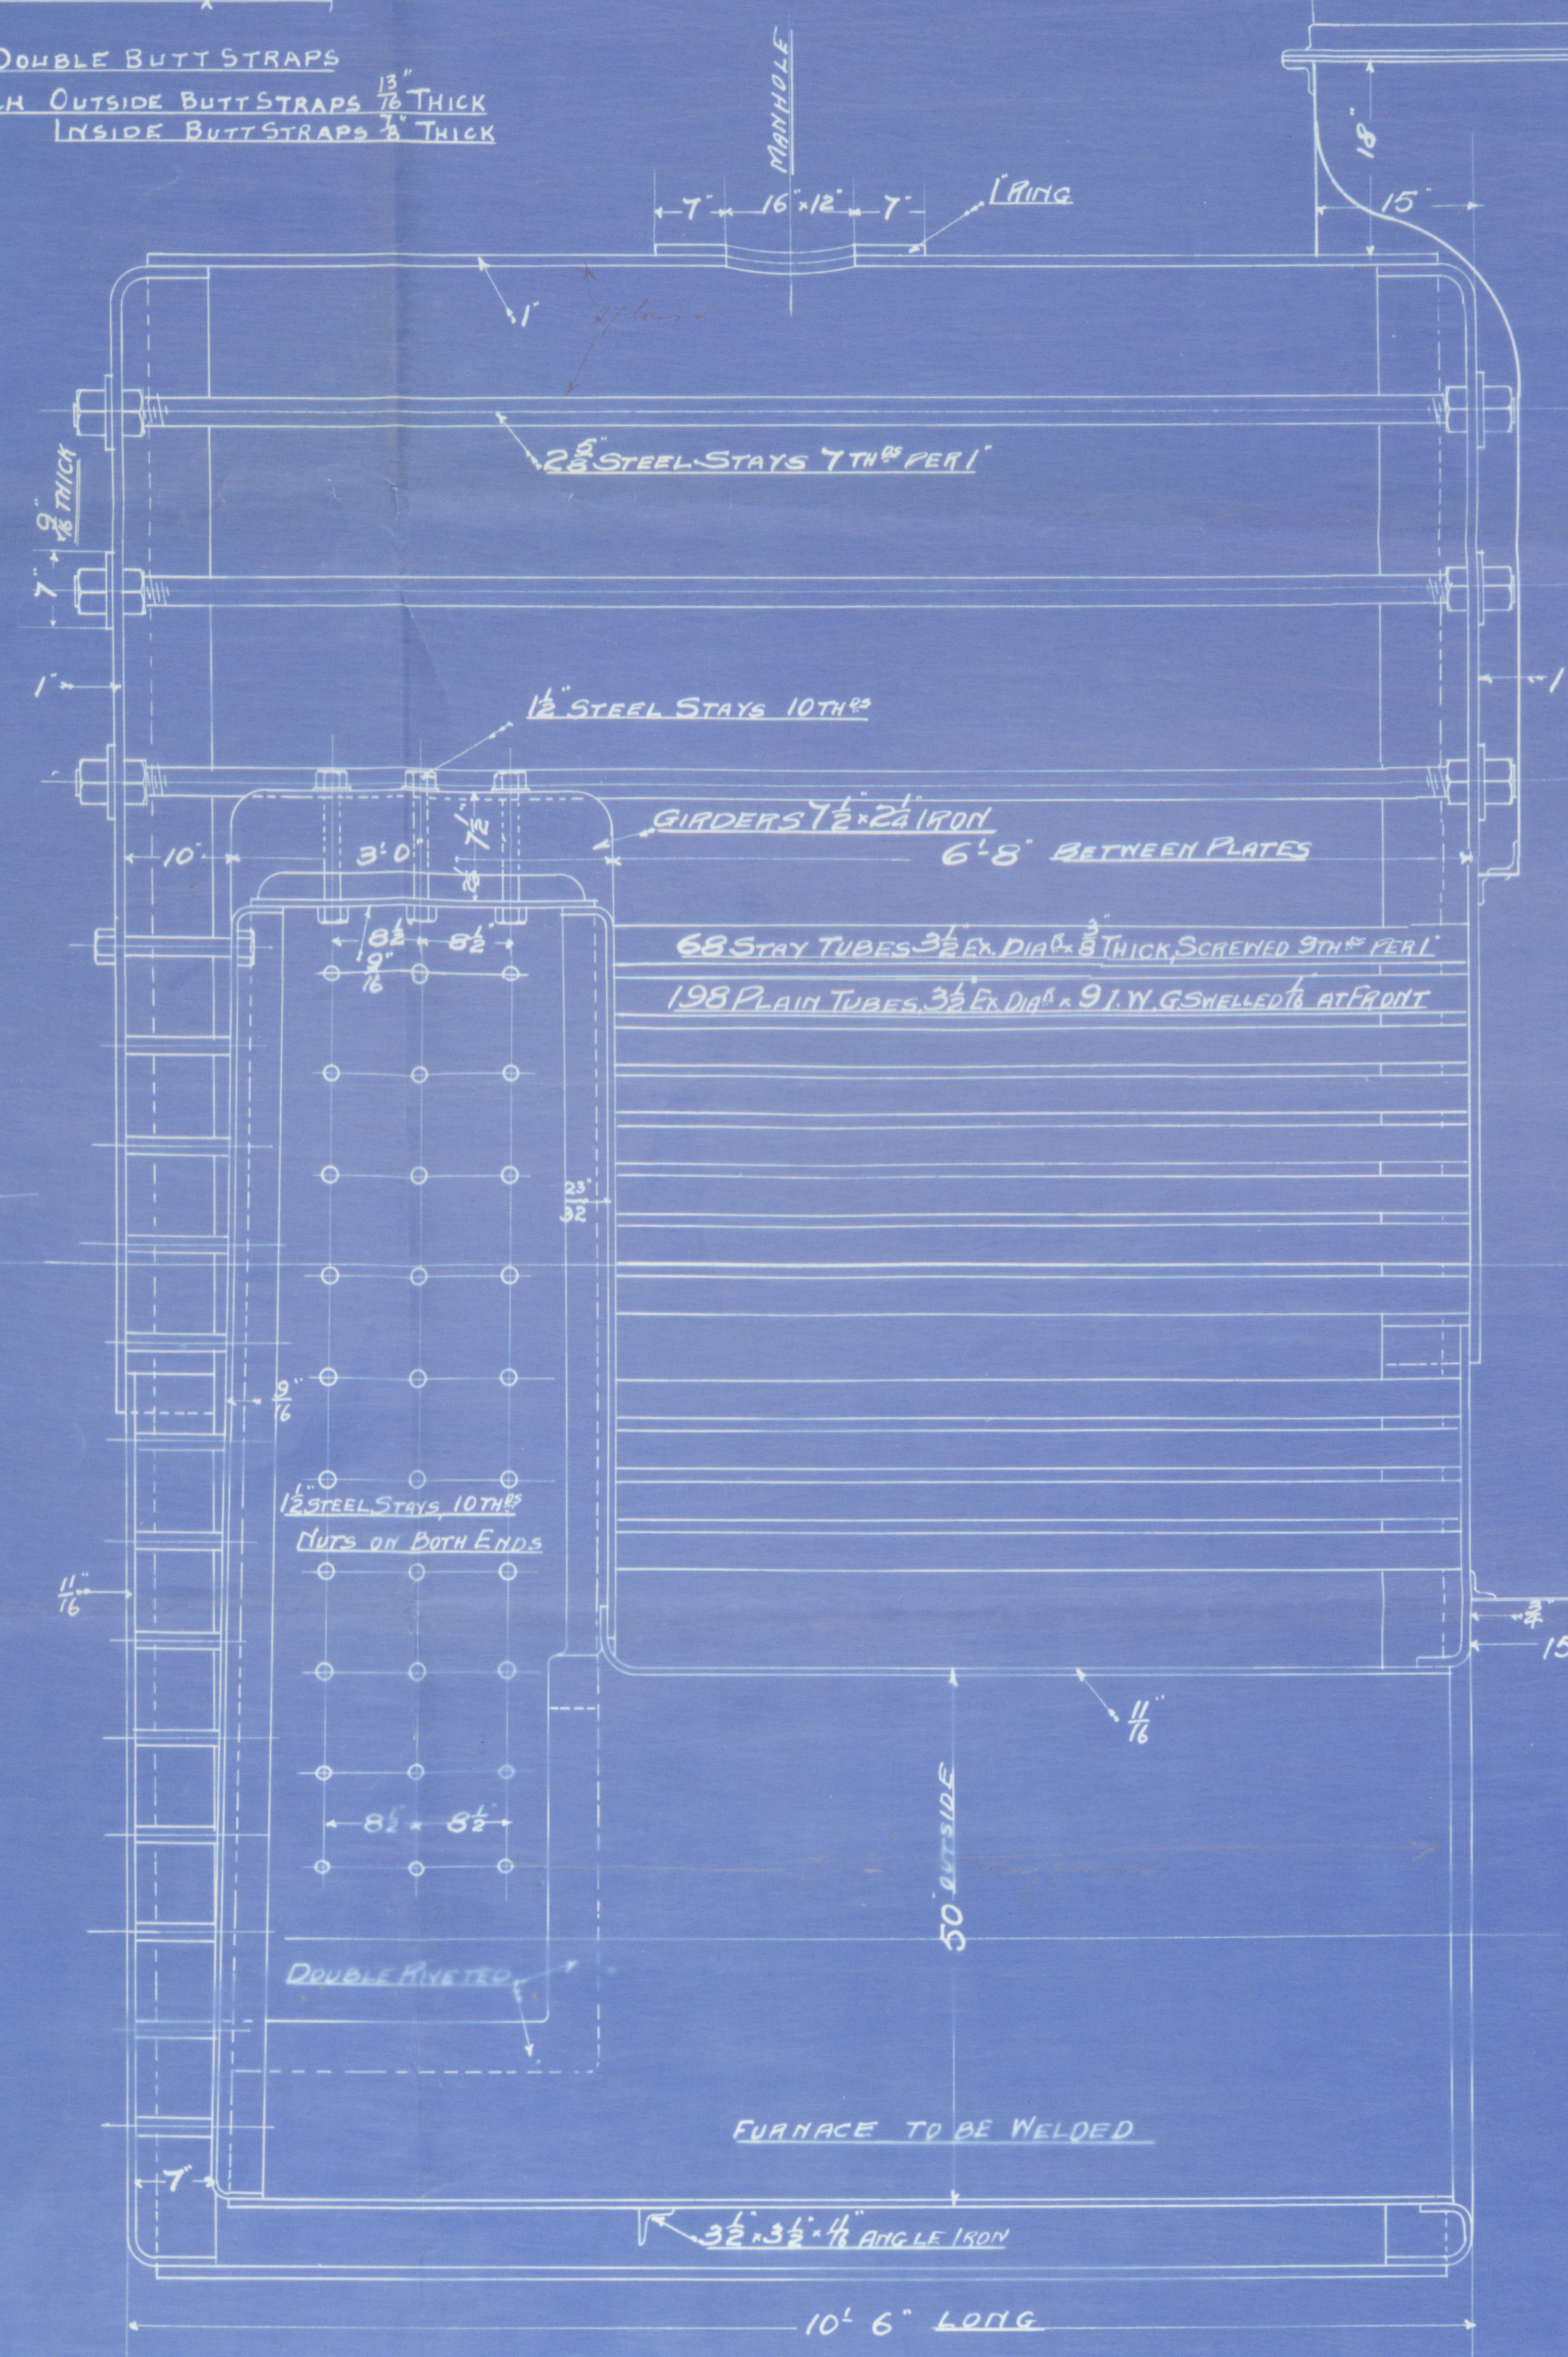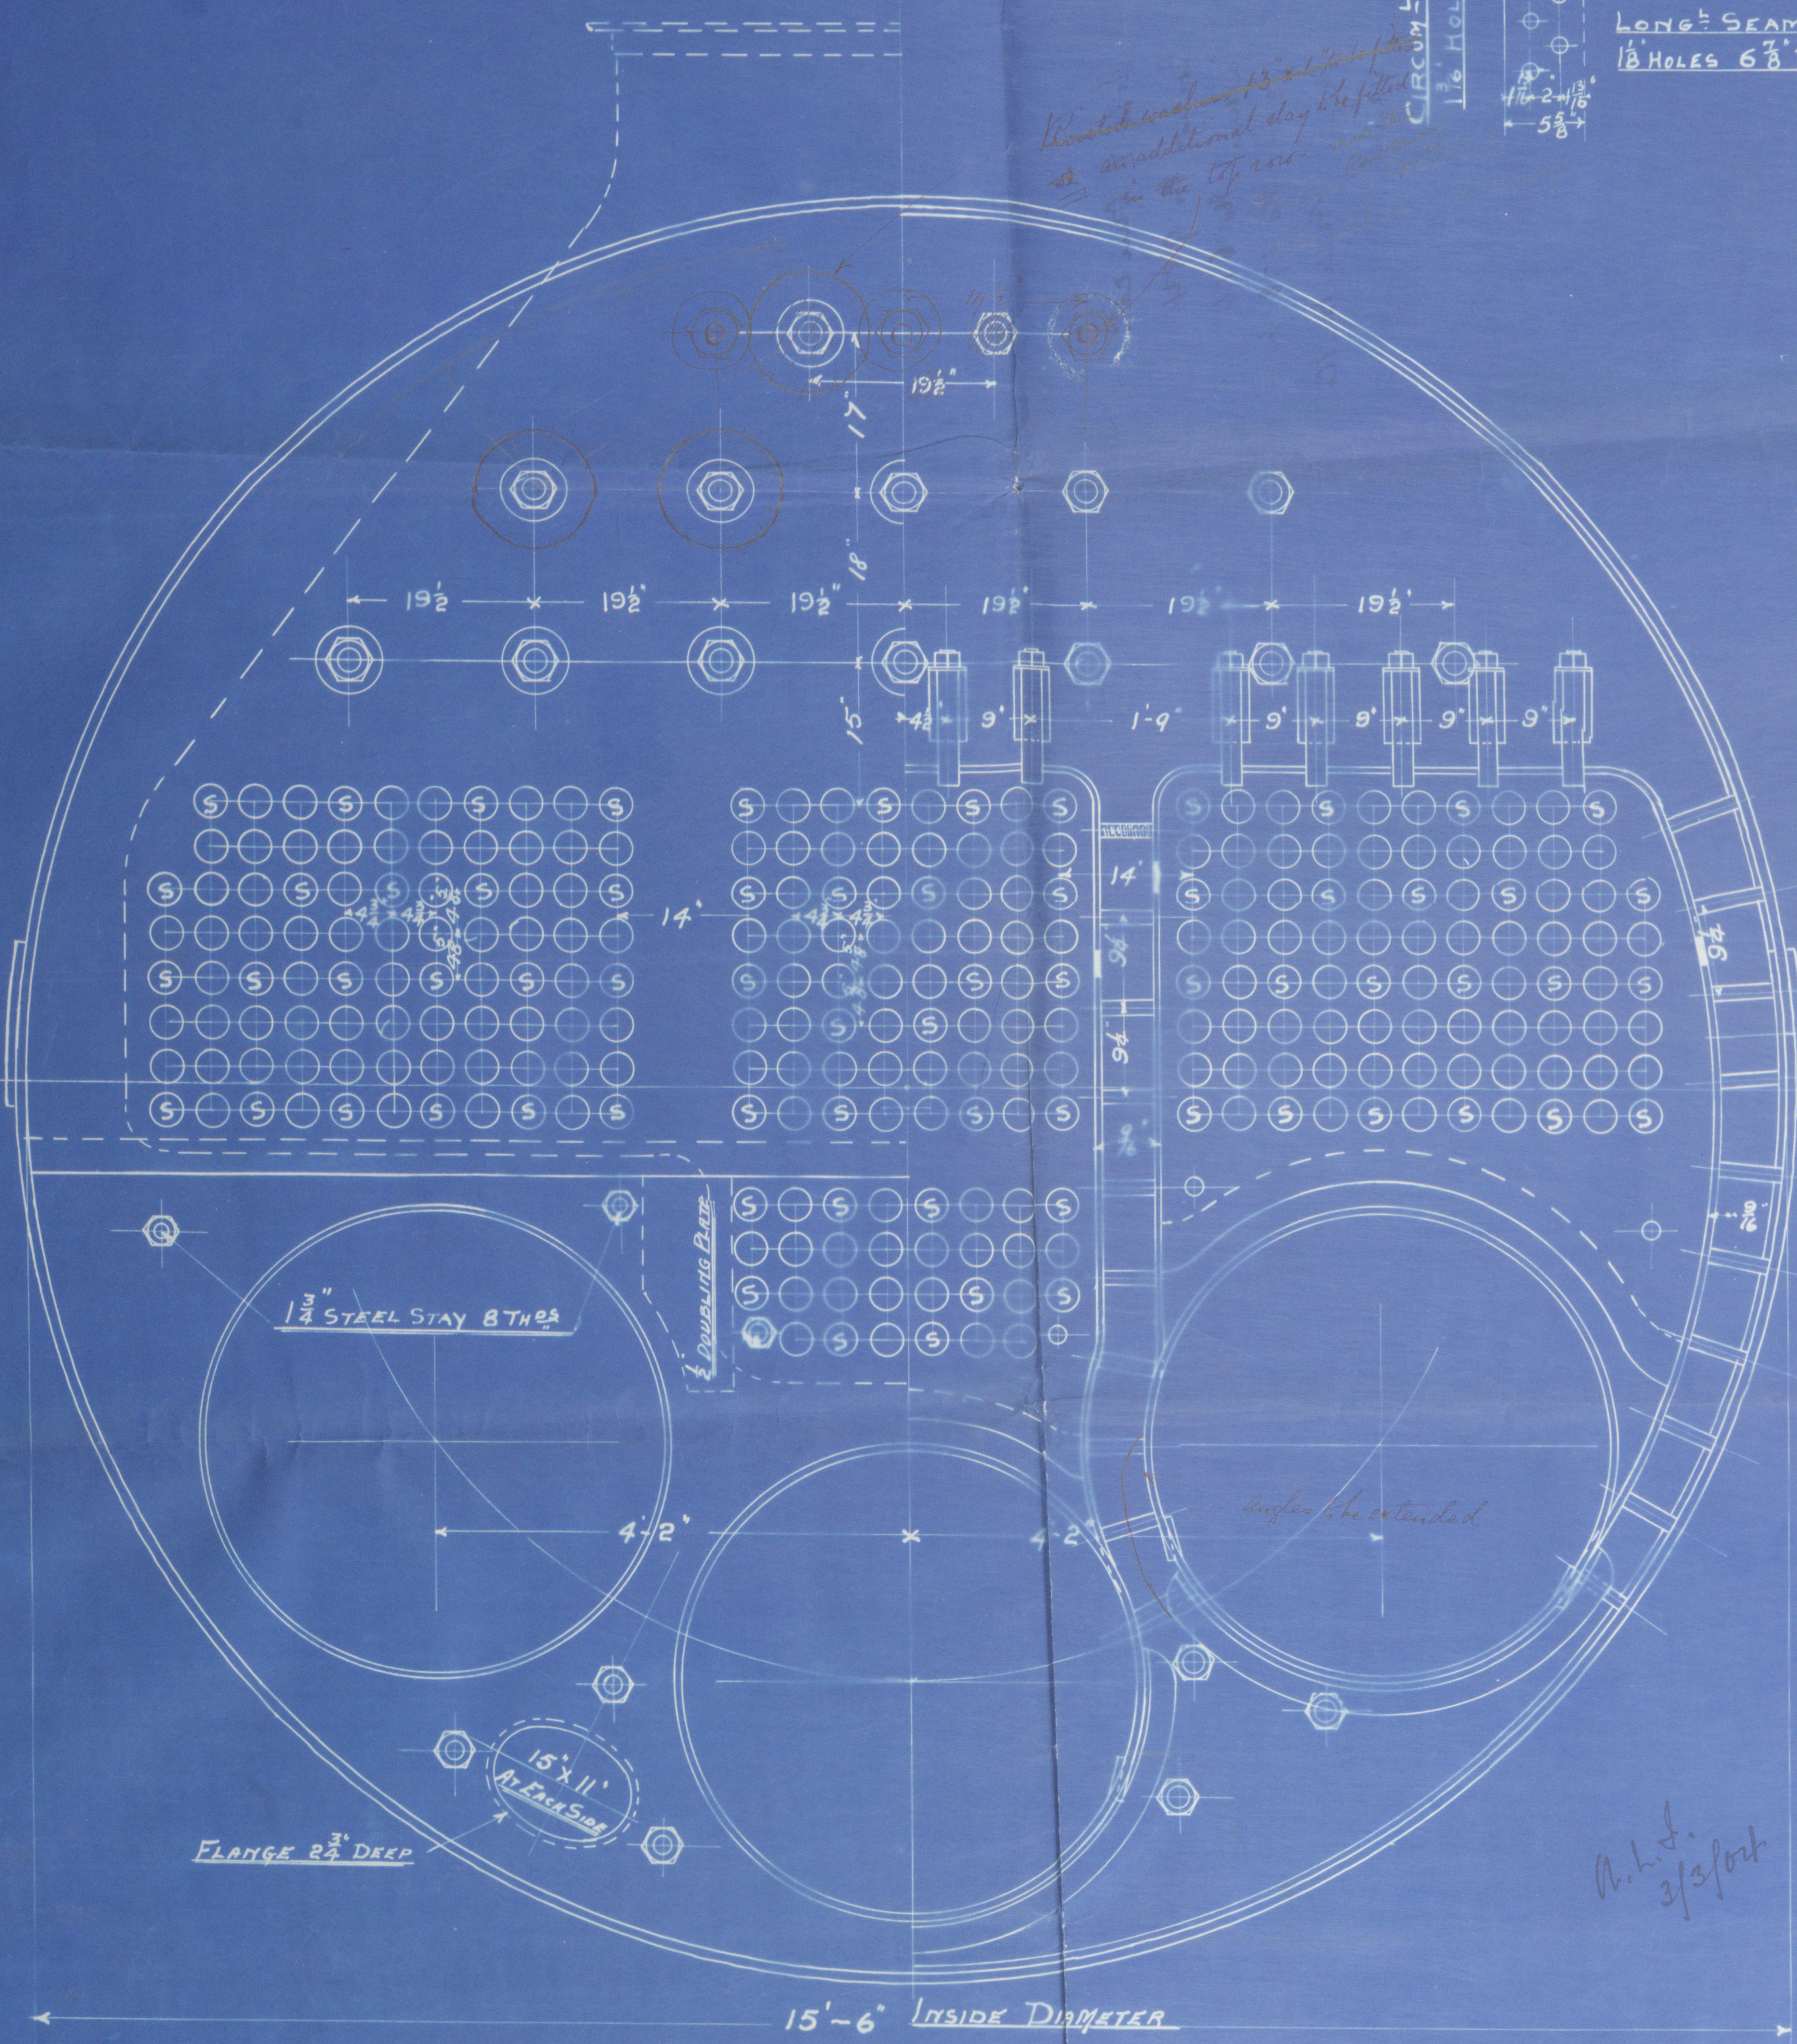

BOILER N° 984

WORKING PRESSURE 130 LBS PER SQ INCH

SCALE 1/4" = 1 FOOT

GRATE SURFACE	- - - 638 #
TUBE HEATING SURFACE	- 1658 #
OTHER	- - 367 #
TOTAL	- 2063 #
T.H.S.	- 31.7
G.S.	

TO HAVE LLOYD'S CERTIFICATE

Meper Ross & Dunn can


Book No 984

for engine No 616


for S/S No 178 by

Meper J Fullerton & Co
Pauley.

S/S "Cheshire"

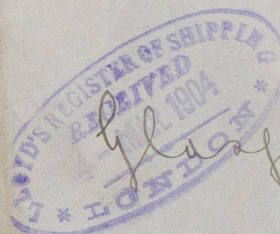

Glasgow wht No 22240

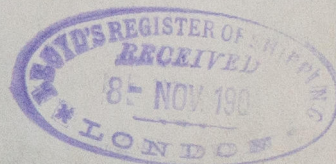

RETAIN



© 2021

Lloyd's Register
Foundation