
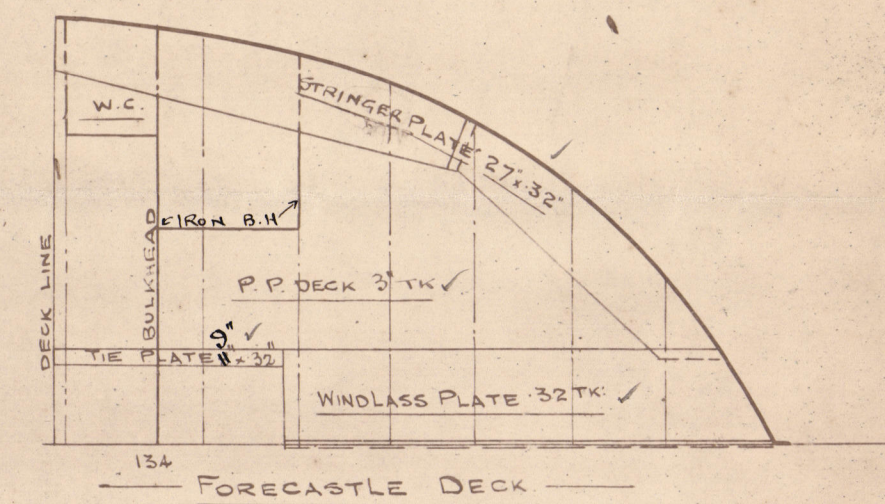
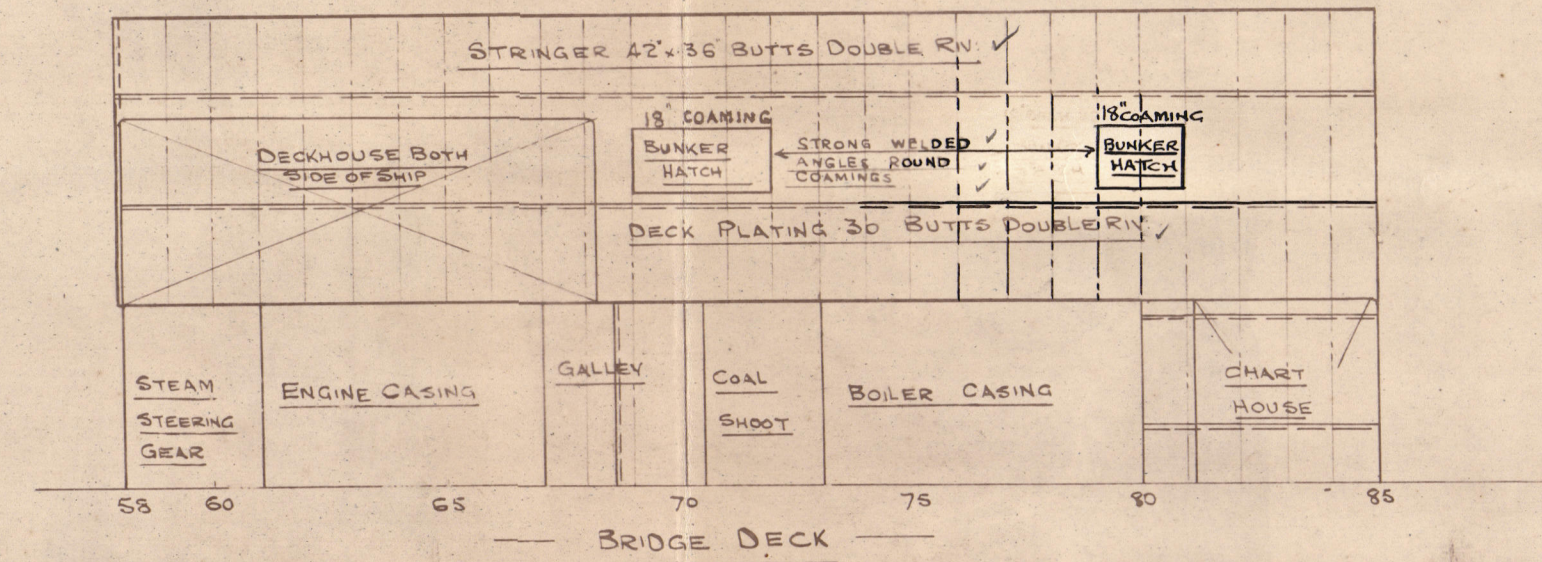



DECK PLANS NO. 245 3/8.

SCALE 1/8" = ONE FOOT.

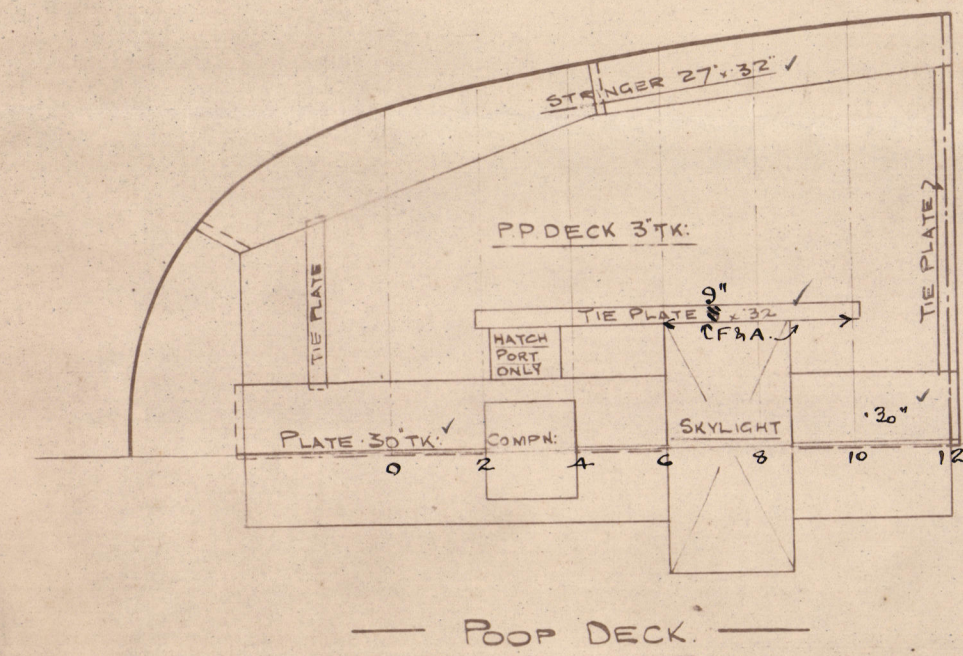

JOHN PRIESTMAN & CO.
SHIPBUILDERS,
SUNDERLAND.

23.3.14

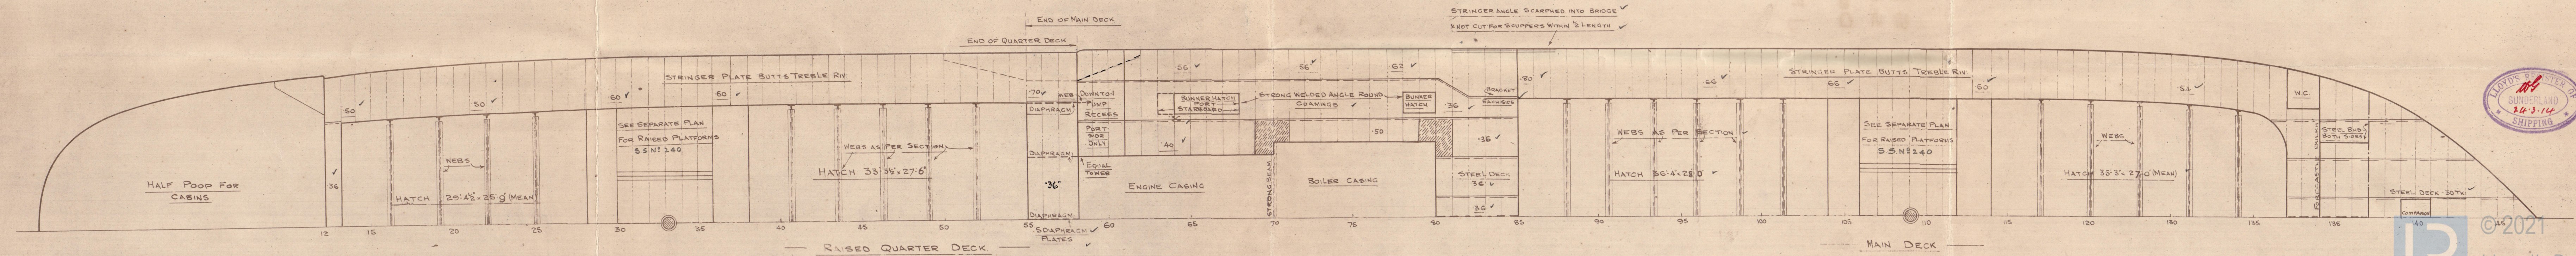

"
S. S. SIMOOM"

SLO RPT N^o 26066

DECK PLAN

(AS FITTED)

J. PRIESTMAN + C^os

N^o 245

ETAIN



© 2021

Lloyd's Register
Foundation

W 718-0036