



18.8.00  
19.9.00 (No 81)  
9.10.01

S.S. No 79 : No 81 appd 19.9.00  
LONGITUDINAL SECTION  
SCALE 1" = 1 FOOT

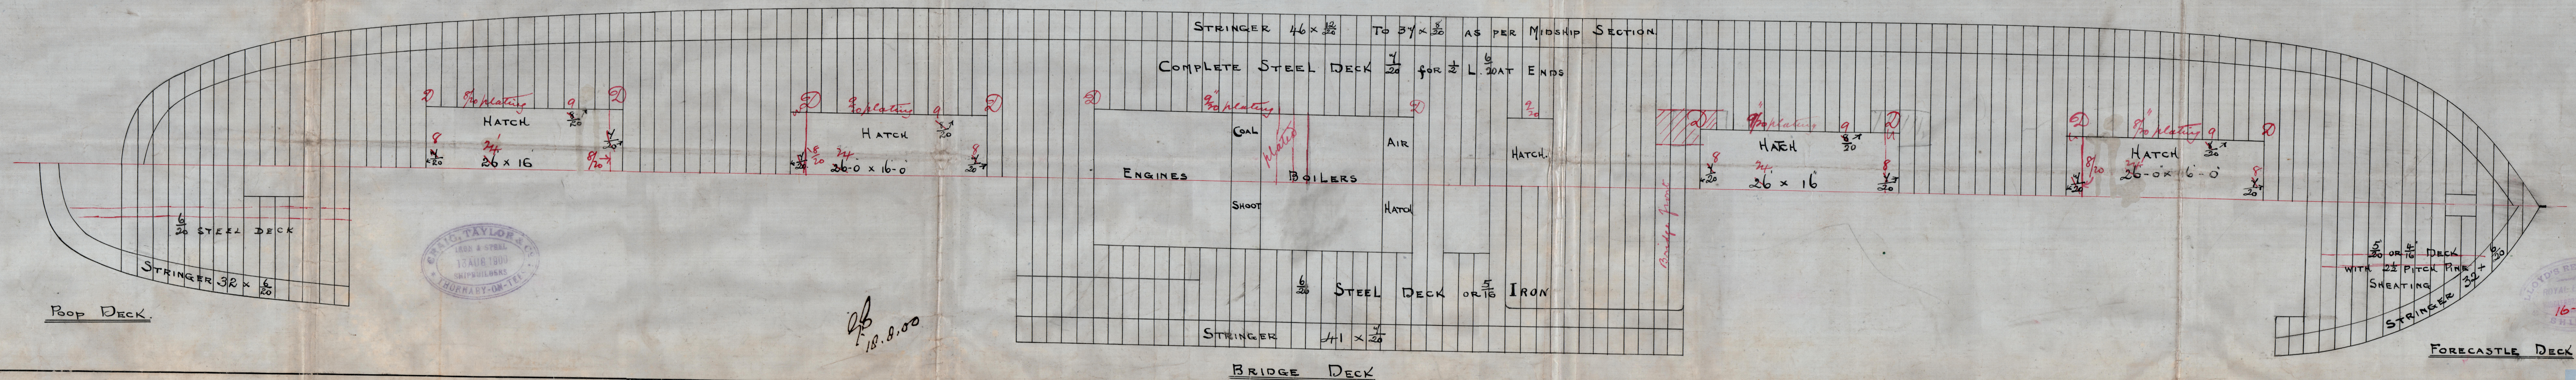

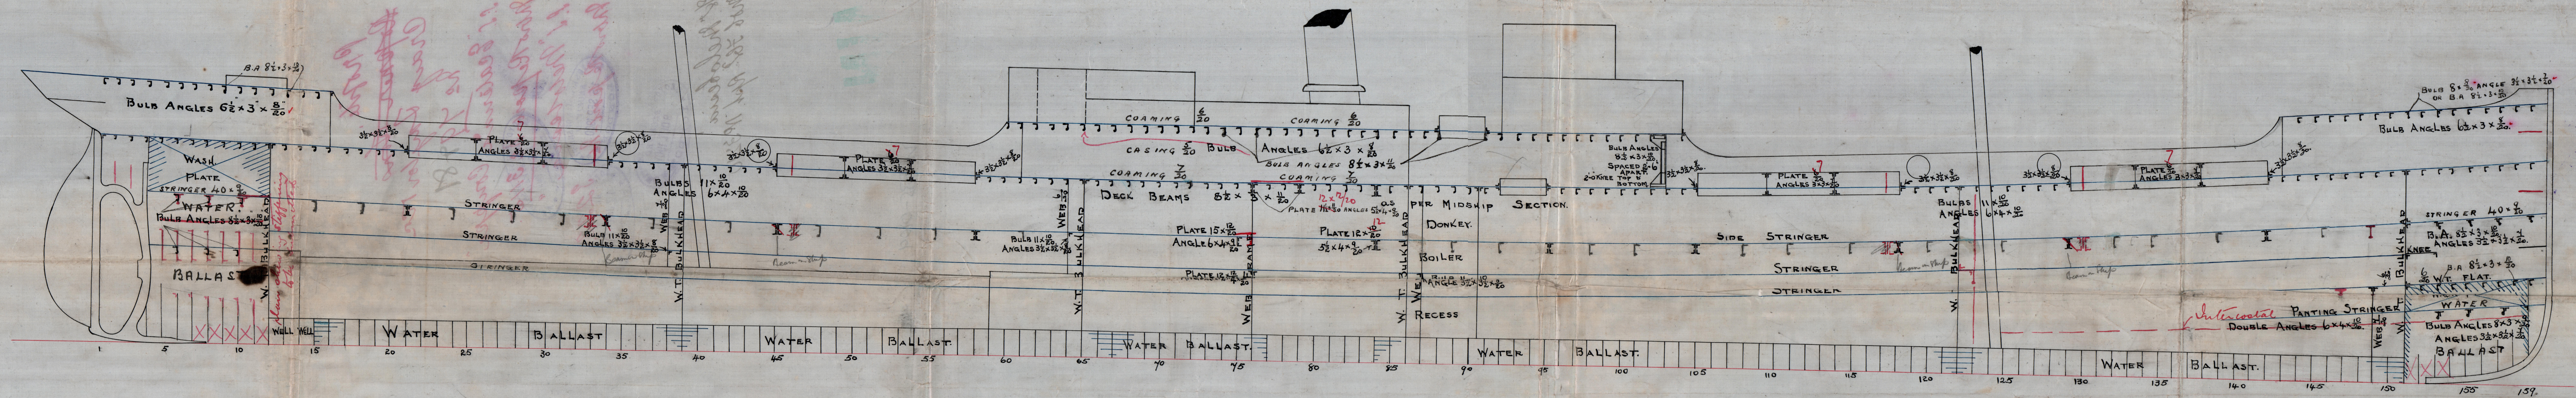

Profile.

~~Revised~~ ~~Wons~~

Craig Taylor rec

No 79781

S.S. "Ecatenia Couppa"

Mob Report No 3115.

S.S. "Melobesia"

Mob Report No 3223.

S.S. "Melobesia"

Mob Fl. Rpt. No 3210



© 2021

Lloyd's Register  
Foundation