
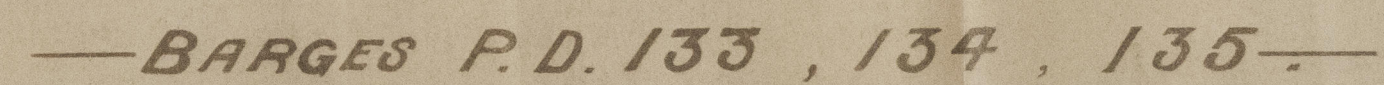


2.7.19

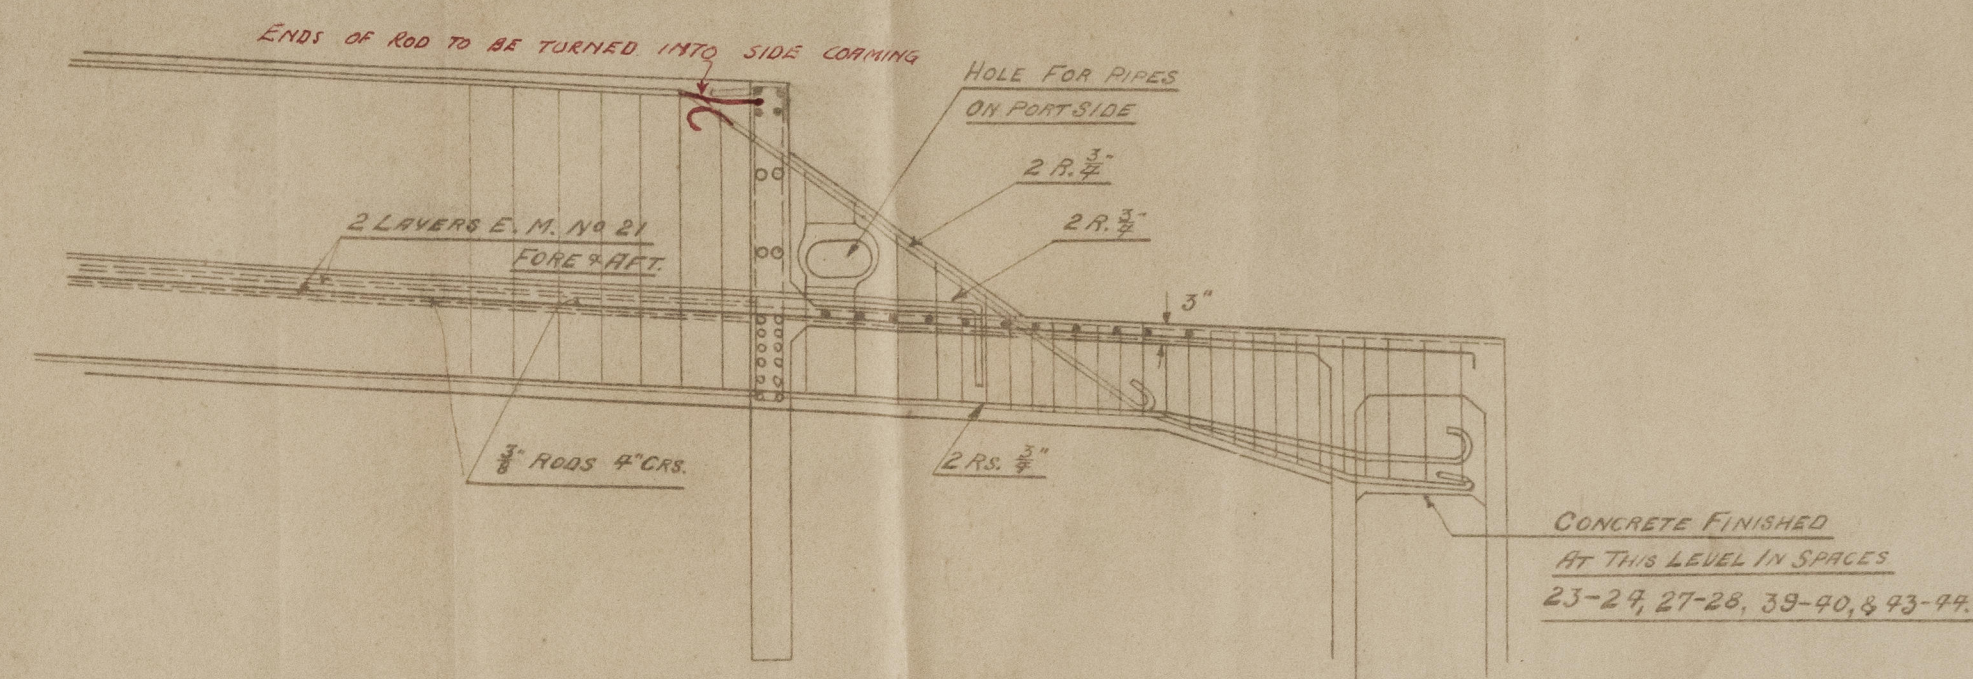

### *- ALTERATION OF DECK AT HOLD BULKHEADS.*

- SCALE  $\frac{1}{2}" = 1 \text{ FOOT.}$  -

J.v.M. DRAWING No. C4456.

**JOHN VERMEHR,**  
8 COWLEY STREET, WESTMINSTER.

DATE DRAWN 23/6/19

DRAWN BY TRACED BY *M.C.*

CHECKED BY

DATE SENT OUT

© 2023

23/6/19

TRACED BY *M.C.*

Lloyd's Rec

Foundation

11777 0003

W7.37-0003



Barge - Shoreham  
Alteration to Run  
between Docks to  
Hatchways

"Crest Street"



© 2021

Lloyd's Register  
Foundation

W737-0003



Barge - Shoreham  
Attention to Run from  
between Docks to  
Hatchways

"Crest Street"

Cable

W737-0003

W737-0003



© 2021

Lloyd's Register  
Foundation