

S. S. <sup>"</sup>KARA<sup>"</sup>. № 926

SCALE  $\frac{1}{2}'' = 1 \text{ FOOT.}$

CLASS 100 A.I. LLOYDS &

BRIDGE ON STR: PLATE 54-46. BUTTS LAPPED & TREBLE RIVETED

FILE + POOP ON STRINGER PLATE 29" x 32 BUTTS LAPPED + DOUBLE RIVETED

FILE OF STEEL 30 SHEATHED IN WAY OF WINDLESS

POOP OF " ~~2~~ 30 - WITH 2 1/2" RIGID PIPE. BUTTS SINGLE RIVETED

Quel  
17-10-19

26/9/19.

926

Founda




Messrs W. Gray & Co. Ltd.


S. S. "KARA"

Nº 926. (TYPE "H")

Midship Section.

West Hartlepool report

Nº. 15685-

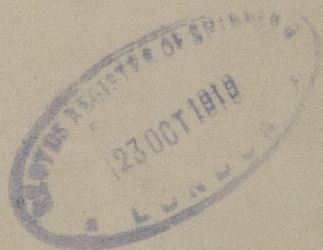

RETAIN



© 2020

Lloyd's Register  
Foundation

W742 - 0160