

DRAWING **LR** Lloyd's Register Foundation
W742-0161

COCHRAN & CO., ANNAN, LA.

Roller No. 8022

Drawing No. 9696

100 lbs per sq. inch.

Frank on both sides.


No 14791
LLOYD'S TEST
200 lbs
PMG 20/6/10.

GLASGOW REPORT No. 38863.

s/s. Kara.

West Hartlepool aft

15-685

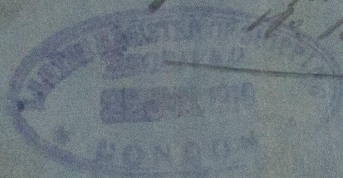

RETAIN



© 2020

Lloyd's Register
Foundation

W742-0131/1

W742-0161 2 1/2

No. 2 G 2. 4-17.

COCHRAN & CO., ANNAN, Ltd.



Enclosure

FOR

Lloyd's Register
Foundation