


S. S. No 132. Sister Vessel to N-114. "Gay I."
LONGITUDINAL SECTION.

SCALE $\frac{1}{8}$ IN = 1 FT.

DIMS: 165'-0" BP x 26'-0" x 13'-5" MLD MM DL.

29/10/07
 Artm

*Water Ballast
 1st Port 19.00.30*

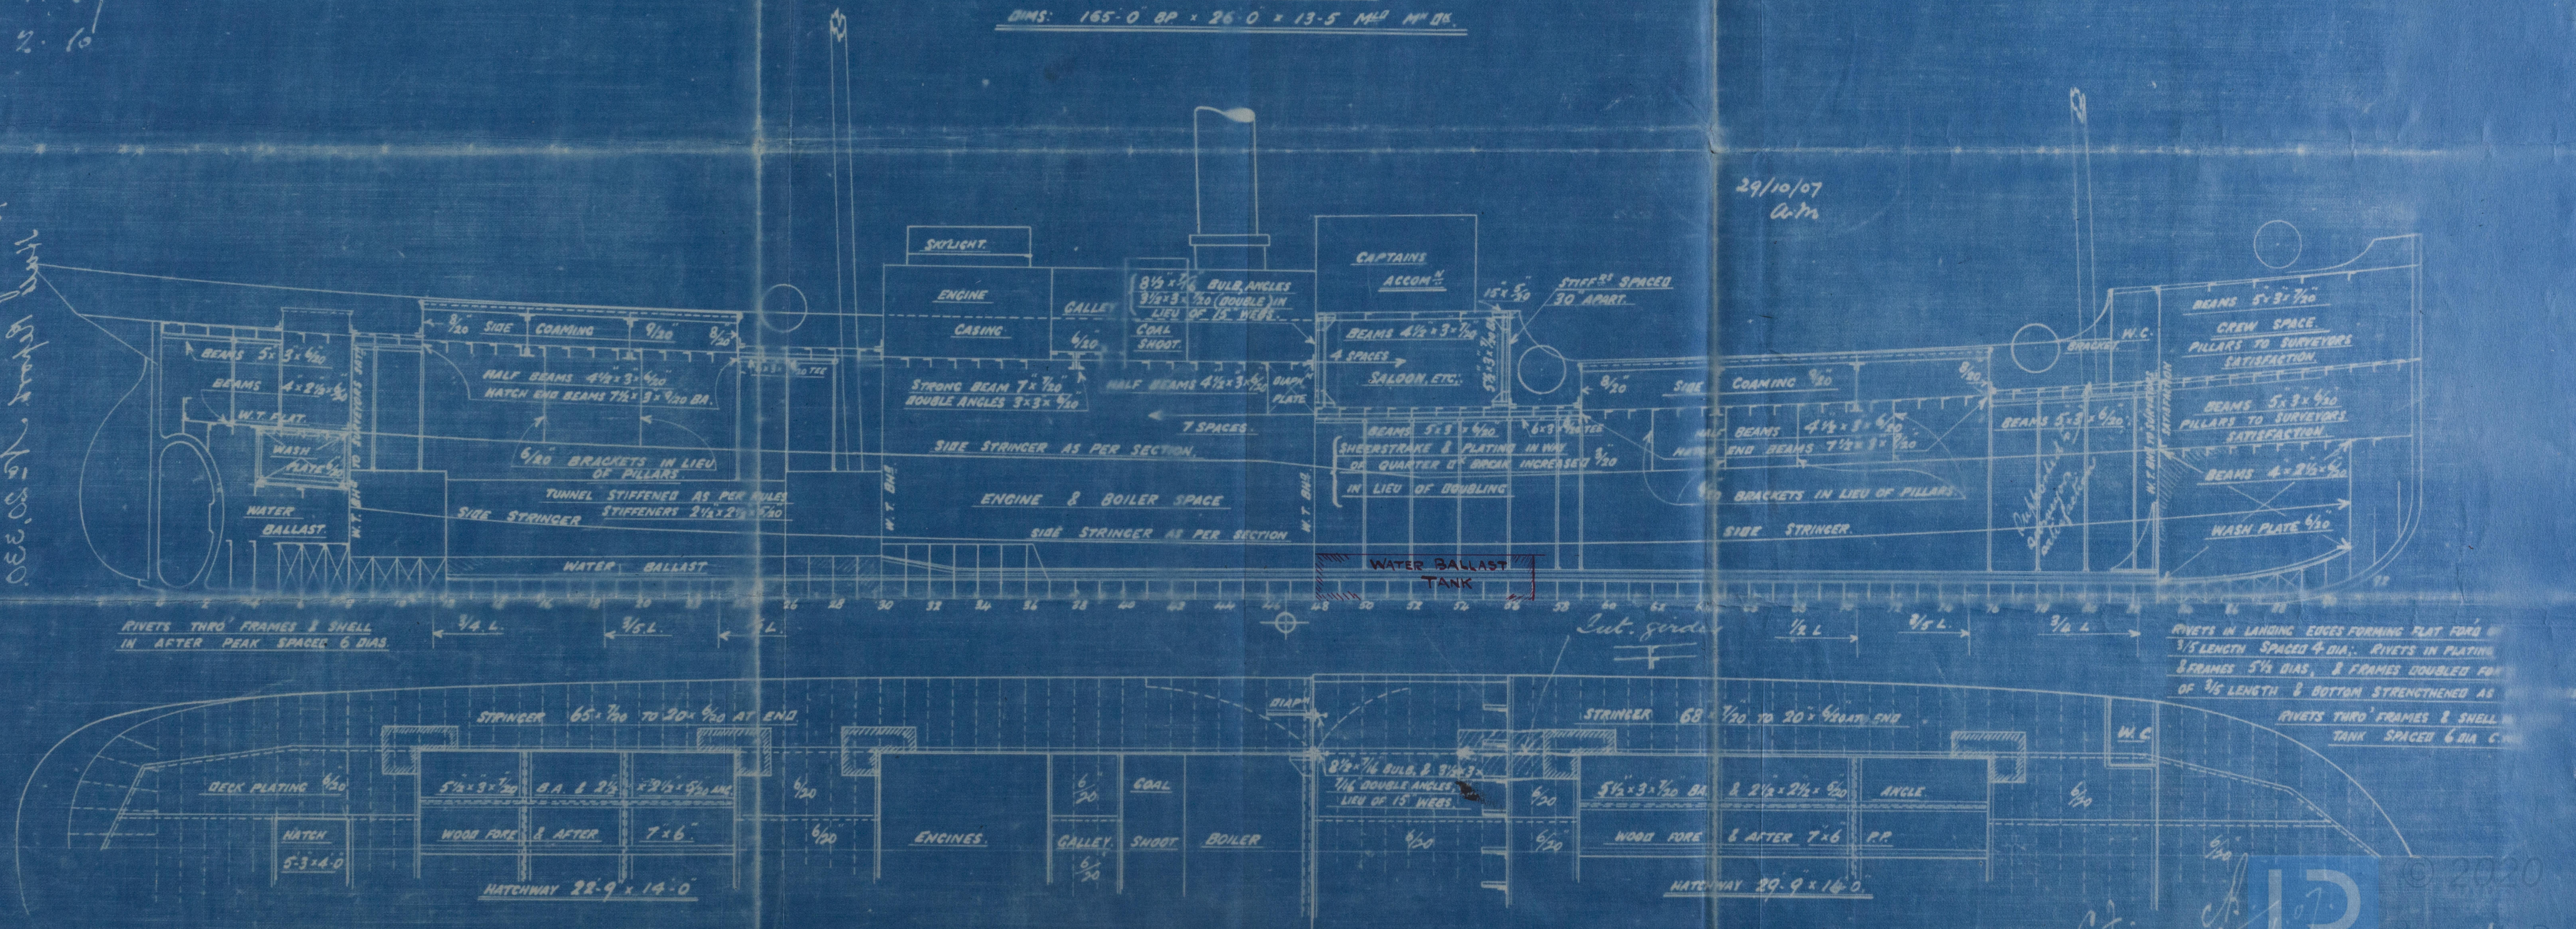

Goble S. R. C. L.

No 132

^{Duplicate.}
Profile and Week

s/s "Trent"

Hull Report No—23281

RETAIN



© 2020

Lloyd's Register
Foundation

W744-0052