


L.R. 03.
 26.6.03.
 LLOYD'S REGISTER
 OF SHIPBUILDERS
 LONDON

Donkey Boiler.


Working Press. 100 lbs. Heating Surf. 160 sq'

Material Steel 27-32 ton.


Scale 1/2" = 1'

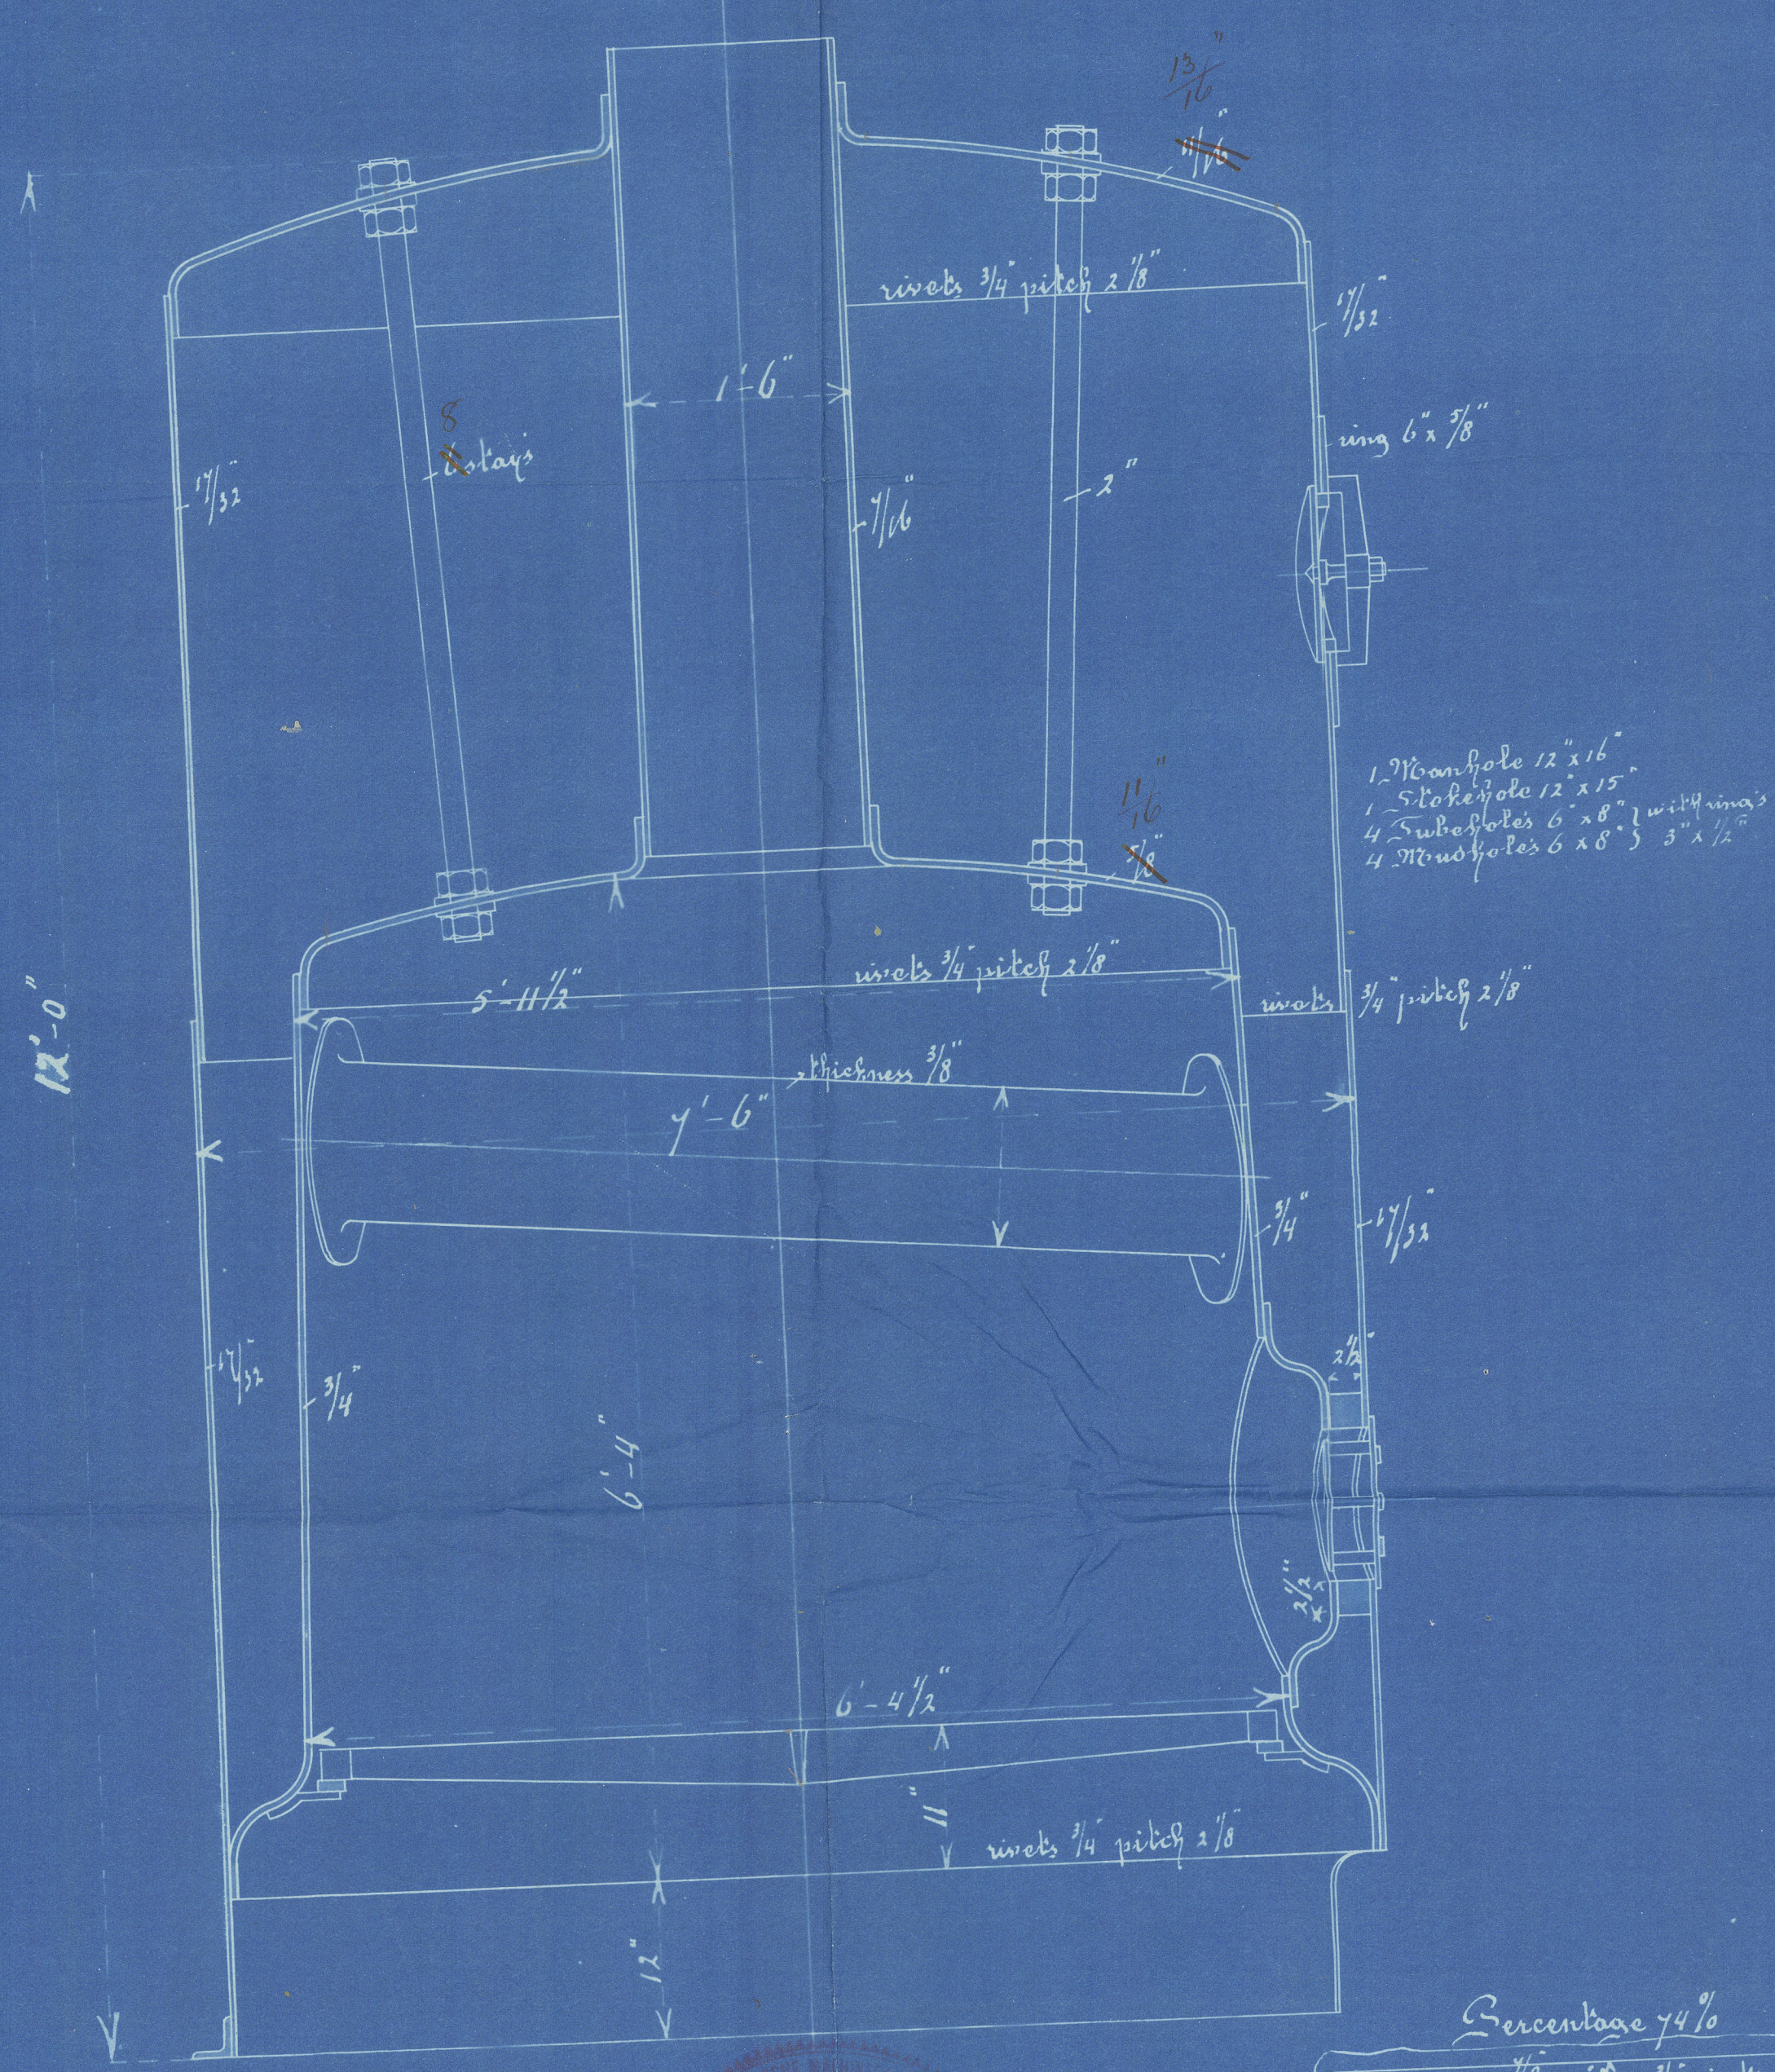


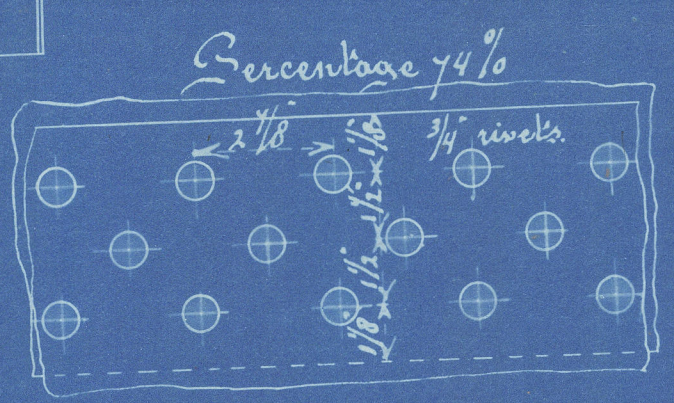


L. 10 June 1903
 LLOYD'S REGISTER
 OF SHIPBUILDERS
 LONDON

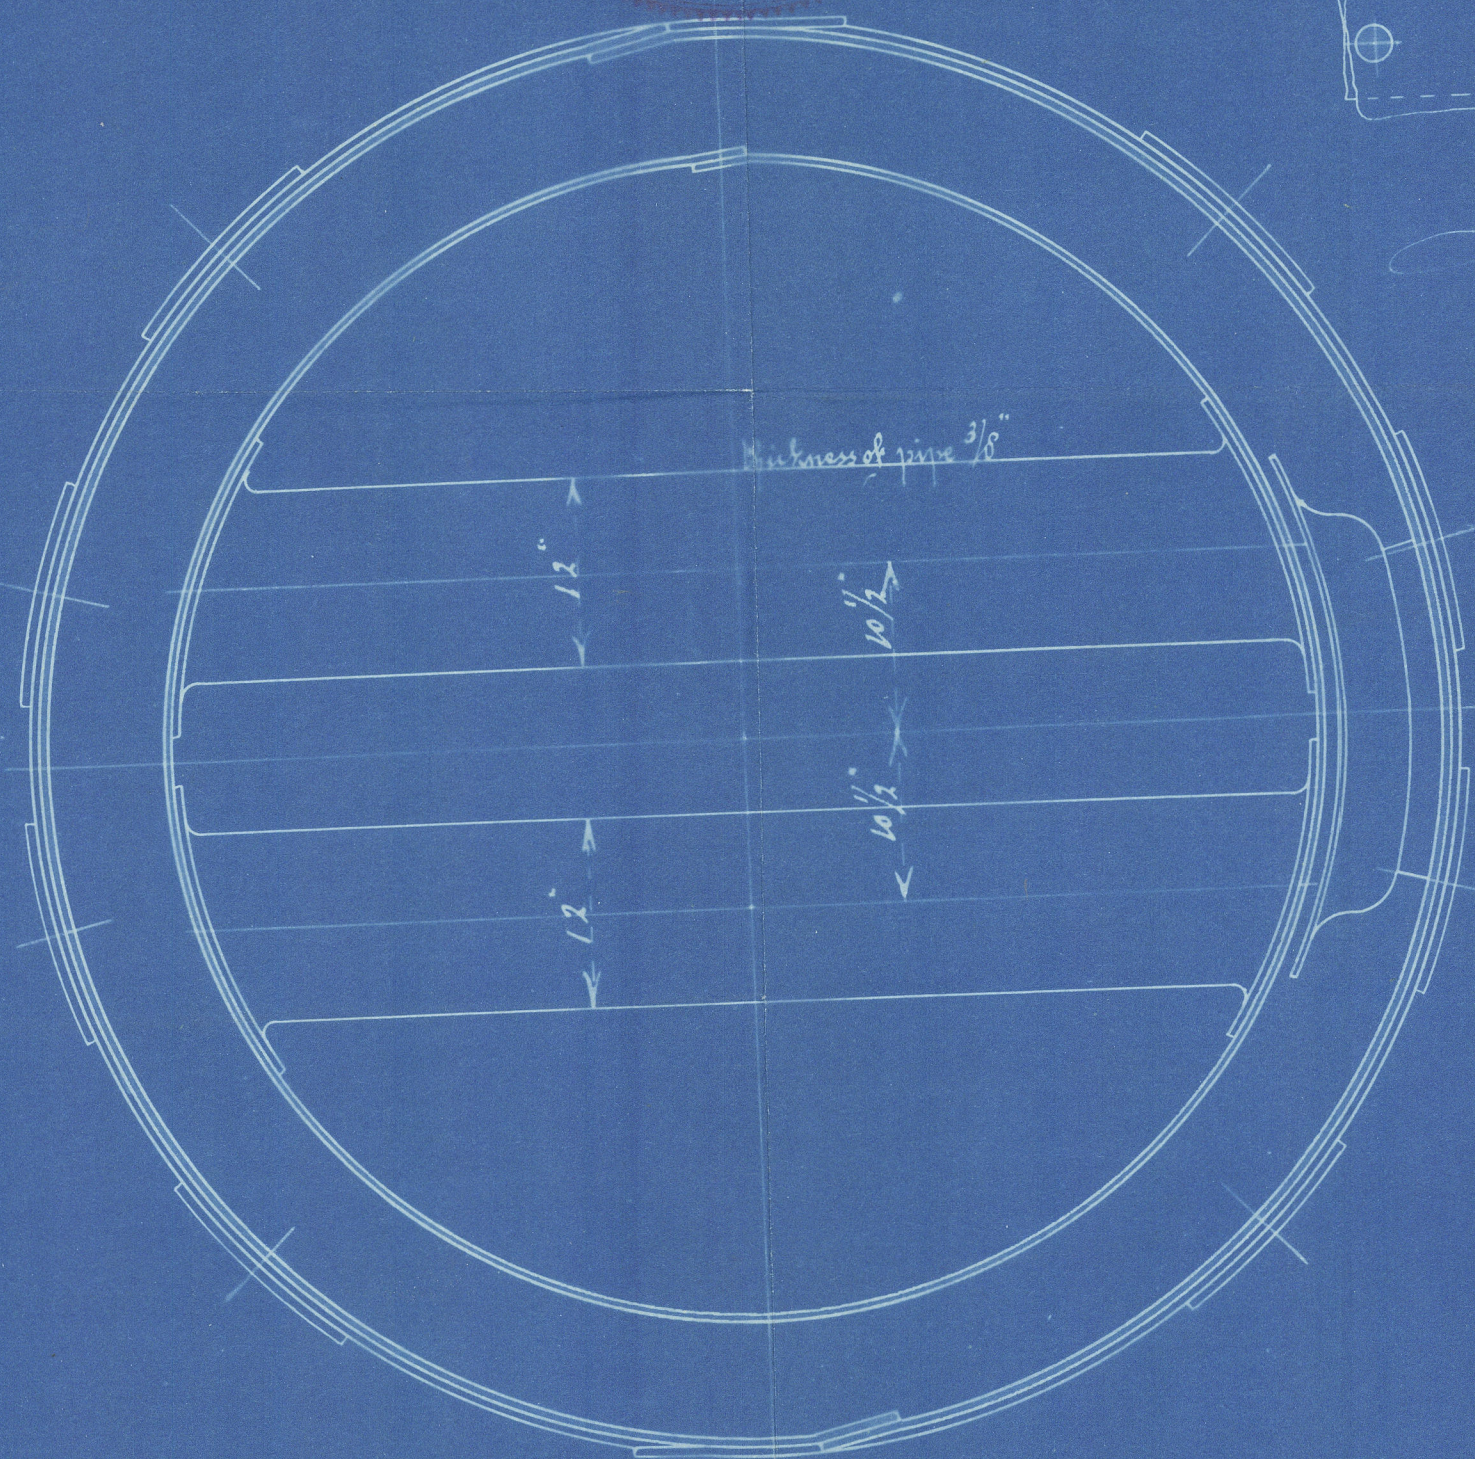


L.R. 03.
 26.6.03.

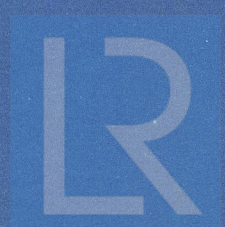




Voyage N° 246

S/S Thelma

Rot. 3798

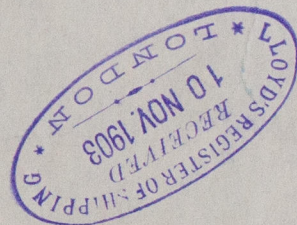

RETAIN



© 2021

Lloyd's Register
Foundation

W750-0079