

Lloyd's Register of Shipping.

(Report on Vessel No. _____ Port _____)

No. 15961 SHIP FORGINGS OR CASTINGS.

I have to report that the undermentioned ~~Iron or Steel Forgings or Castings~~, manufactured by Emerson Walker & Thompson Bros Ltd of Dunston on Tyne for the Vessel No. 210, being built by Messrs Wood Skinner & Co of Newcastle have been inspected by me as set forth below and found to be, so far as can be seen, Sound

The words FORGINGS or CASTINGS, IRON or STEEL, should be struck out as may be required.


Mark on Forgings or Castings.

Lloyd's
No. 3703N
J.G.


James Gregory
Newcastle
Quadrant Tiller

	STERN FRAME.	RUBBER FRAME.	STEM.
Material* ...		Scrap steel	
How made ...		Forged	
Dimensions ...		7 3/4 Post	
Progress on Inspection ...		Forged & Machined	
Date when Inspected ...		Feb 18 th & 26 th	
CASTINGS.			
Tests on Standard Test Pieces.			
Tensile Test—			
Tons per square inch ...			
Extension per cent. ...			
Cold Bending Test—			
Angle before fracture ...			
Drop Test—			
Height from ground ...			
Hammering Test—			
If made according to Rules and found satisfactory ...			

SKETCHES OF FRAMES SHOWING POSITION AND DESCRIPTION OF WELDS OF FORGINGS.

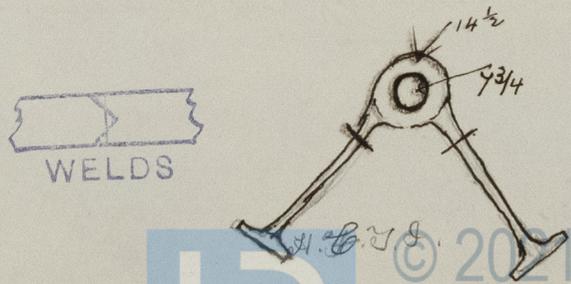

Fee (if any chargeable) £ _____
To be paid at _____

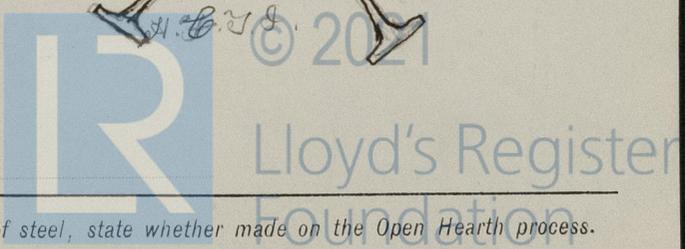

* If of Iron, state whether scrap or puddled iron. If of steel, state whether made on the Open Hearth process.
2h, 6, 17. T.

W763-0165