


J. Brown & Co L^d

No 401

"Wiltshire"

Profile as built

GLASCOW REPORT No. 31145

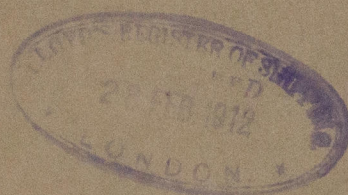

RETAIN

RETAIN

W766 -0051



© 2020

Lloyd's Register
Foundation