


PROFILE & DECK PLANS

DIMENSIONS 396'0" x 54'0" B.M.D. x 28'1" D.M.D.

SCALE 1" = 1 FOOT

"ISHERWOOD SYSTEM" PATENT

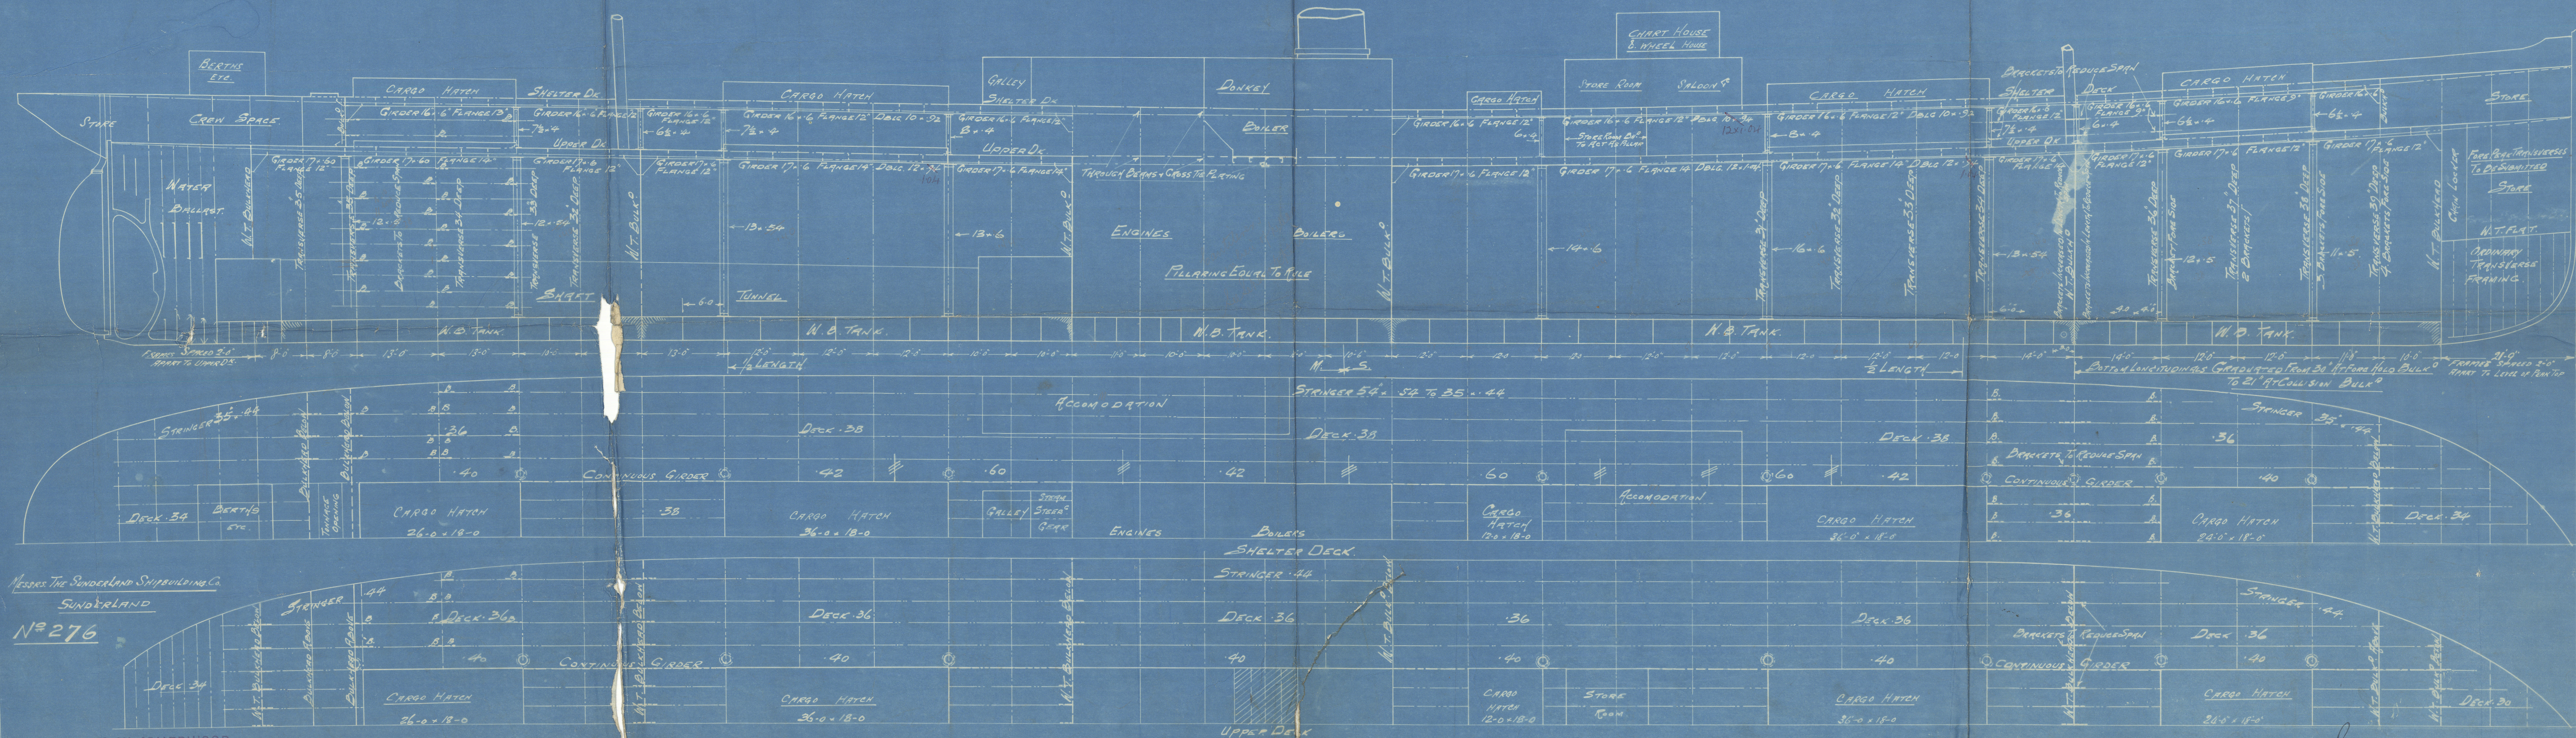

Messrs. The Sunderland Shipbuilding Co.
SUNDERLAND

Nº 276

J. W. ISHERWOOD.

Per 27.6.12

27.6.12

Profile & Deck Plan

No. 276

Sunderland S.S. Co.

140 YDS

APPROVED

PROFILE


X

DECK

PLANS

276


S/S

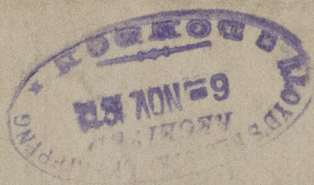

S.S. Shirley

Sld Rpt No 25823

RETAIN

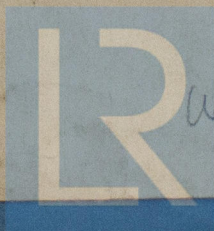

© 2020

W768-0022

Lloyd's Register
Foundation