



STEEL BOILER 12'-0" DIA 10'-0" LONG 100 LBS W.P.

LLOYDS & BOARD OF TRADE




4486

RILEY BROS. (BOILERMAKERS) LTD.
STOCKTON ON TEES.

16/9/12

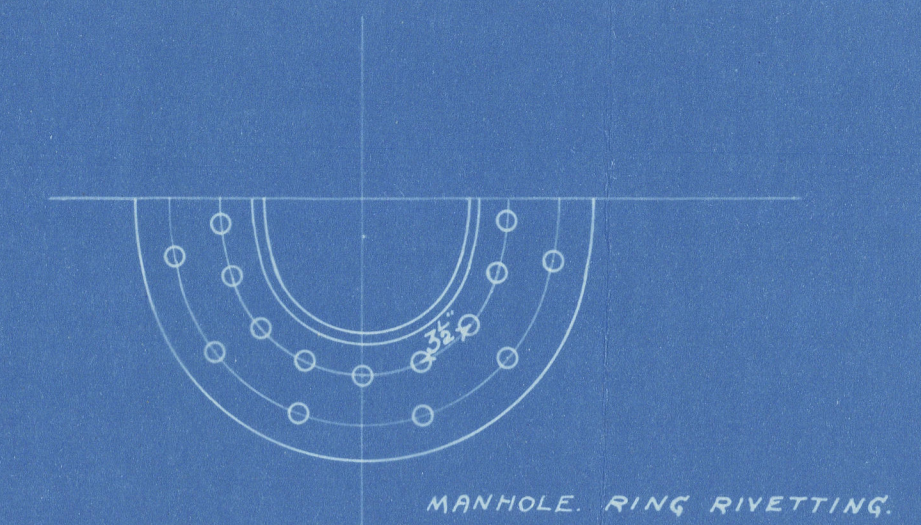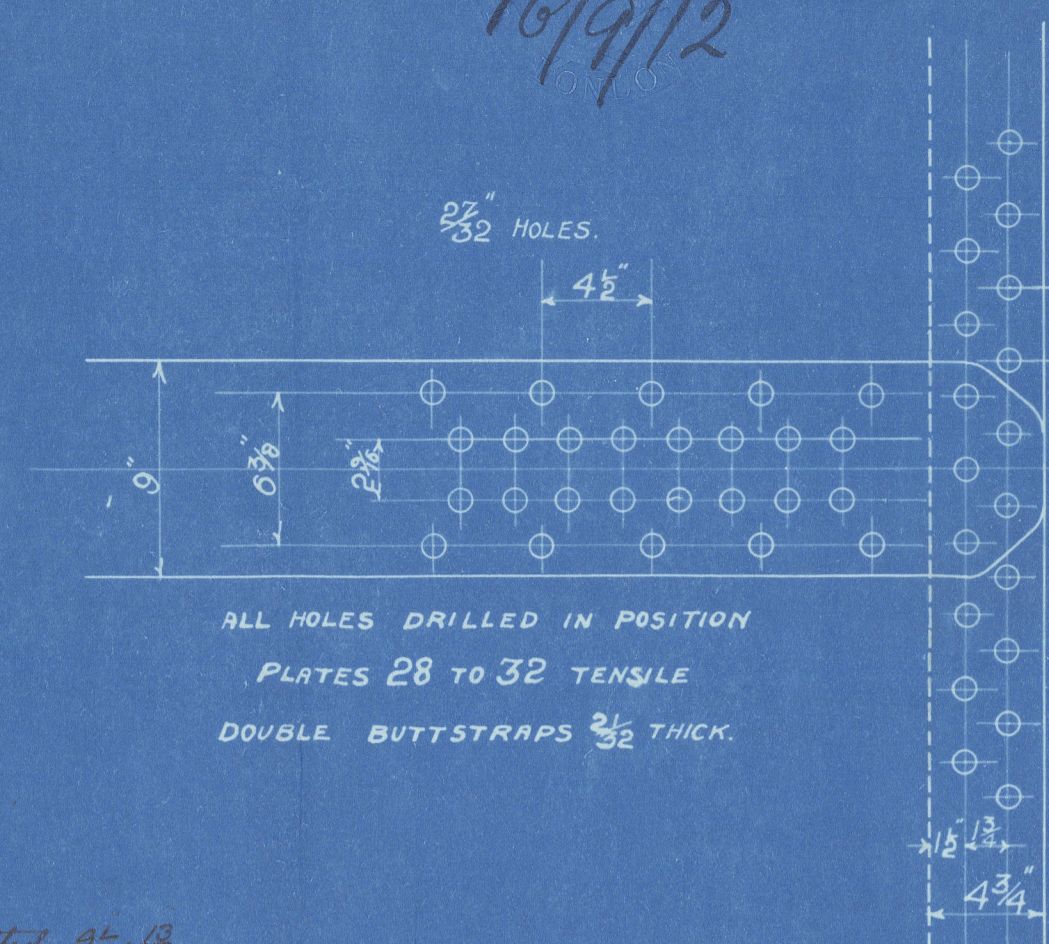

MANHOLE RING RIVETTING.

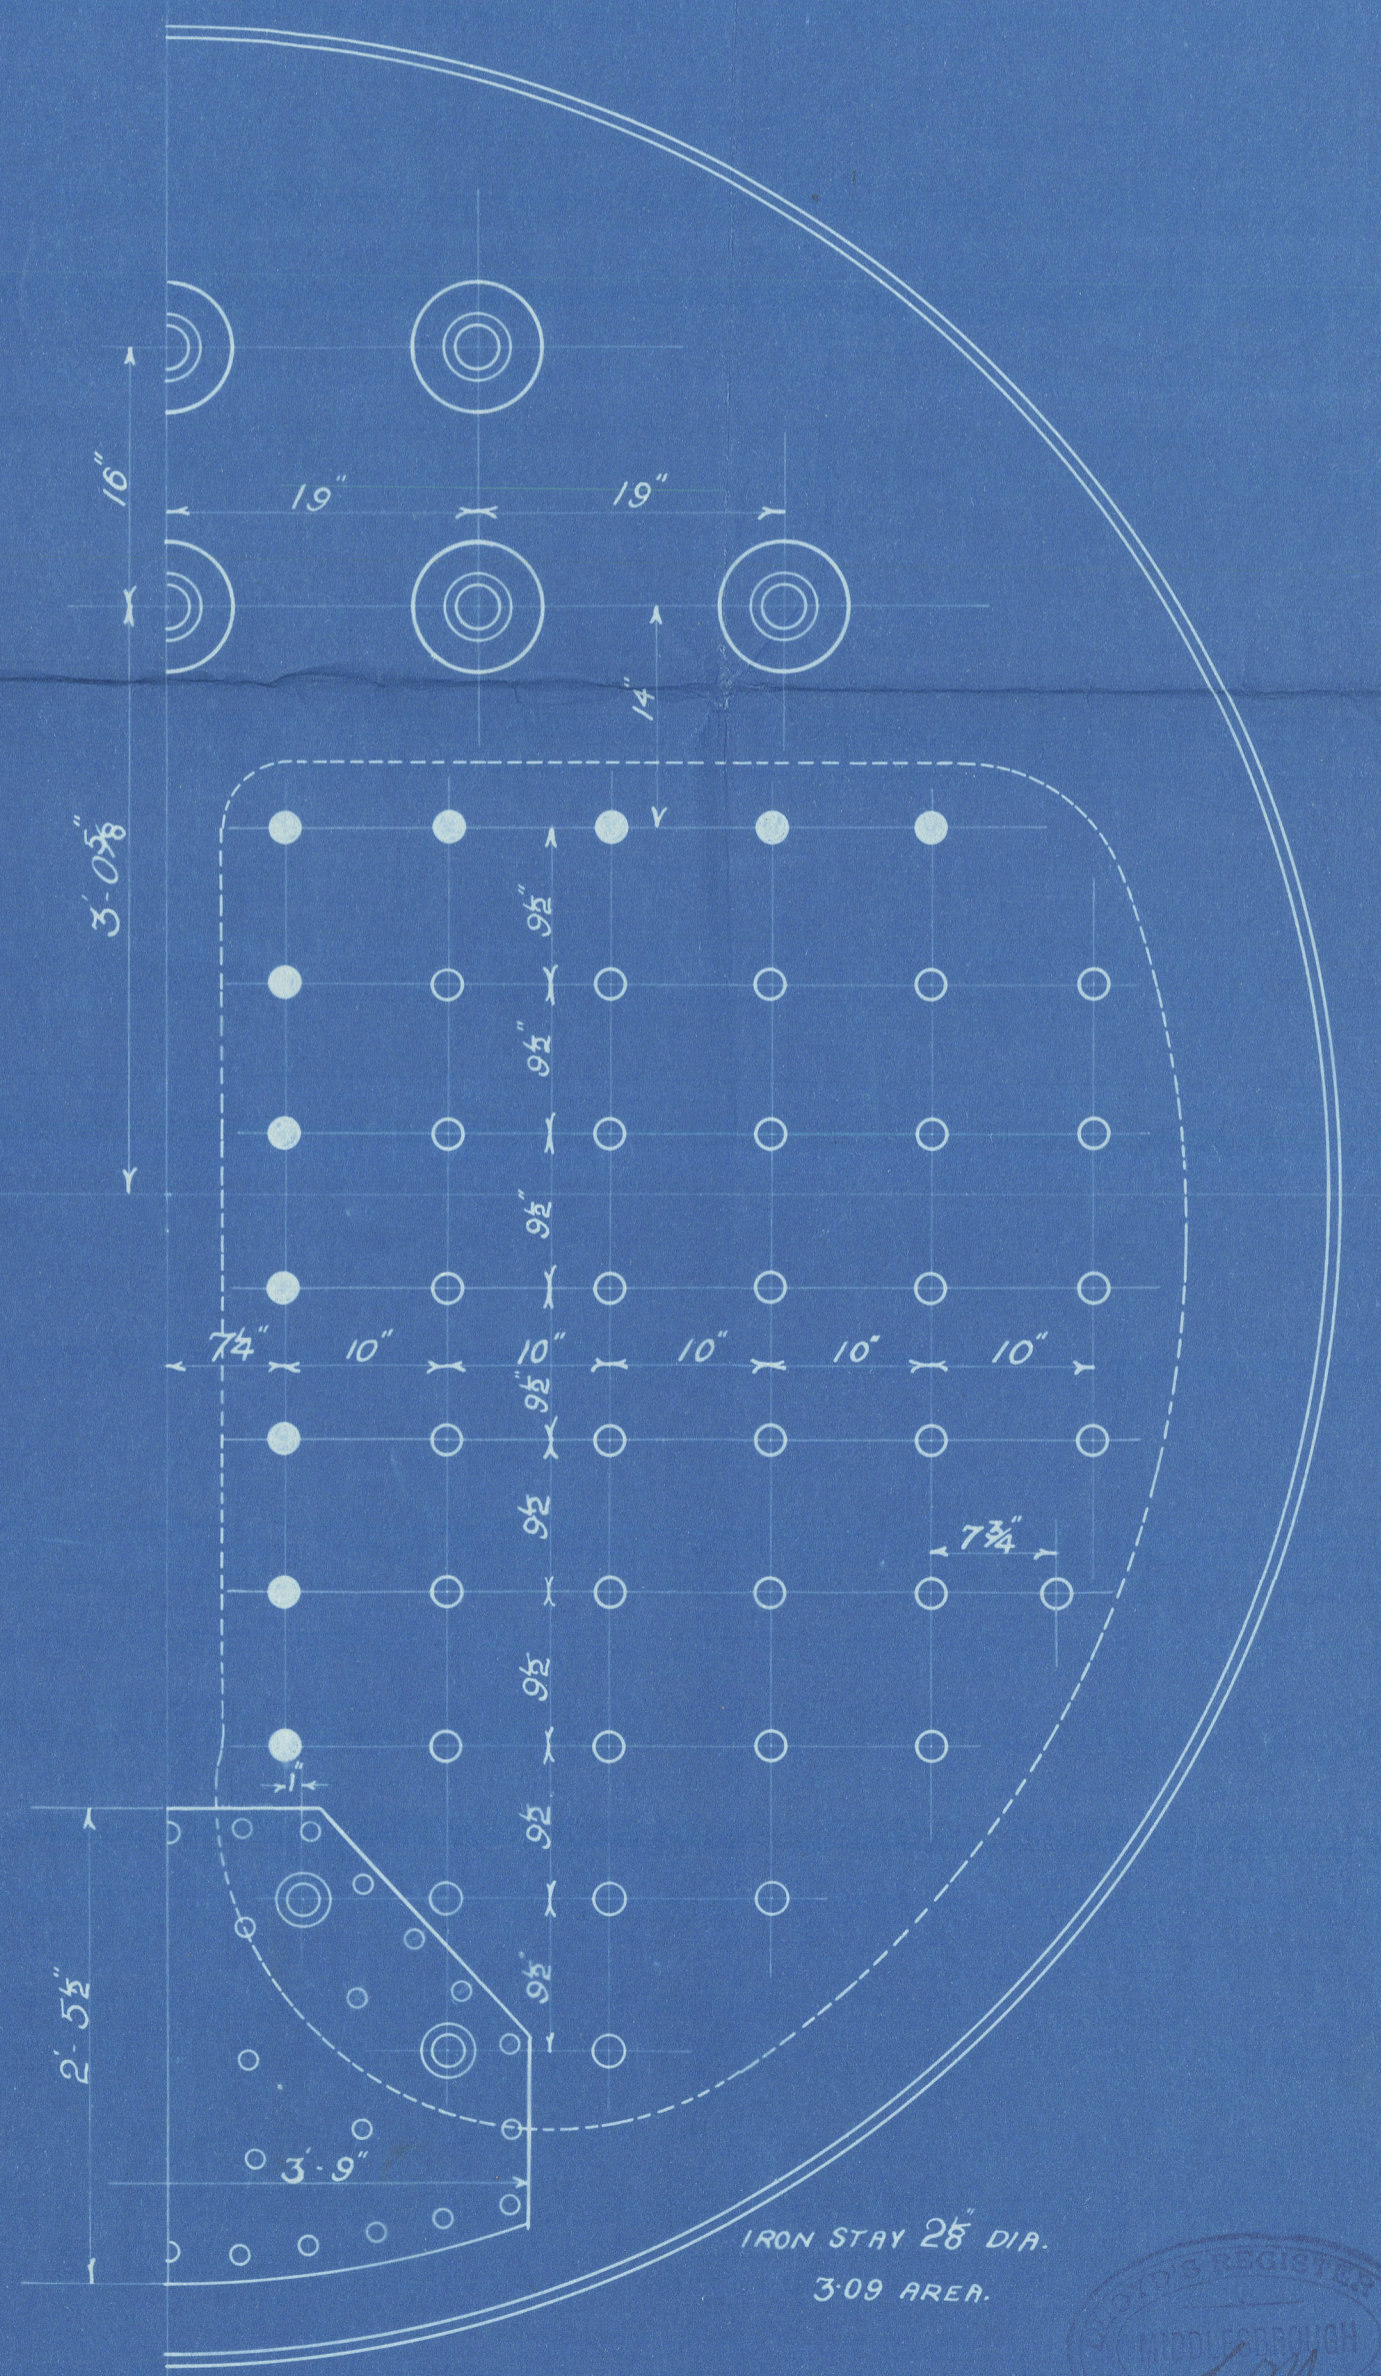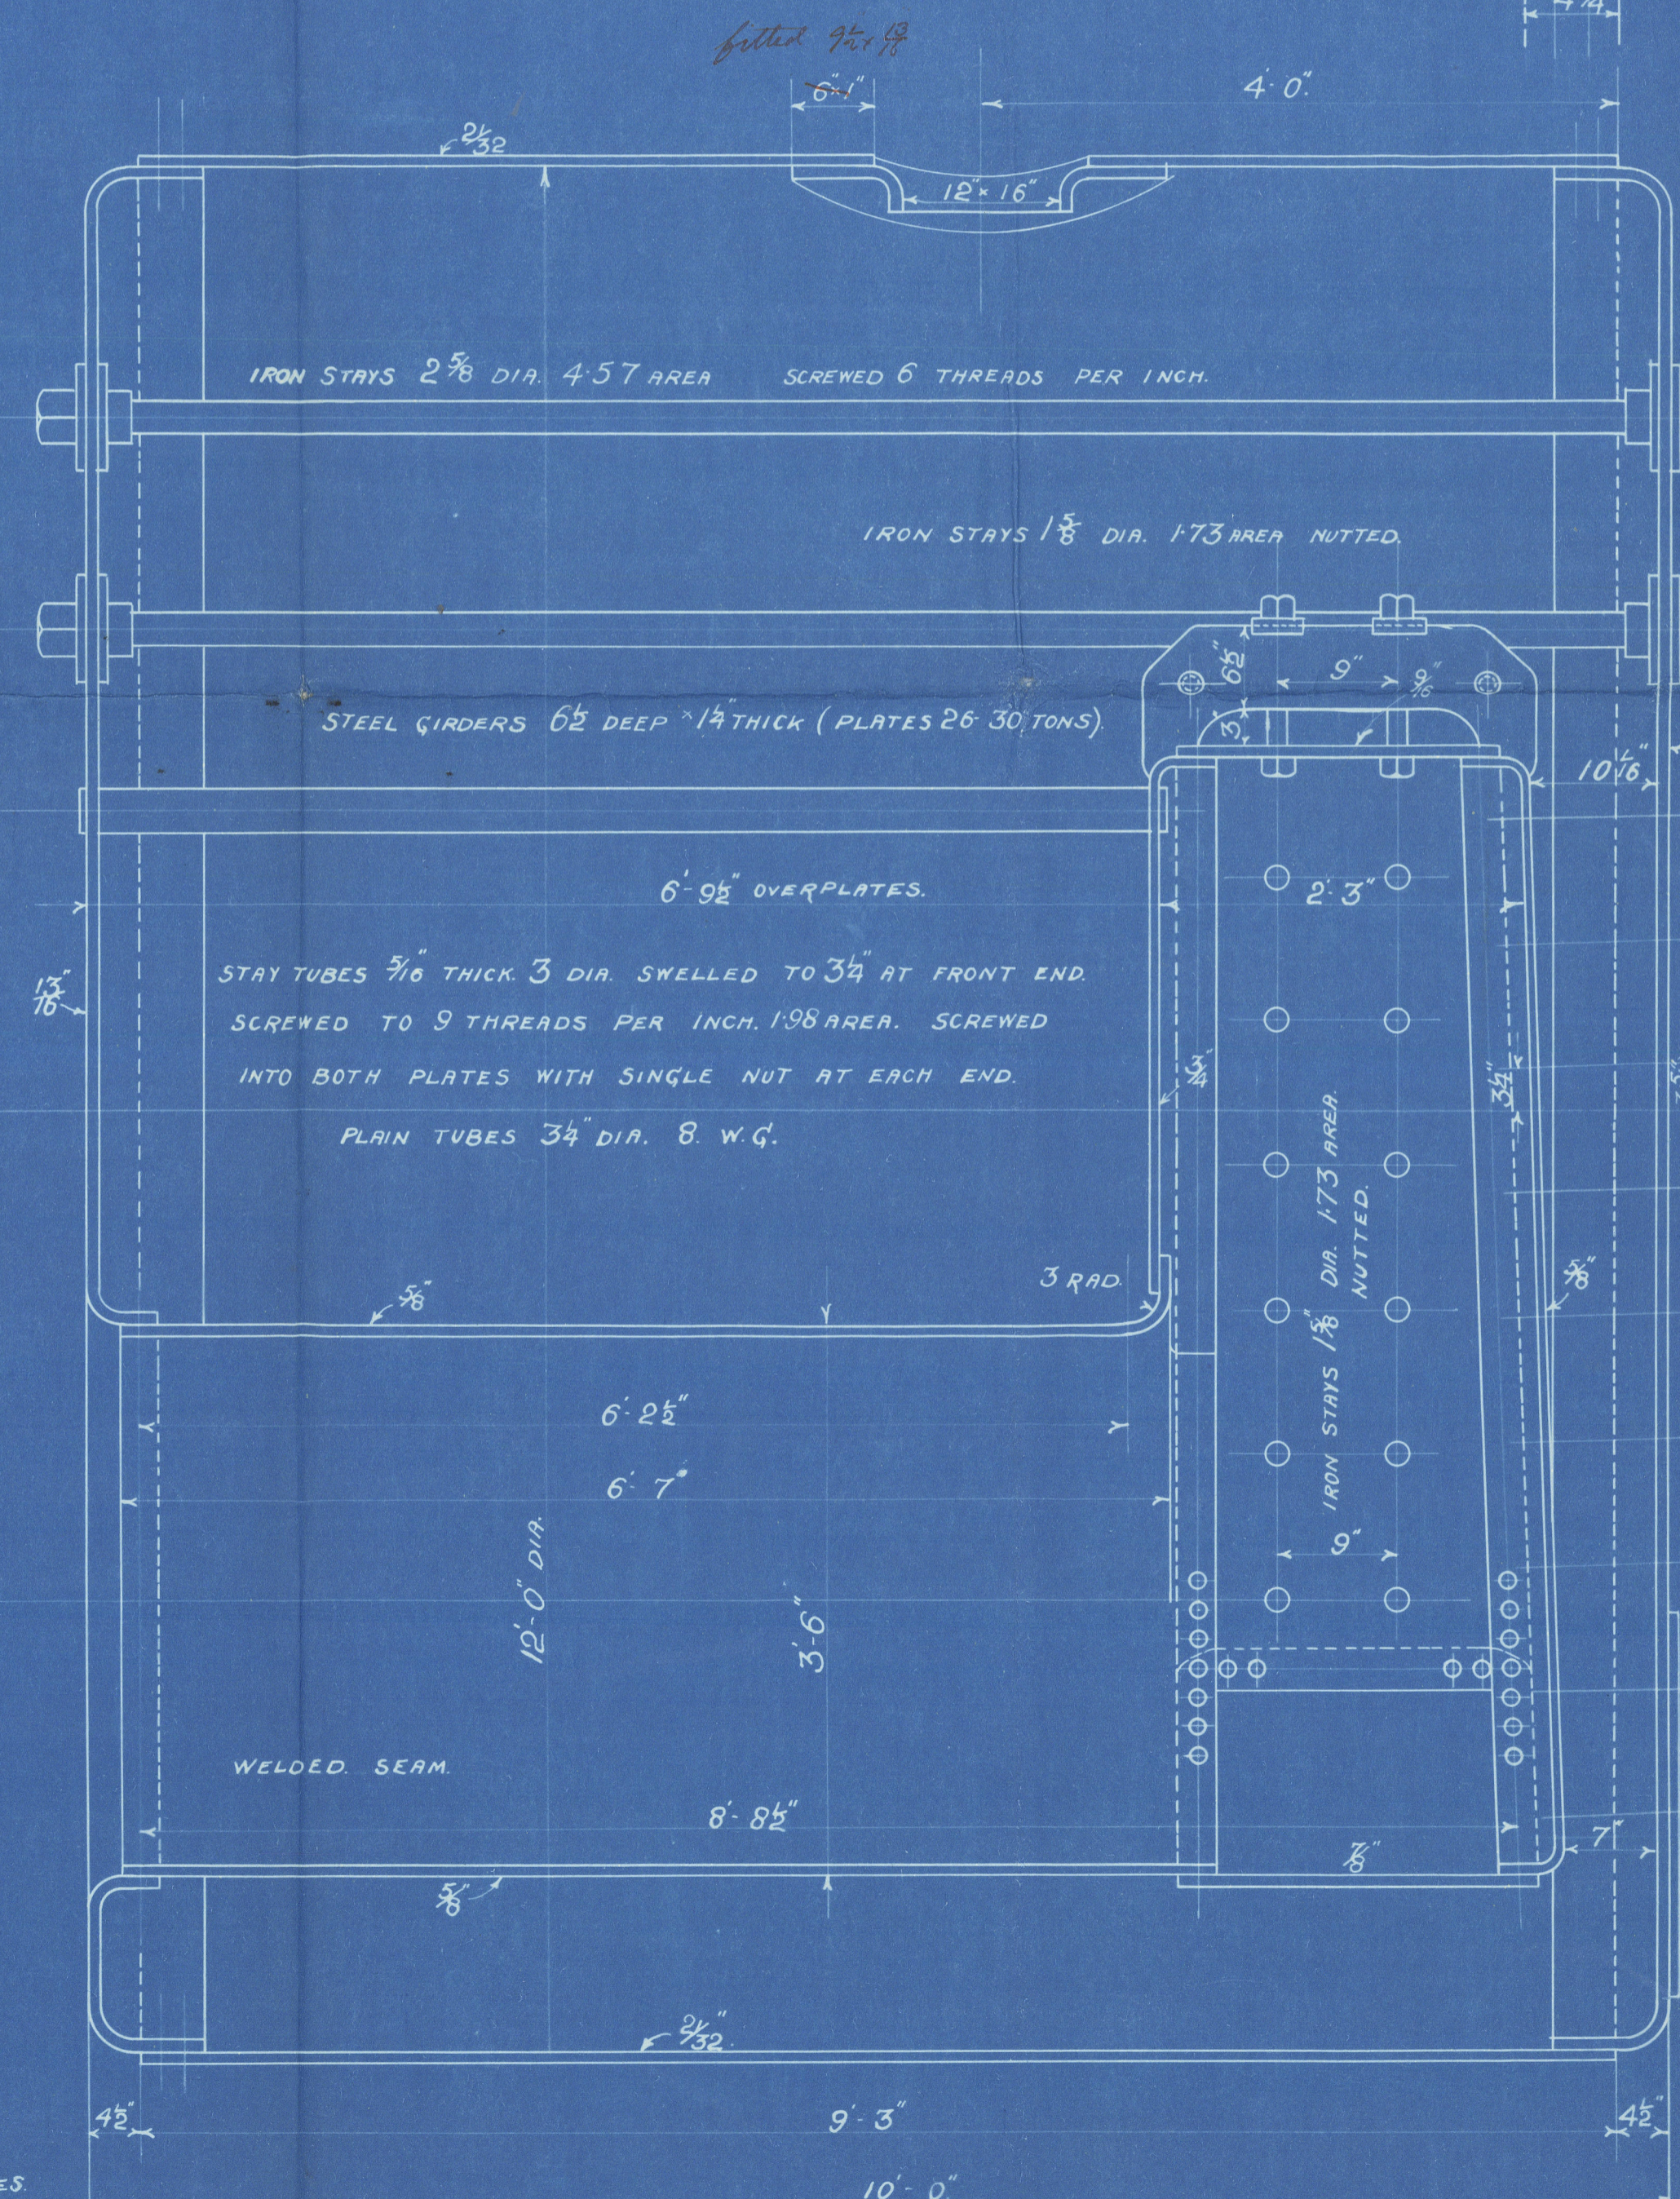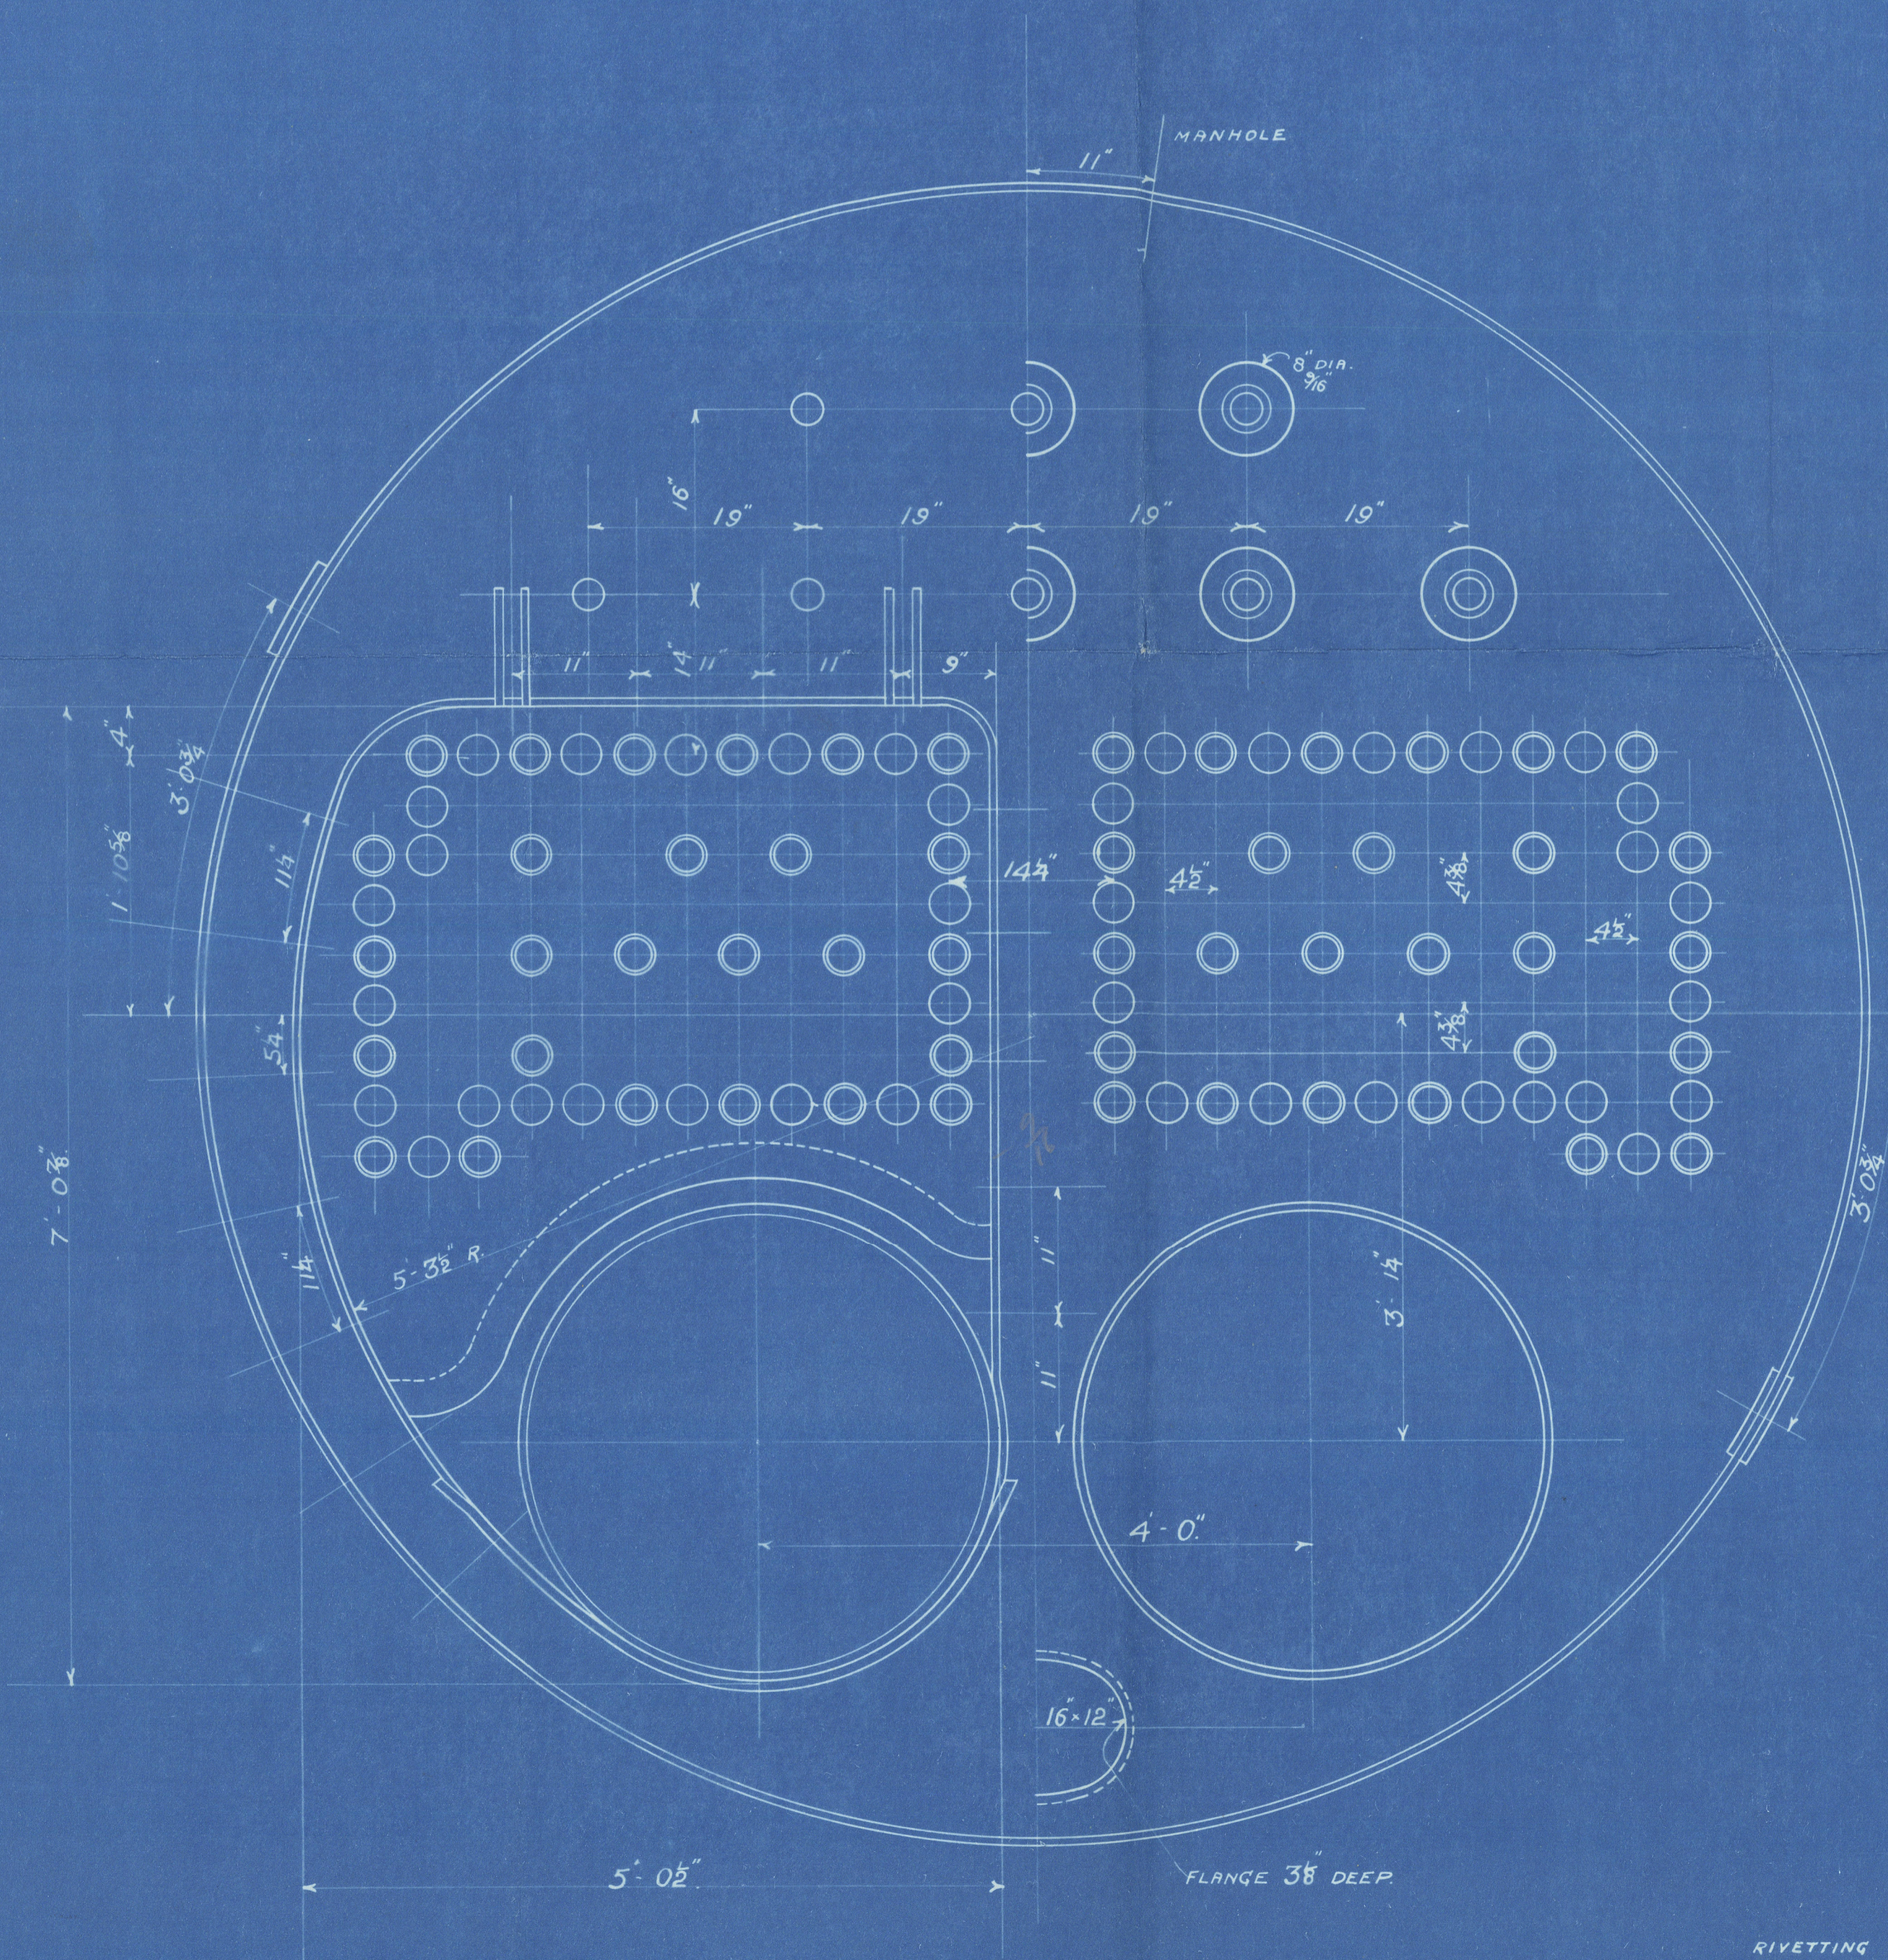

RIVETTING IN C.C. AND FURNACES.
HOLES DRILLED IN POSITION.

HEATING SURFACE 1330 f
GRATE AREA (5'-6" BAR) 37 f

16/9/12

Thames & Mersey Dock

No. 4486

for

Thames & Mersey Dock

S.S. No. 276

Working Press 100 lbs



No. 5097
LLOYD'S TEST
200 lbs.
20.6.13 - W.M.

Midd Report-

No 7990

S.S. Shirley

Sld Rpt No 25823

Duplicate Boiler No 4170

Middlebri' Report No 6783

19-38



© 2020

Lloyd's Register
Foundation

W768-5024