


— DIMENSIONS —

LENGTH BETWEEN PERPS	121'-0
BREADTH MOULDED	22'-0
DEPTH MOULDED	10'-6

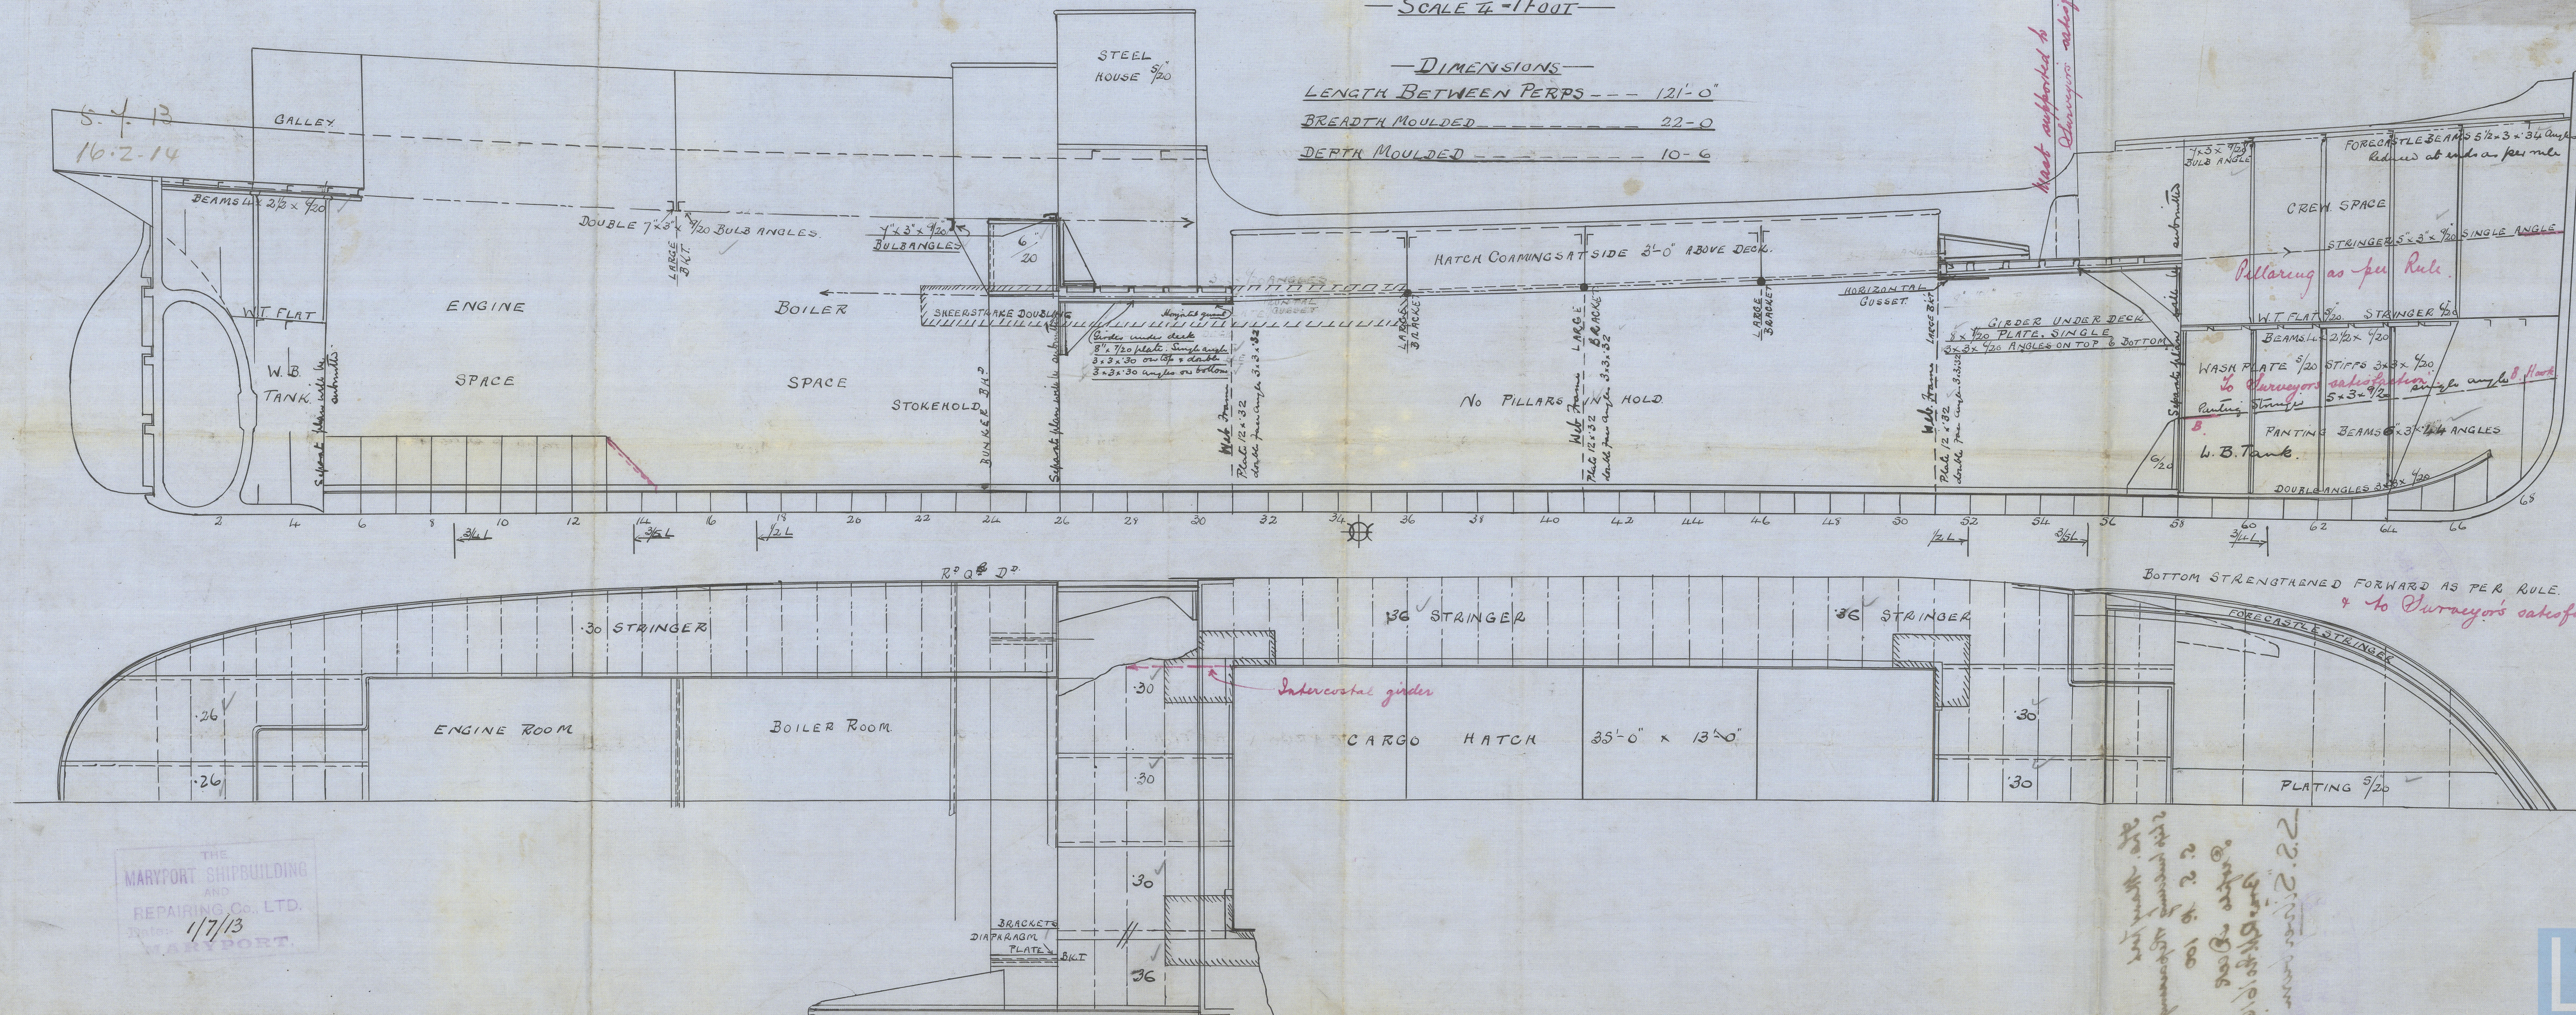

THE
MARYPORT SHIPBUILDING
AND
REPAIRING Co., LTD.
Date: 1/7/13
MARYPORT.

S. S. No. 100

Br. R. H. no 1616

S.S. "Silver burn"

W773-0104
Lloyd's Register
Foundation