

SCALE 1" = 1 FOOT

N° 653

Lloyd's Register
773-0100
Foundation

S.S. Silverburn

GLASGOW REPORT No. 34367

Rw 1616.


Marine Boiler No. 653

11'-0" dia x 10'-0" long
for 130 lb W.P.

Duplicate of No. 499
Glasgow report No. 30026
except that screw stays
are to be of steel, & there
are 4 more tubes.



W.H.P.

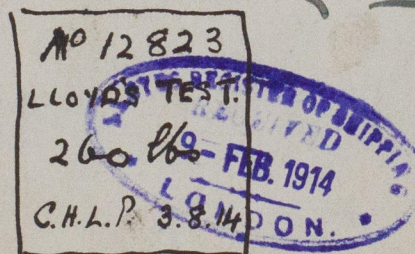

RETAIN



© 2020

Lloyd's Register
Foundation
W773-0106