

# PROFILE S.S. 243.

SCALE  $\frac{1}{8}$ " = ONE FOOT.


## DIMENSIONS

LENGTH B.P. 200'-0"  
BREADTH EXT. 40'-9"  
DEPTH MLD. 20'-0"

JOHN PRIESTMAN & CO

SHIPBUILDERS,  
SUNDERLAND.

*J.P.*  
30.8.13

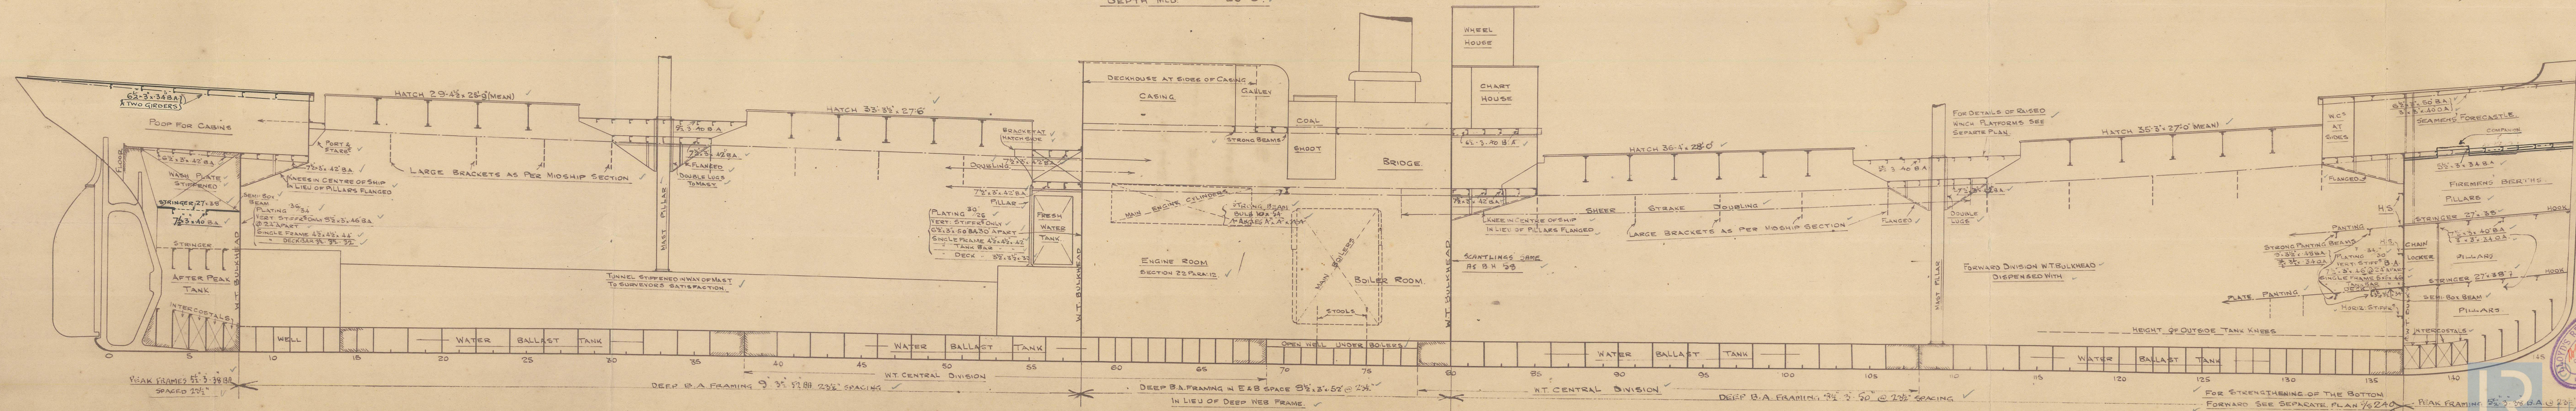

Lloyd's Register  
Foundation  
W775-0093



S.S. "SATRAP"

PRIESTMANS № 243

PROFILE (AS FITTED)

SLD. RPT. NO. 25858

W795-0093

RETAIN

RETAIN



© 2021

Lloyd's Register  
Foundation