


LIST OF SHAPES USED IN THE CONSTRUCTION OF THIS VESSEL

ANGLE BARS
5"x6"x1/8"
5"x5"x1/8" TO .44"
5"x5"x1/8"
4"x3"x1/8"
3"x3"x1/8" TO .35"
3"x3"x1/8" TO .35"
4"x3"x1/8"
5"x5"x1/8"
5"x5"x1/8"

BUILDING ANGLES
10"x13"x3/8"

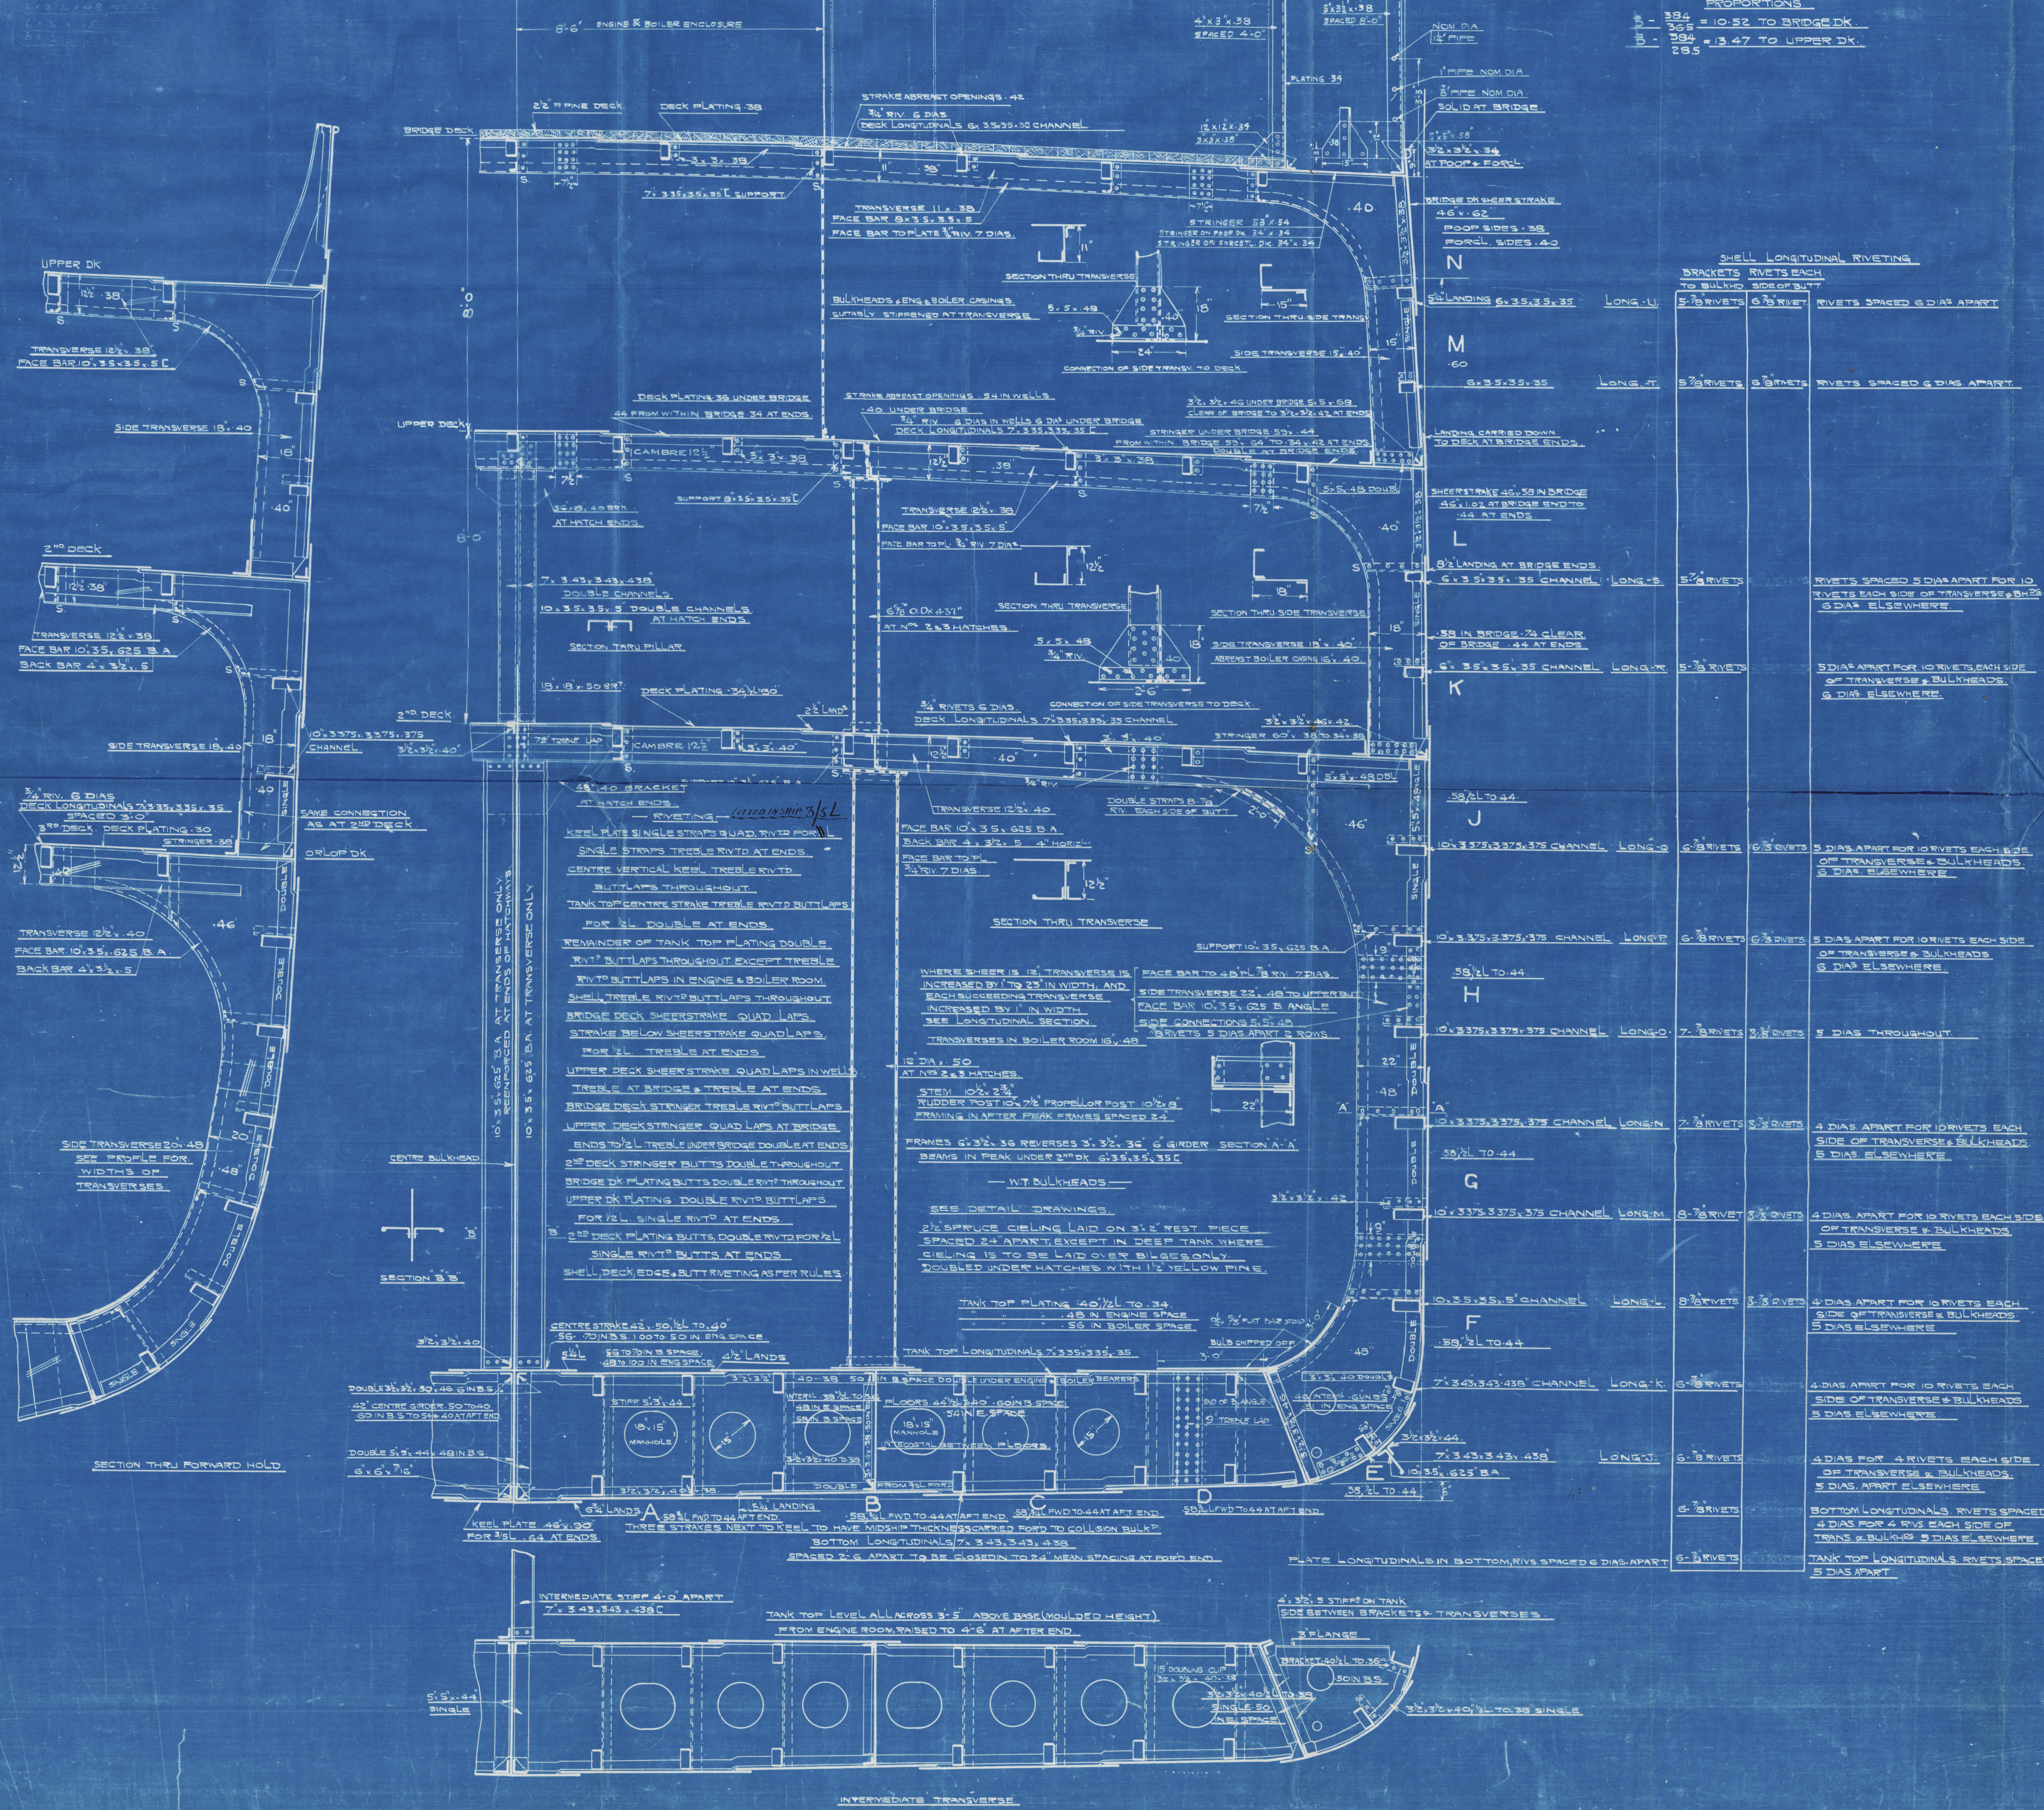

-CHARGES-

MATERIAL ORD. OUTS. OR. TAKEN FROM STOCK.

DATE	DESCRIPTION	APPROVED
4-9-12	DRAWING BROUGHT UP TO DATE	
6-11-12	PIPE RAIL FITTED INSTEAD OF TANK RAIL ON BRIDGE DECK	
	QUAD PLATE IN 1/2" DECK BOTTOM TOWARD TOWEL	
	QUAD PLATE IN 1/2" DECK BOTTOM TOWARD TOWEL	
DATE	DESCRIPTION	APPROVED
3-23-12	BLUE PRINTS	
3-23-12	BLUE PRINTS	
THE WM. CRAMP & SONS S. & E. B. CO.
PHILADELPHIA, PA. OFFICE CONSTR. DEPT.
HULL No. 303
CARGO STEAMER FOR W. R. GRADE & CO.
GENERAL CROSS SECTION

SCALE 1/2" = 1' MOST
H.L. L.D.C. G.M. MARCH 15 - 1912
DATE 3-23-12. NO. 42003

Rec. from No. 42003, approved by Lloyd's
March 1-1912
Approved Section
12/8/12


Copy
Anecdote
Approved Manuscript Section
Nº 393
Wm Cramp & Sons (Phila)

"Barbara" ex - S. P. Santa Cruz -
Report Nº 1992

PHILADELPHIA.

W8-0058



© 2020

Lloyd's Register
Foundation