


21.001

LLOYDS NUMERALS  
B + D = 77.5  
L x (B + D) = 28287

— N° 1122 —  
PROFILE AND DECK PLANS

DIMENSIONS - LENGTH B.P. 365'-0" x 48'-9" B.M. 4" x 28'-9" DEPTH 11'4"

ISHERWOOD SYSTEM  
SCALE 1/8" = 1 FOOT

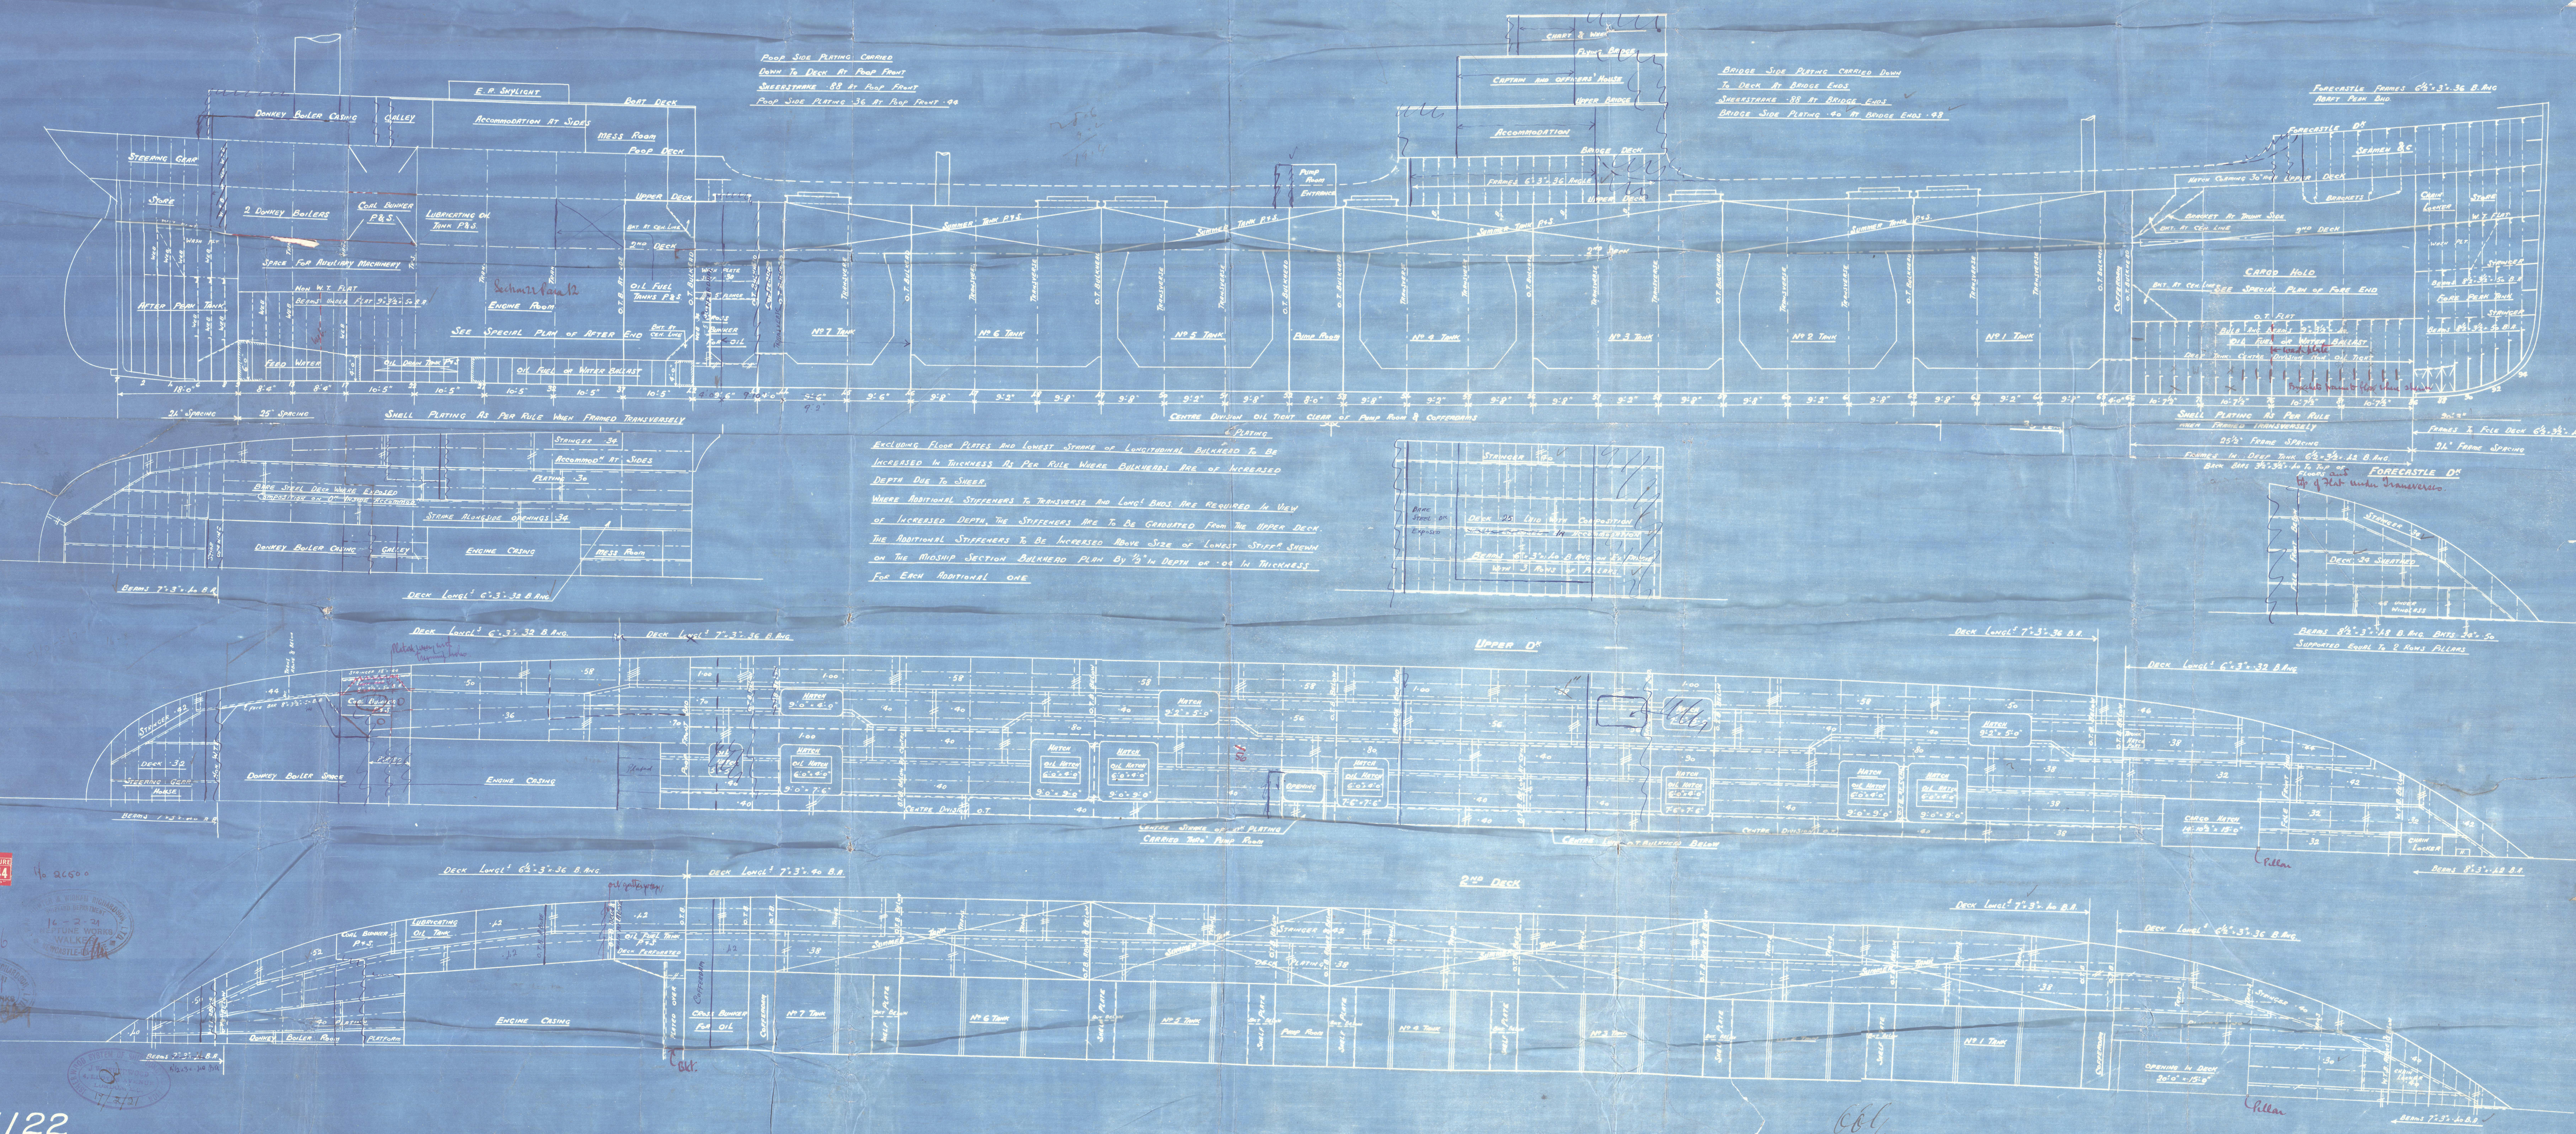


ENCLOSURE  
N° 944  
16-3-34  
N° 26676  
16-3-34  
N° 26676  
16-3-34

1122  
Plan No 640



No 1122  
Profile

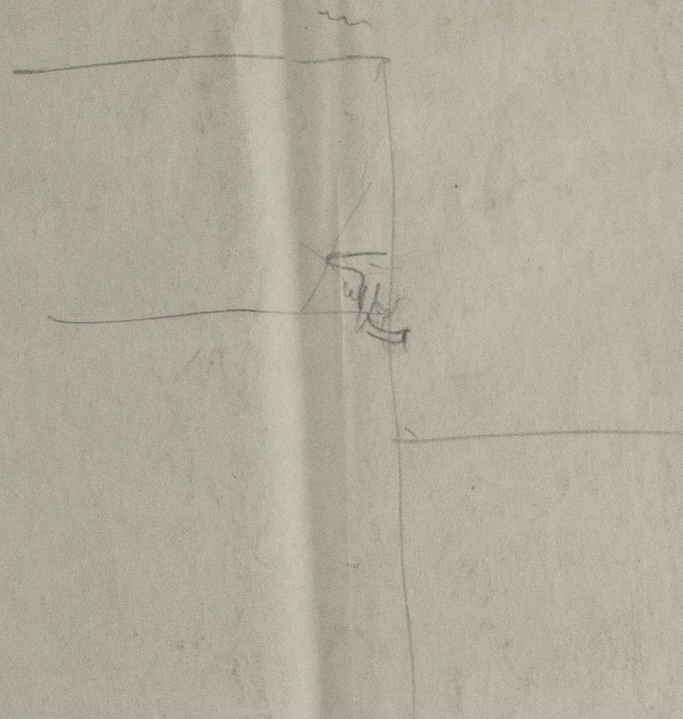

w8-0180



© 2020

Lloyd's Register  
Foundation



Swan Hunter 1122

Profile & decks

AMENDED PLAN

PLAN No 16

Badalona

S. S. "Arms" ex

NEWCASTLE ON TYNE.

Report No. 177086

W18-0180



© 2020

Lloyd's Register  
Foundation