

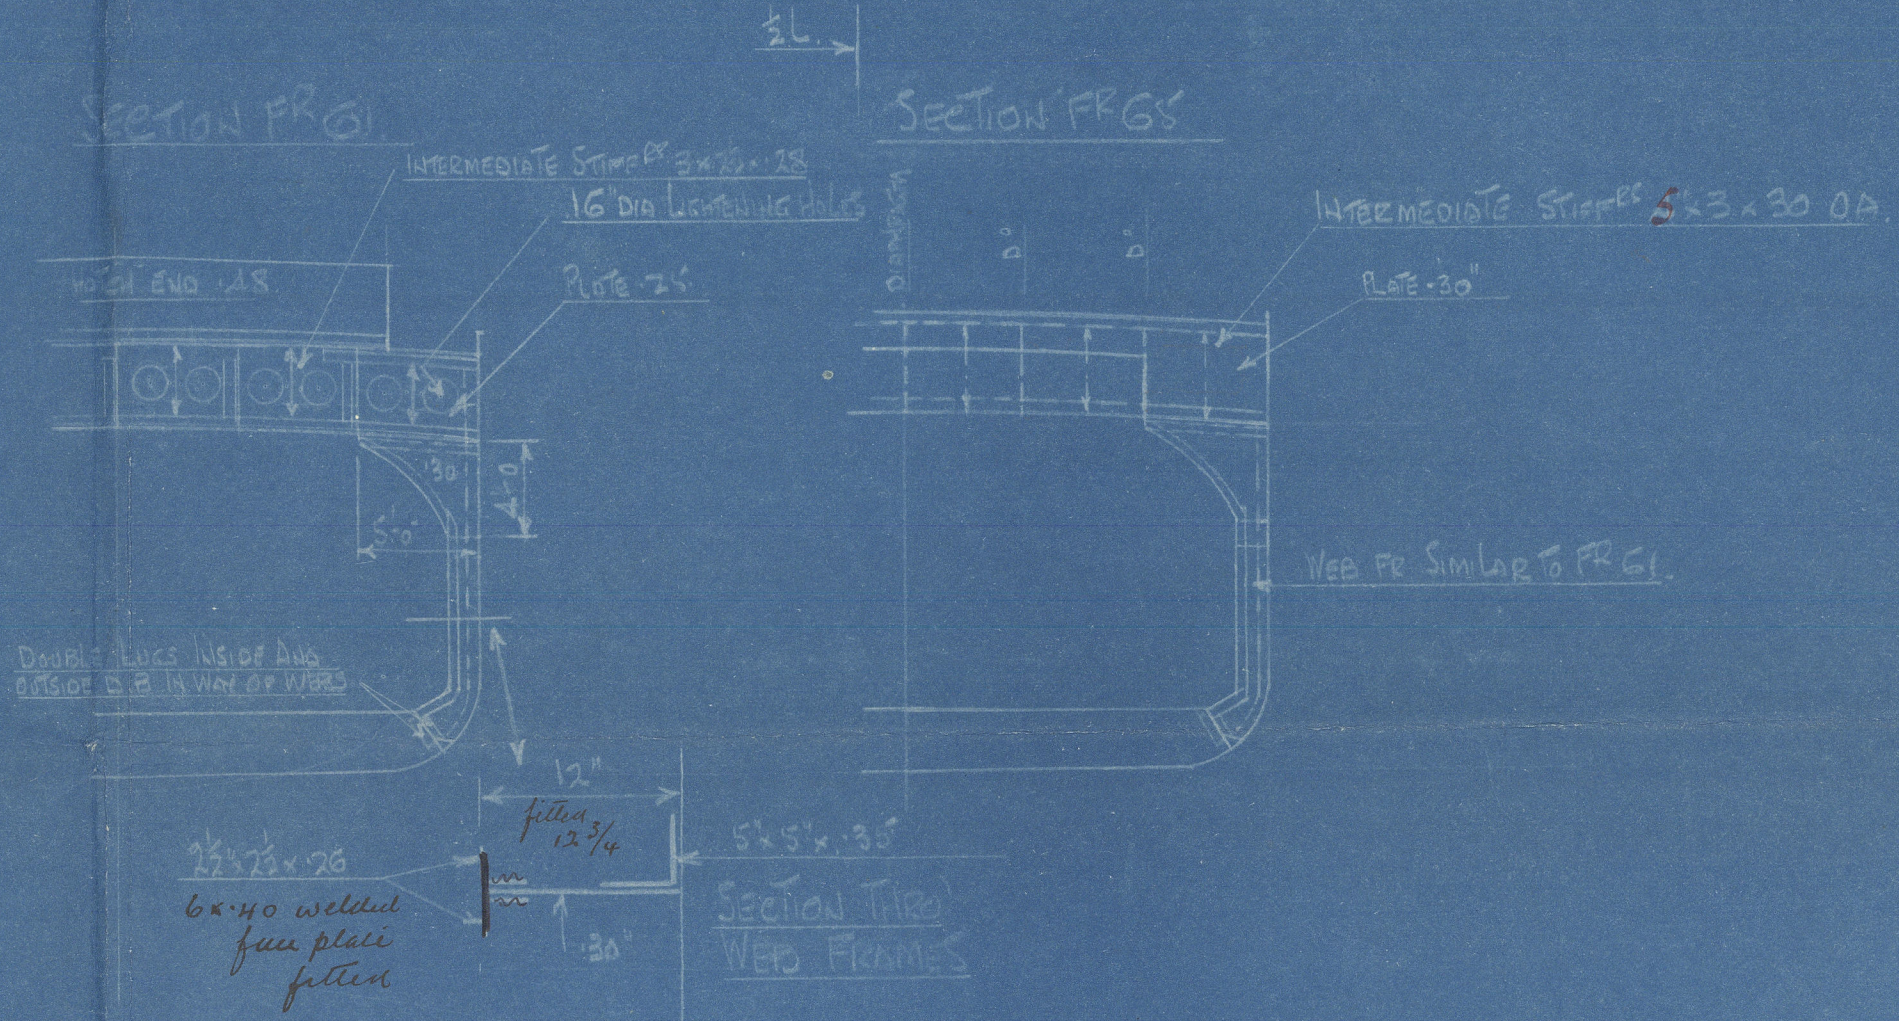
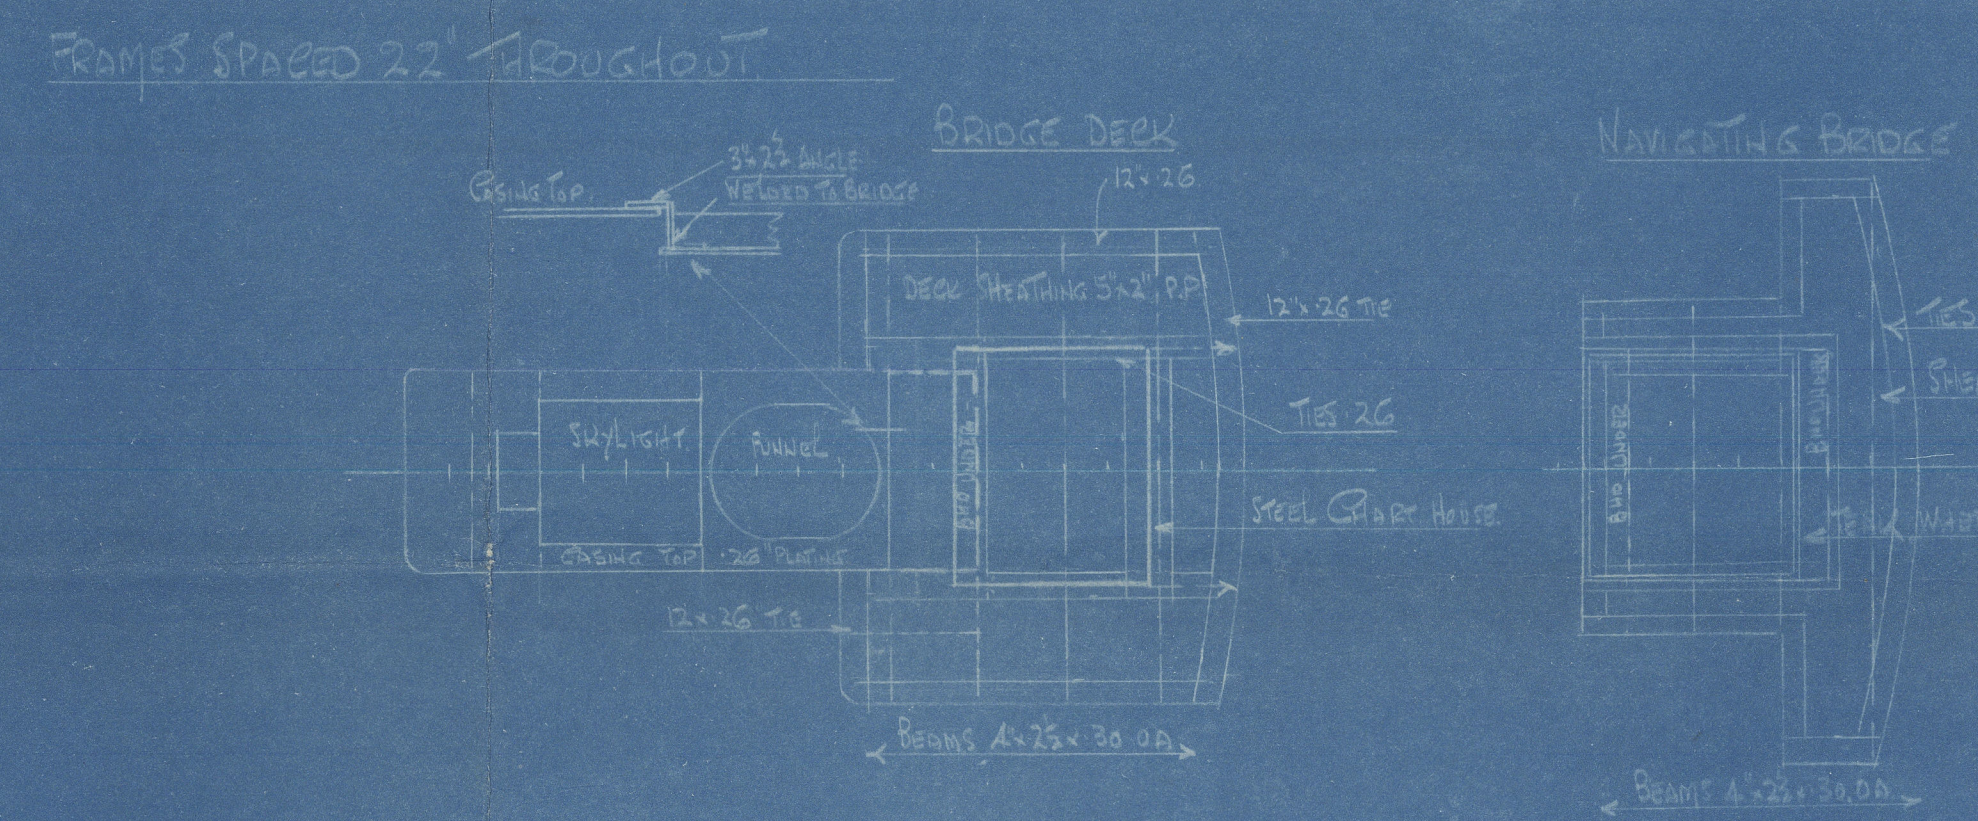
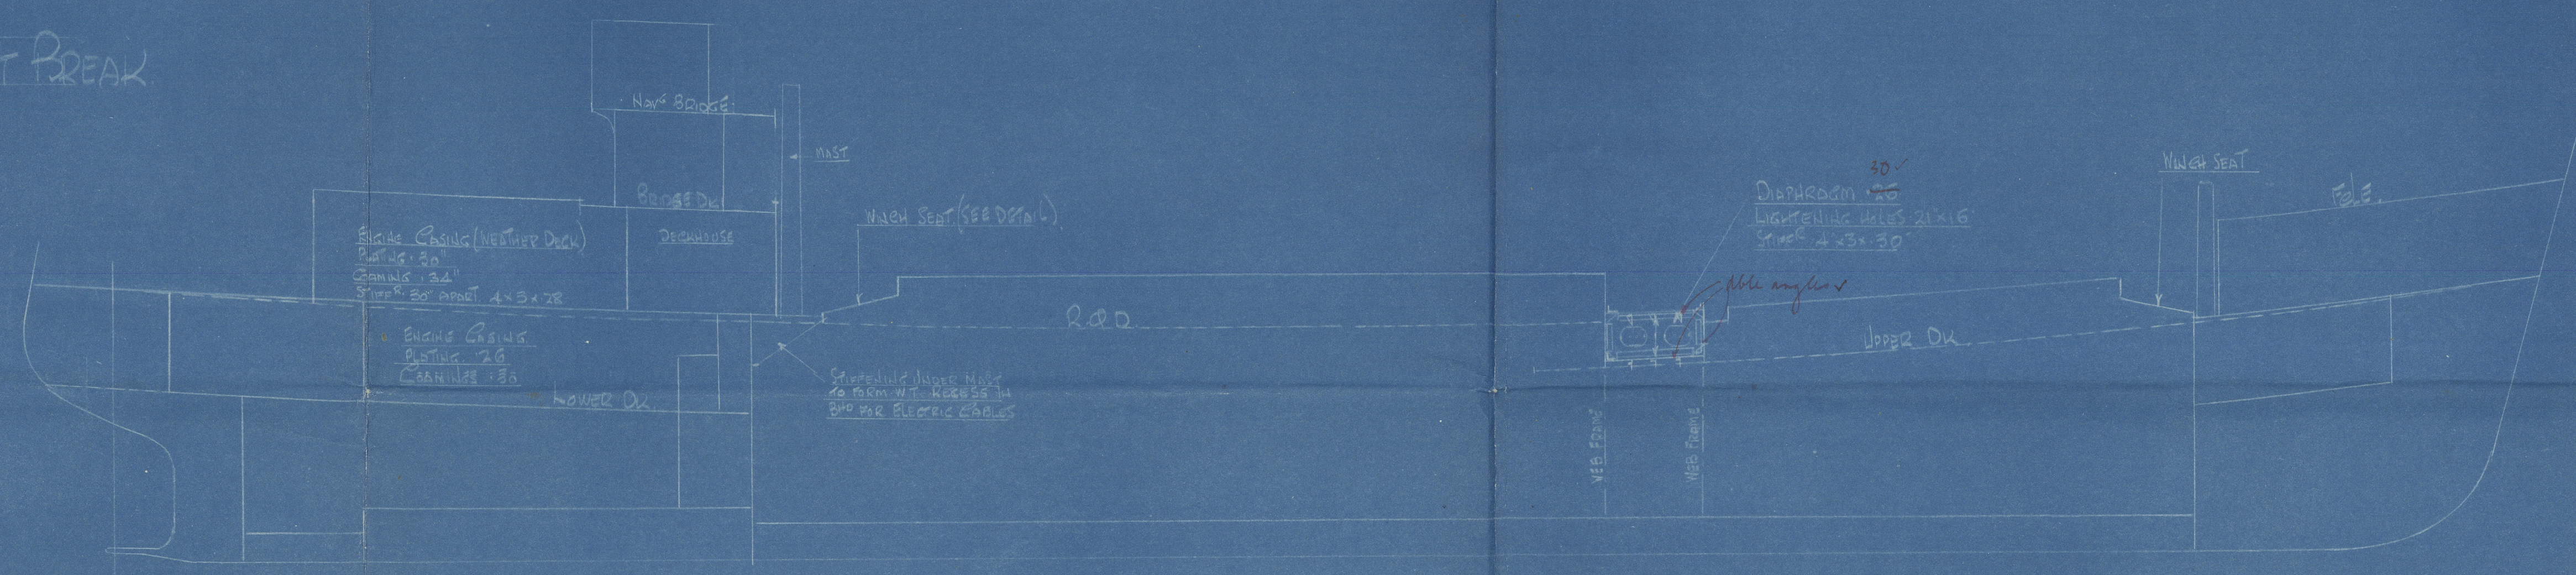
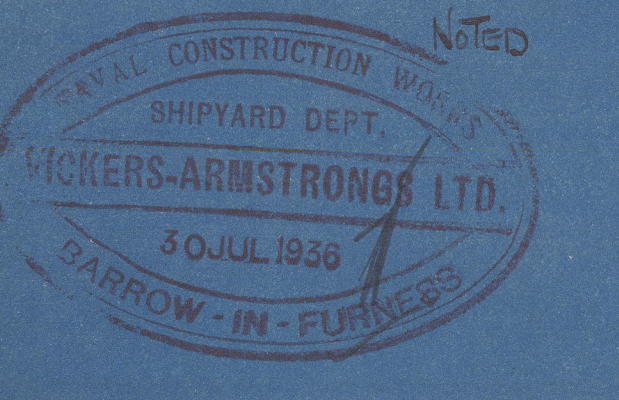



29736 No 726
 DECK PLANS AND STRENGTHENING AT BREAK
 SCALE 1/8" = 1 FOOT

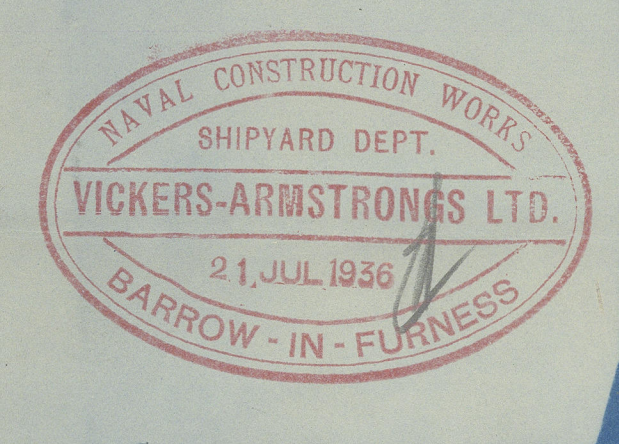


STRENGTHENING OF SHELL AT BREAK
 SCALE 1/4" = 1 FOOT

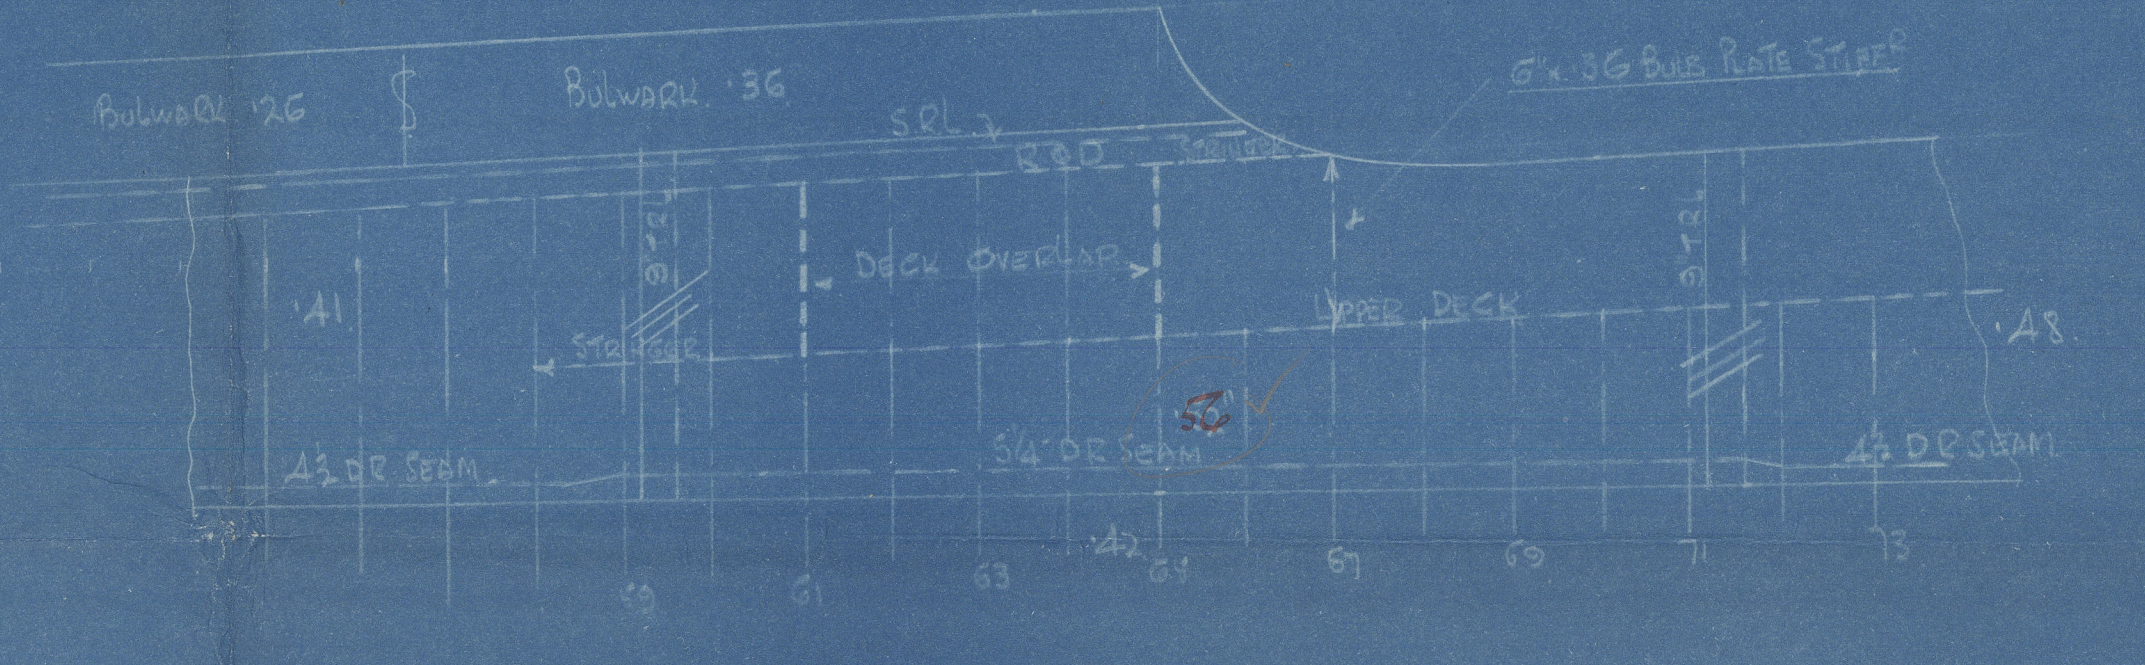


RAISED QUARTER DECK
 CAMERA 7 N 30-0

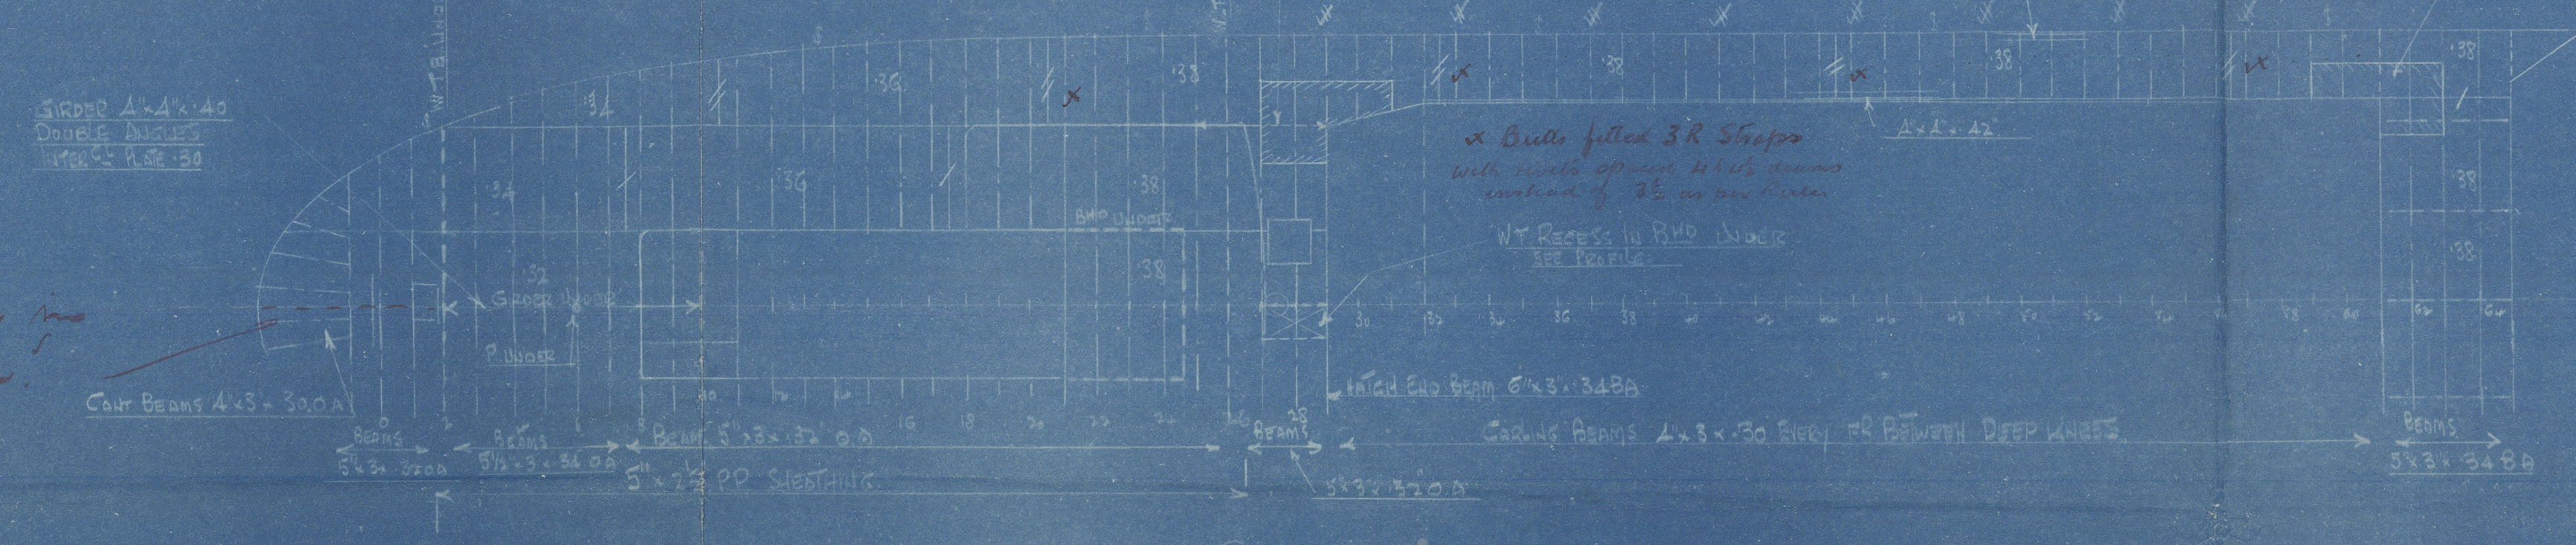



FORECASTLE

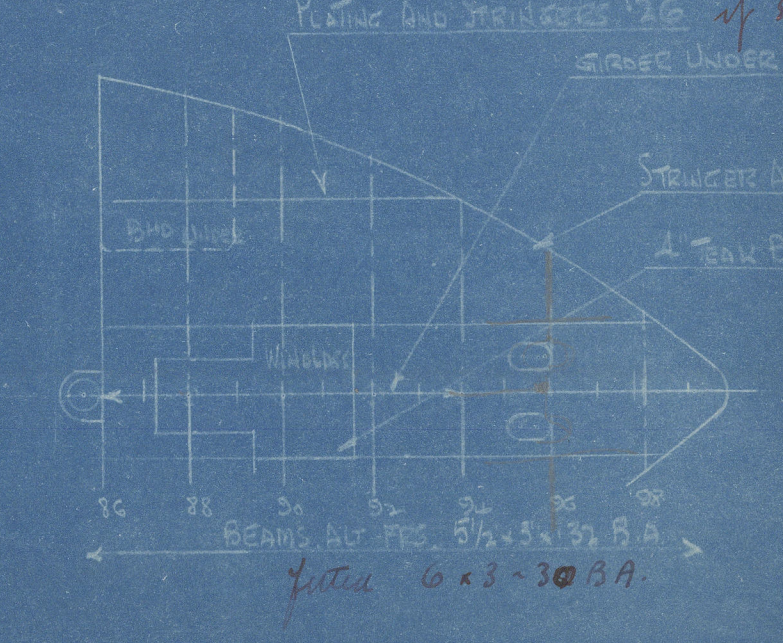

HATCH FUS IN WAY OF VINCH SEATS
 SCALE 1/4" = 1 FOOT

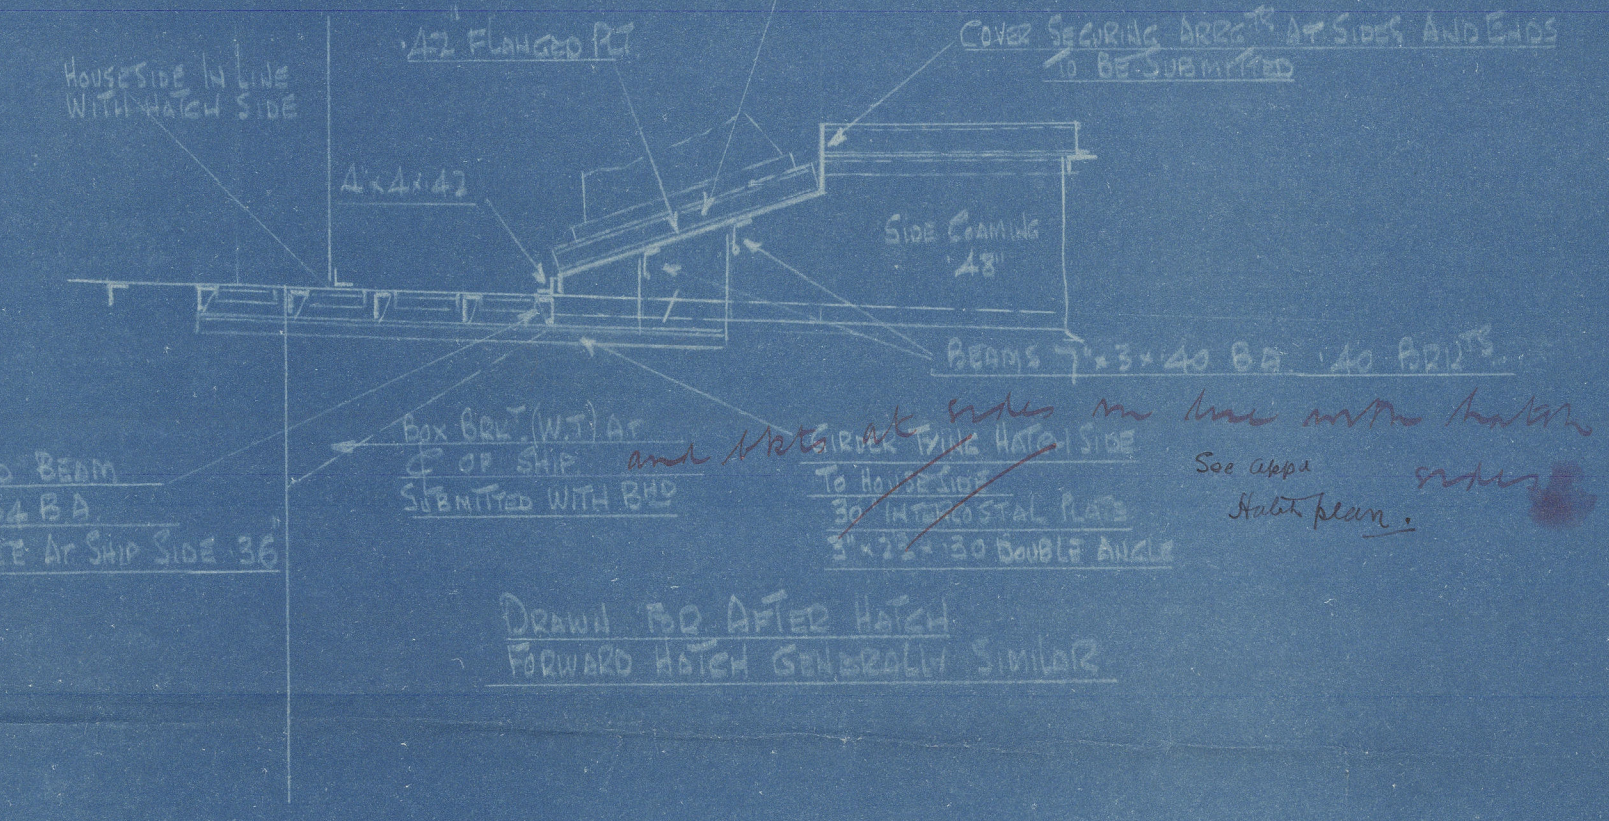

LOWER DECK CAMERA 7 N 30-0

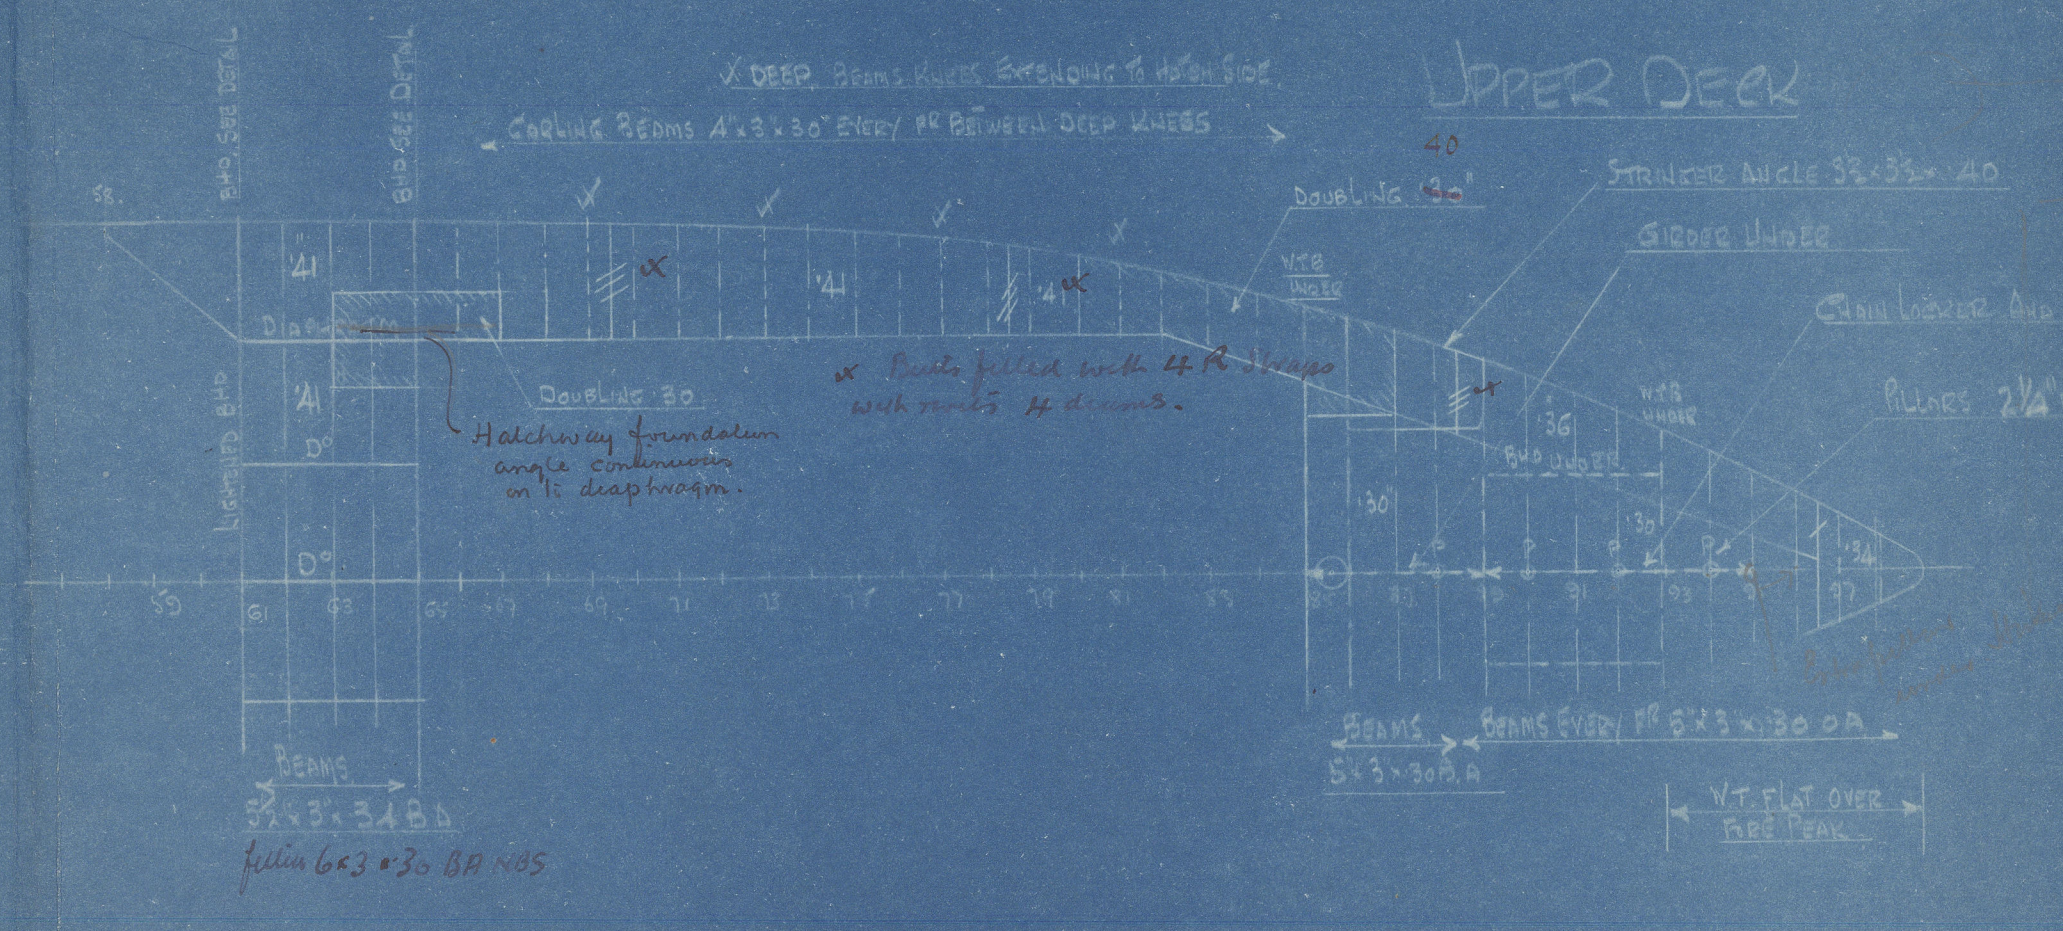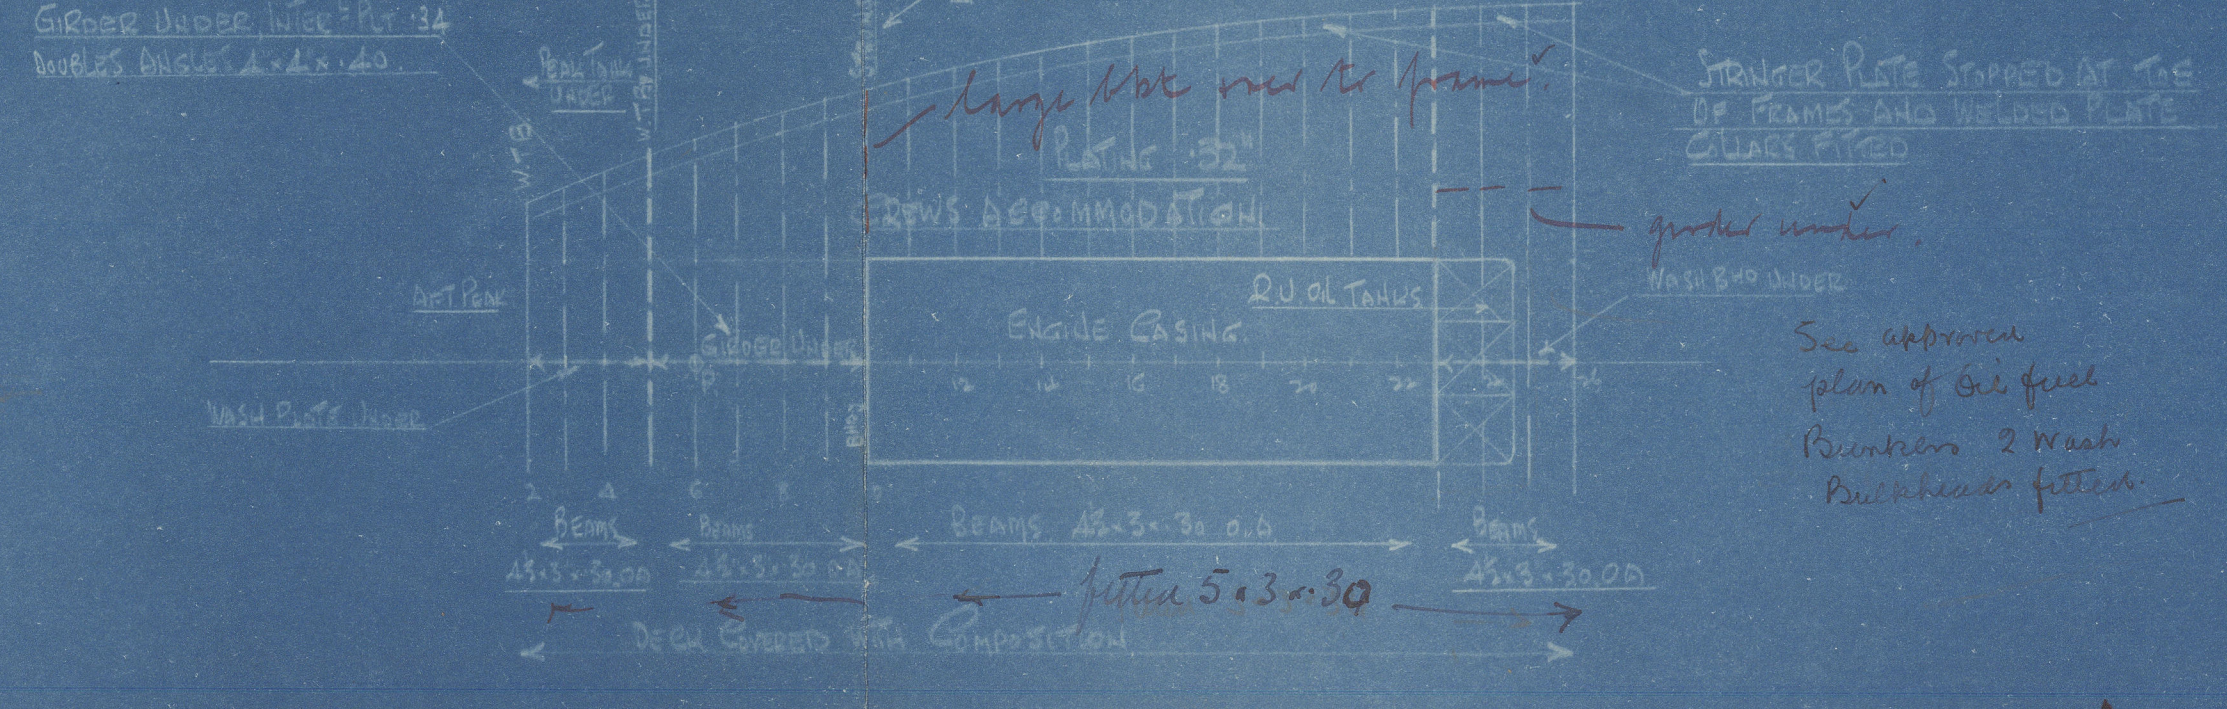

PLAN No 6

Vickers Armstrongs

726

Deck plans & Strengthening
at Break

SHOAL FISHER
BARROW REPORT NO 2645



© 2021

Lloyd's Register
Foundation

W81-00916