

1. 10.00

SCALE  $\frac{1}{25}$


<u>HALF GIRTH</u>	37 <sup>1</sup> / <sub>2</sub>	
<u>HALF BREADTH</u>	19 <sup>1</sup> / <sub>2</sub>	
<u>DEPTH MOULDED</u>	21 <sup>1</sup> / <sub>6</sub>	
<u>ROUND OF BEAM.</u>	0 <sup>1</sup> / <sub>8</sub>	
	79 <sup>1</sup> / <sub>2</sub>	N <sup>1</sup> / <sub>2</sub>
	279 <sup>1</sup> / <sub>8</sub>	
	22 <sup>3</sup> / <sub>8</sub>	N <sup>2</sup> / <sub>2</sub>

$$\frac{L}{D} = 12'47$$

HALF GIRTH.....	37.61	POOP.....	29'
HALF BREADTH.....	19.92	BRIDGE.....	54'
DEPTH.....	22.44	FCSTLE.....	30'
	79.97		$\frac{1113 \times 22.378}{279.83 \times 8} =$
LENGTH.....	279.83		
	22.378		1.128
		EQUIPMENT.....	23.506 ✓

EQUIPMENT = 23.506

	2 BOW ANCHORS EACH	37 1/2 CWT'S STOCKLESS
	1 " "	31 3/4 "
	1 STREAM " "	9 " " EK STOCK
	1 KEDGE " "	4 " "
260 FATHS	STUD CHAIN CABLE	1 1/8 DIA "
75 "	STREAM CABLE	4 " STEEL WIRE
90 "	" "	3 1/2 "
2 OF 90 "	" "	2 " " EQUIVALENT STRENGTH GHEMP HAWESERS
2 OF 90 "	" "	1 3/4 " " EQUIVALENT STRENGTH

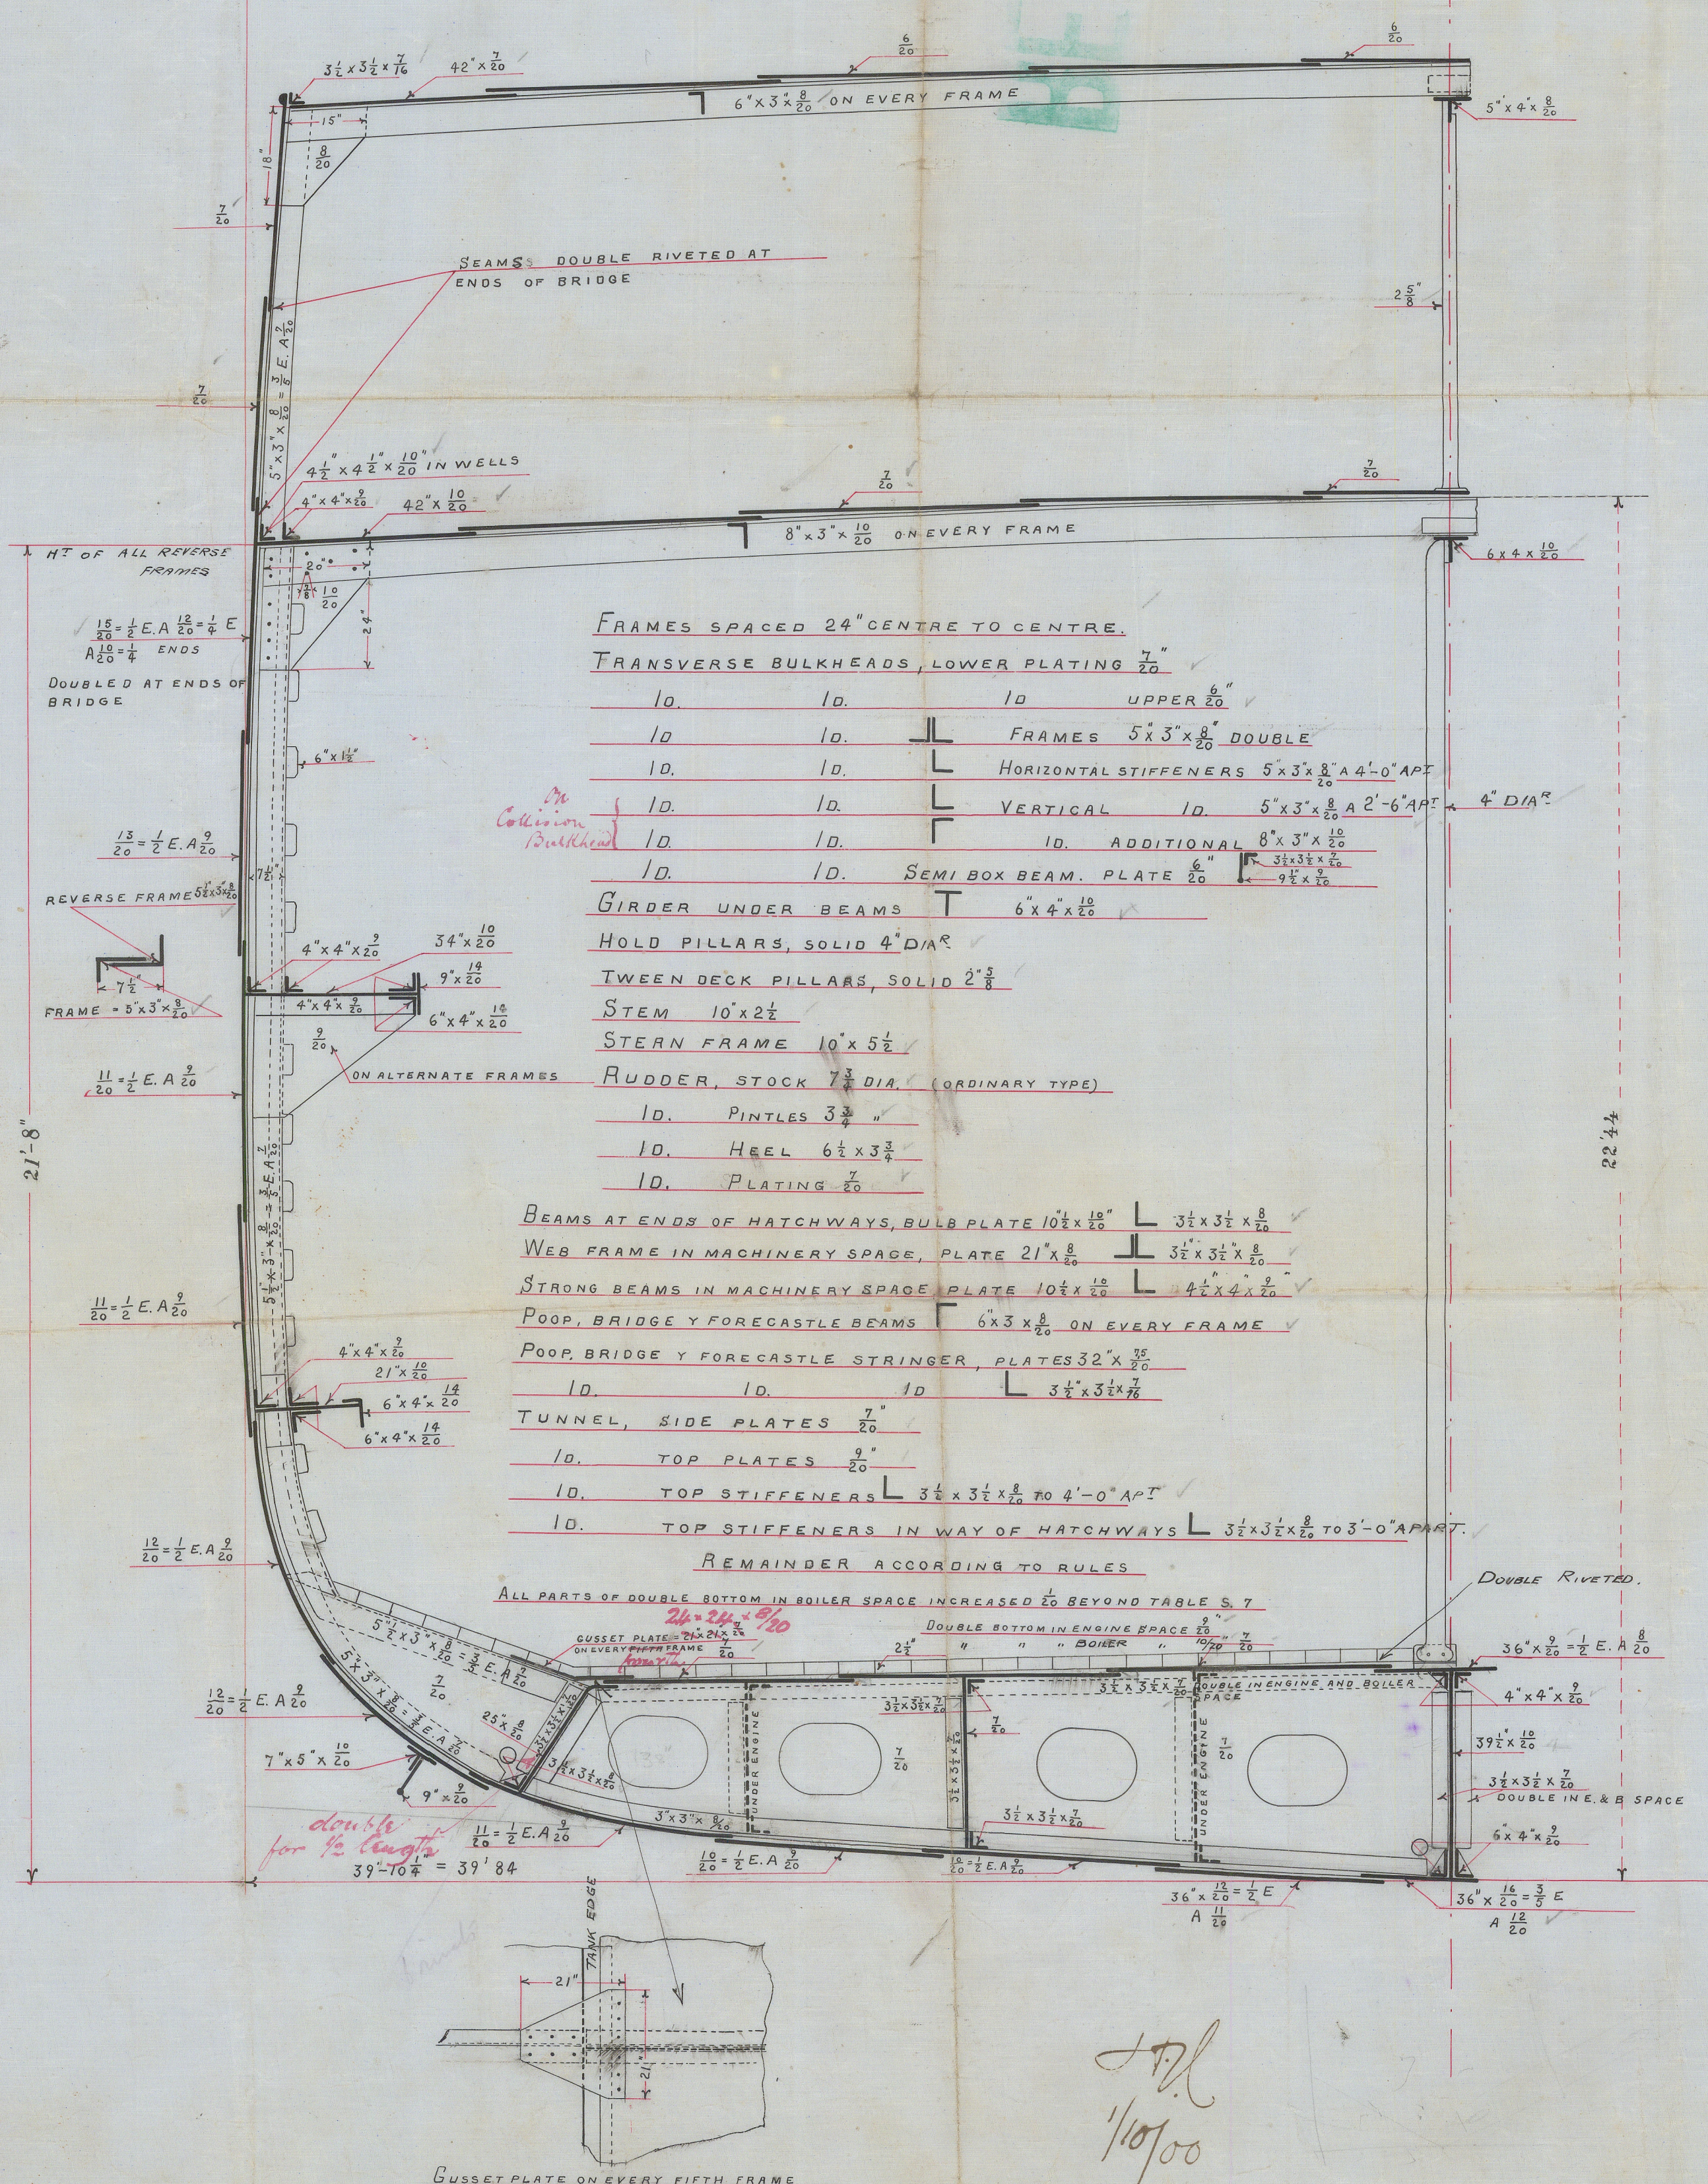

RIVETING TO BE AS PER  
SECTIONS 20 AND 21 OF RULES.

Circulars  
44012 - 1026 to  
be complied with

LA CONSTRUCTORA NAVAL ESPAÑOLA

CONCEPTO T

Nº 56 - Sección B

22 de SETIEMBRE 1900



RECEIVED  
28 MAR 1902  
LONDON

WITH ONE DECK

© 2021

Lloyd's Register  
Foundation