






BOILERS No 209.210. FOR S.S. 17th 23 & 24 built by LA Constructora Naval Espanola, Cadiz.

WORKING PRESS = 165 LBS TO LLOYDS.

Scale 1" = 1' 6"

2 BOILERS PER No

Shell plates to have a tensile strength of	27 to 30 tons
Butt straps & main stays	27 to 32 "
Other plates & stays	26 to 30 "

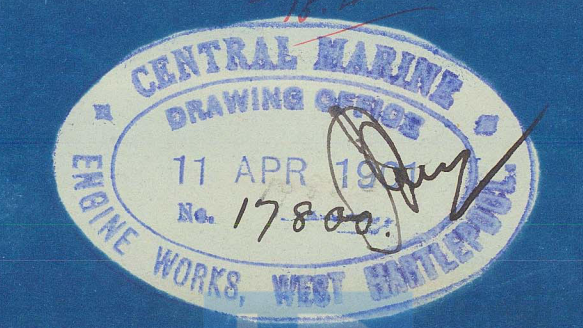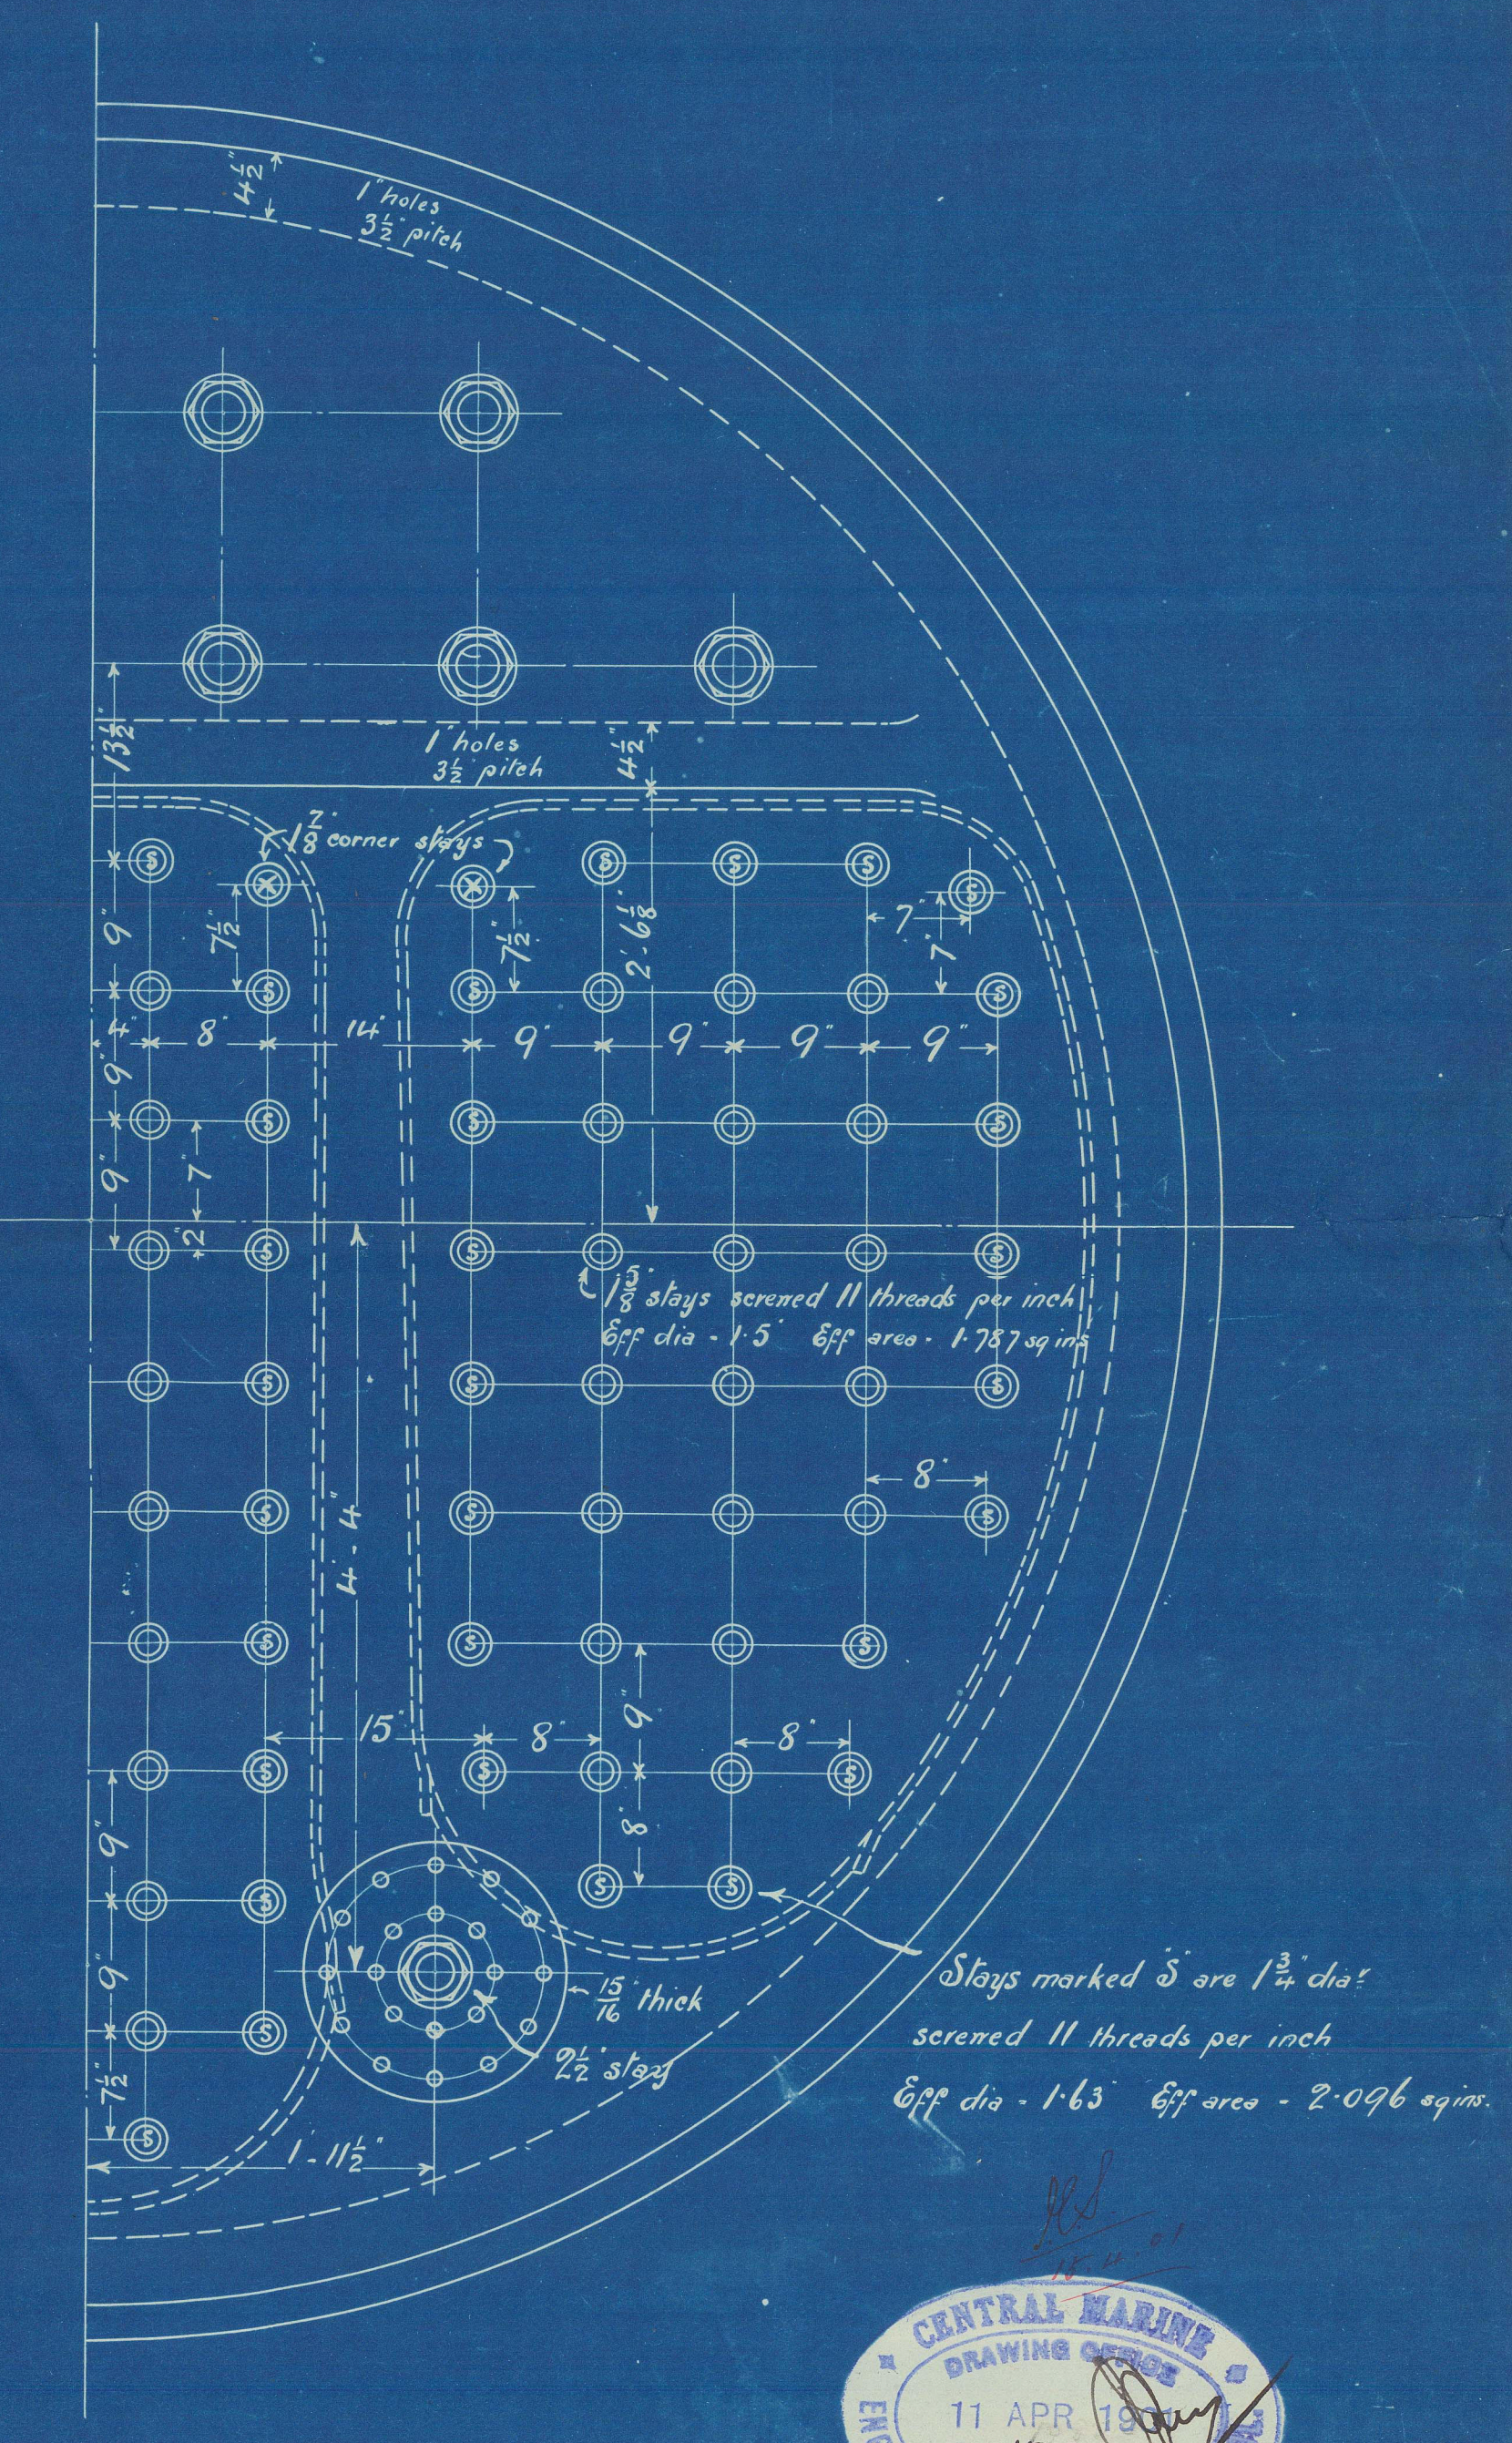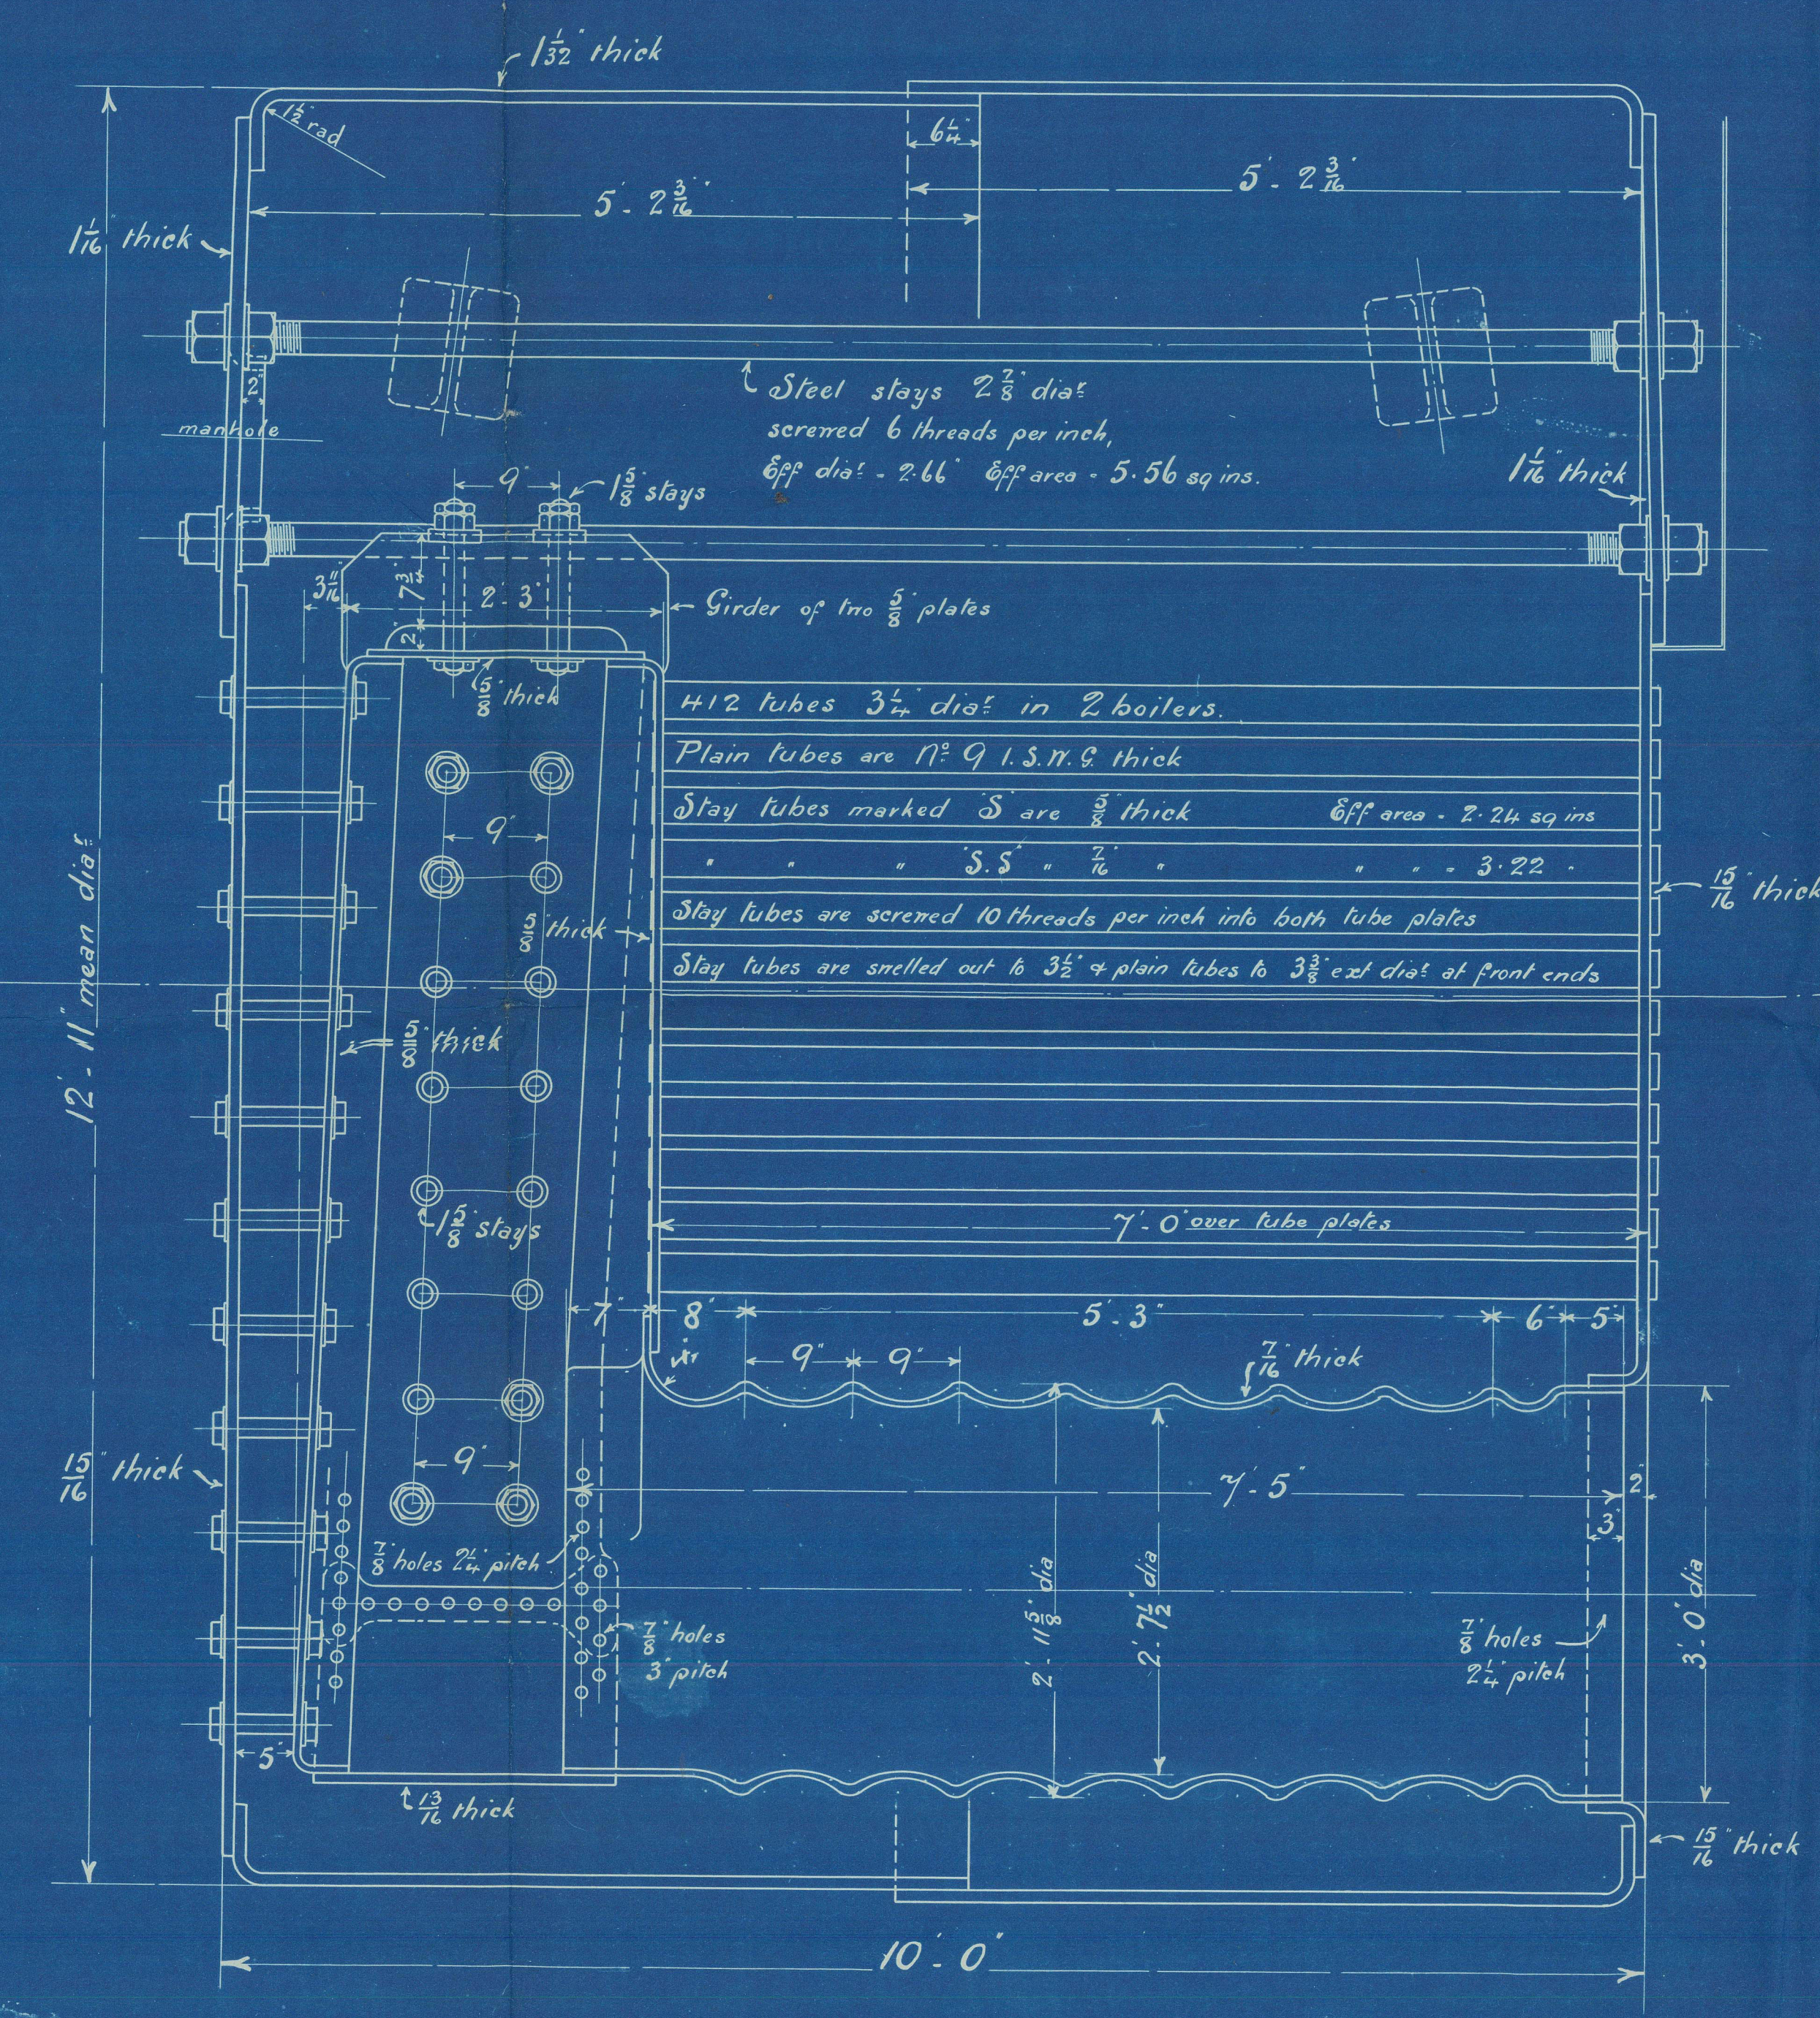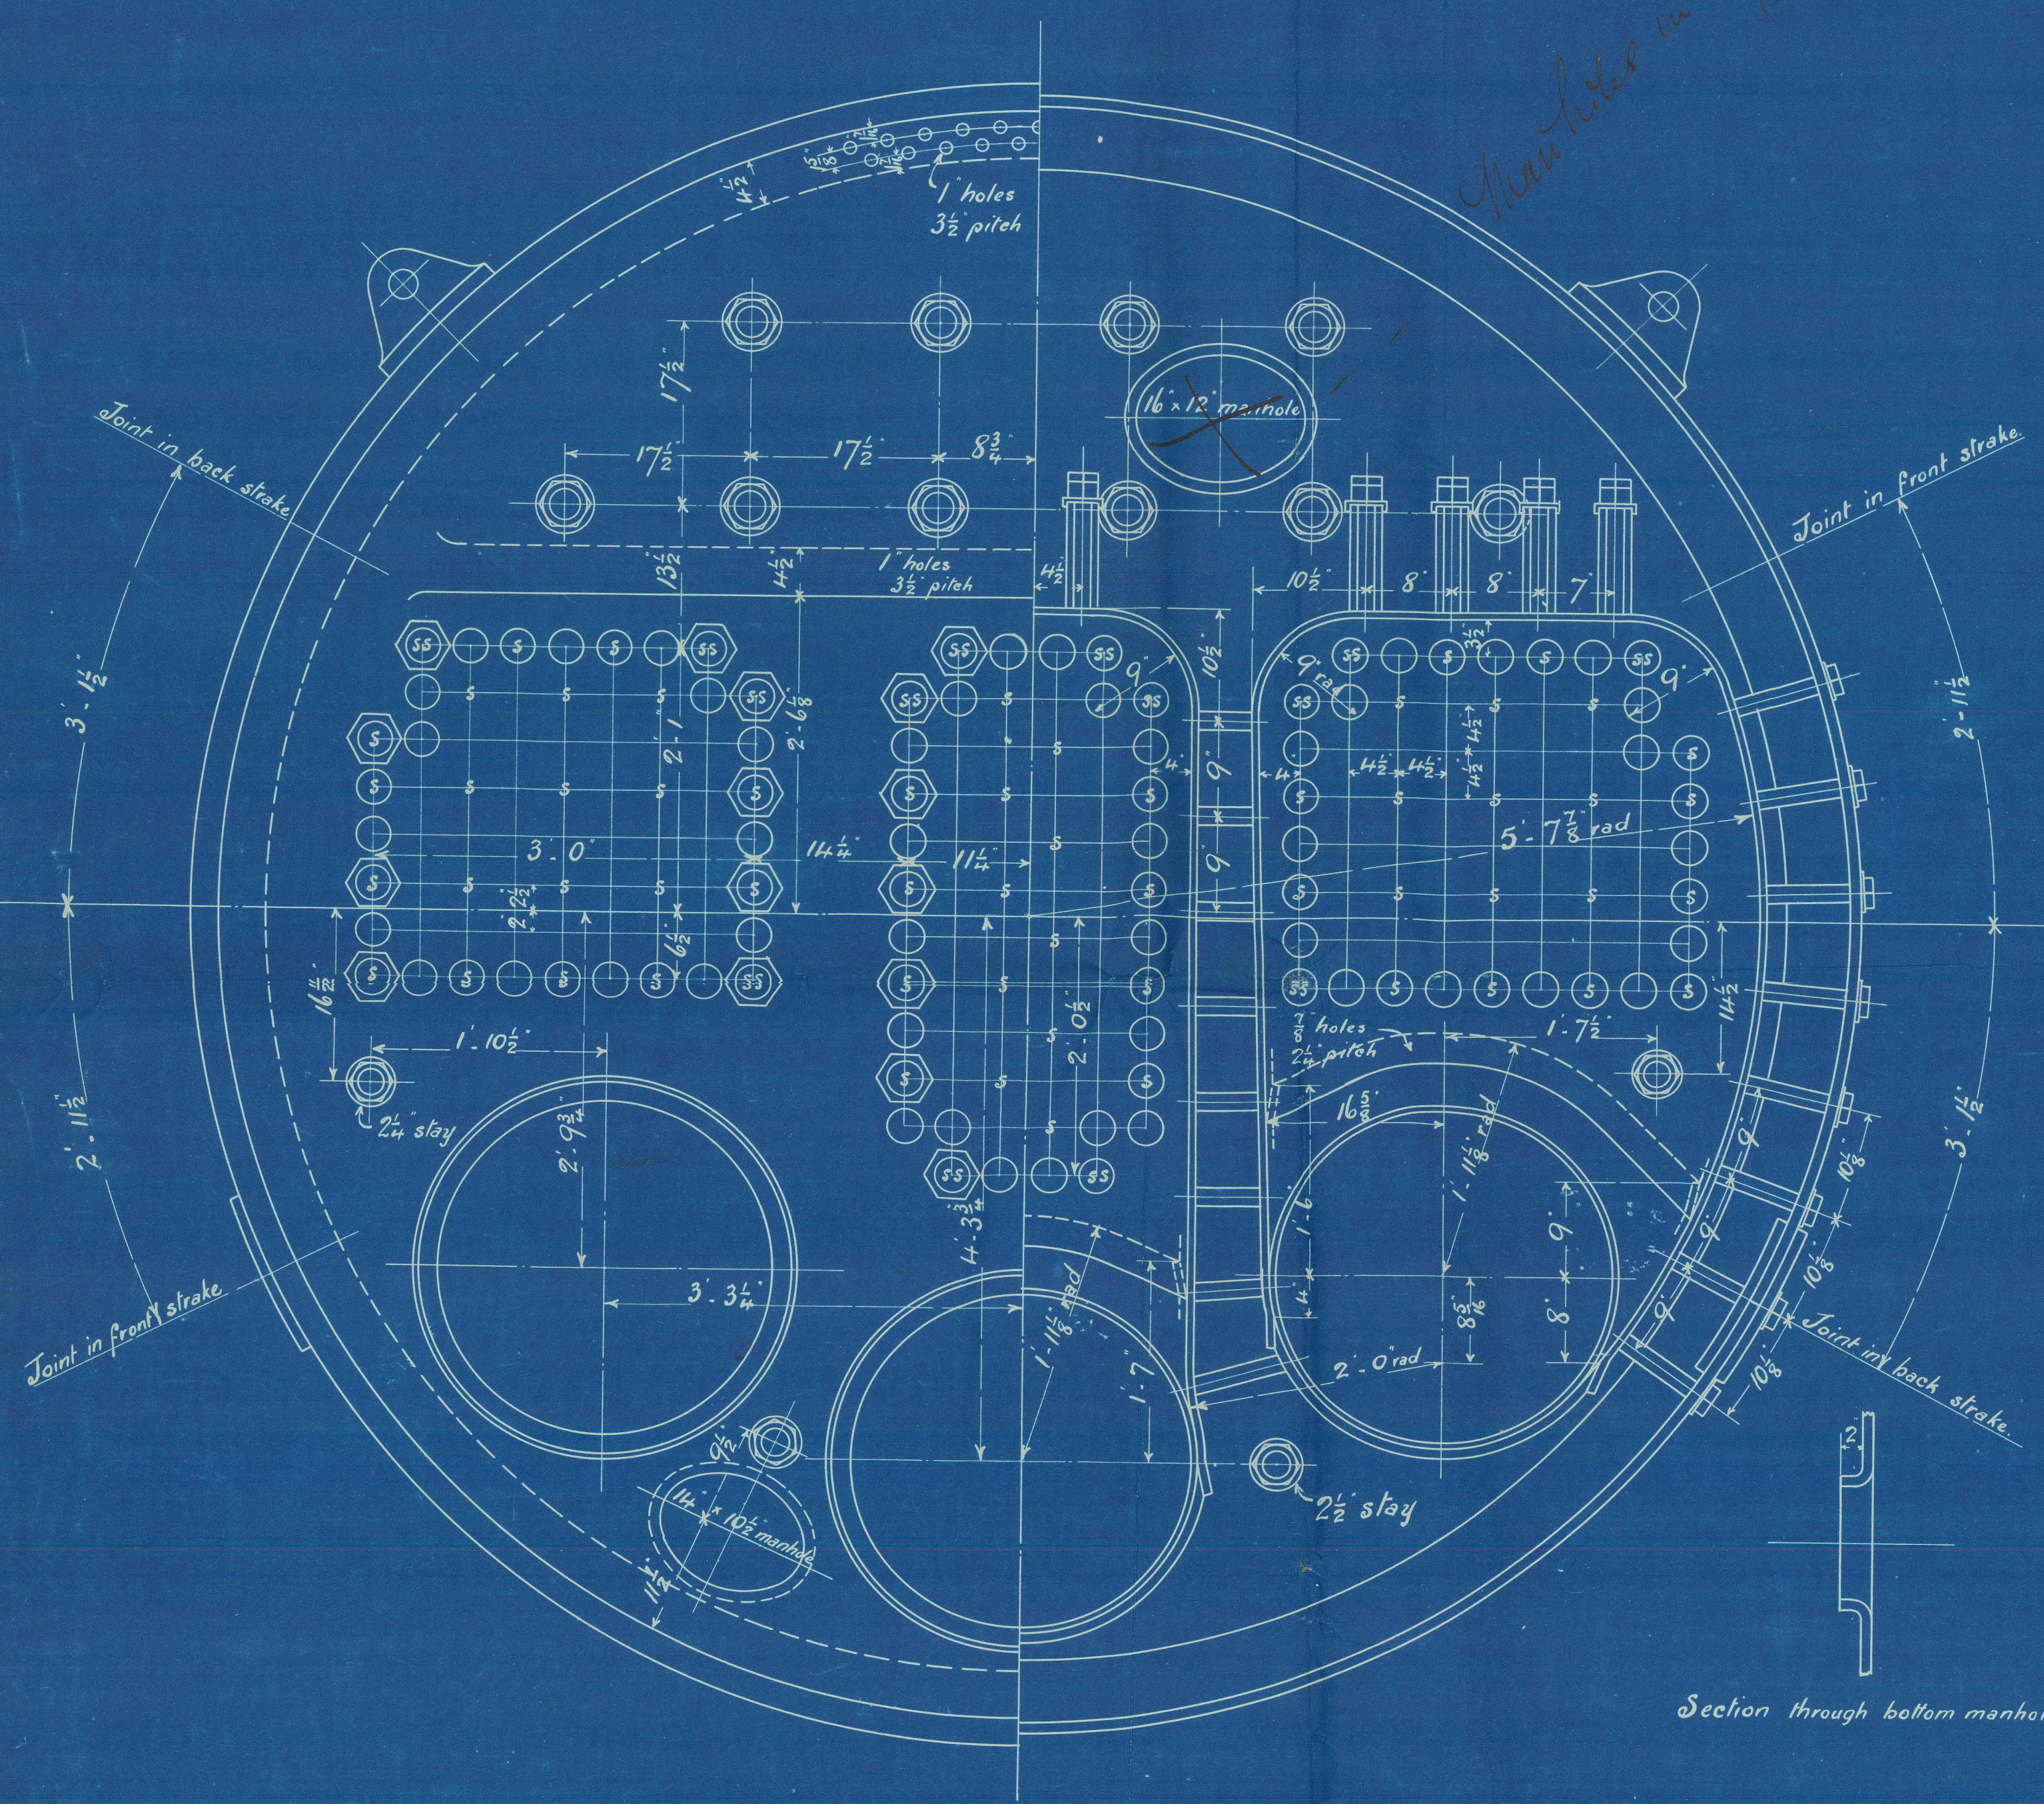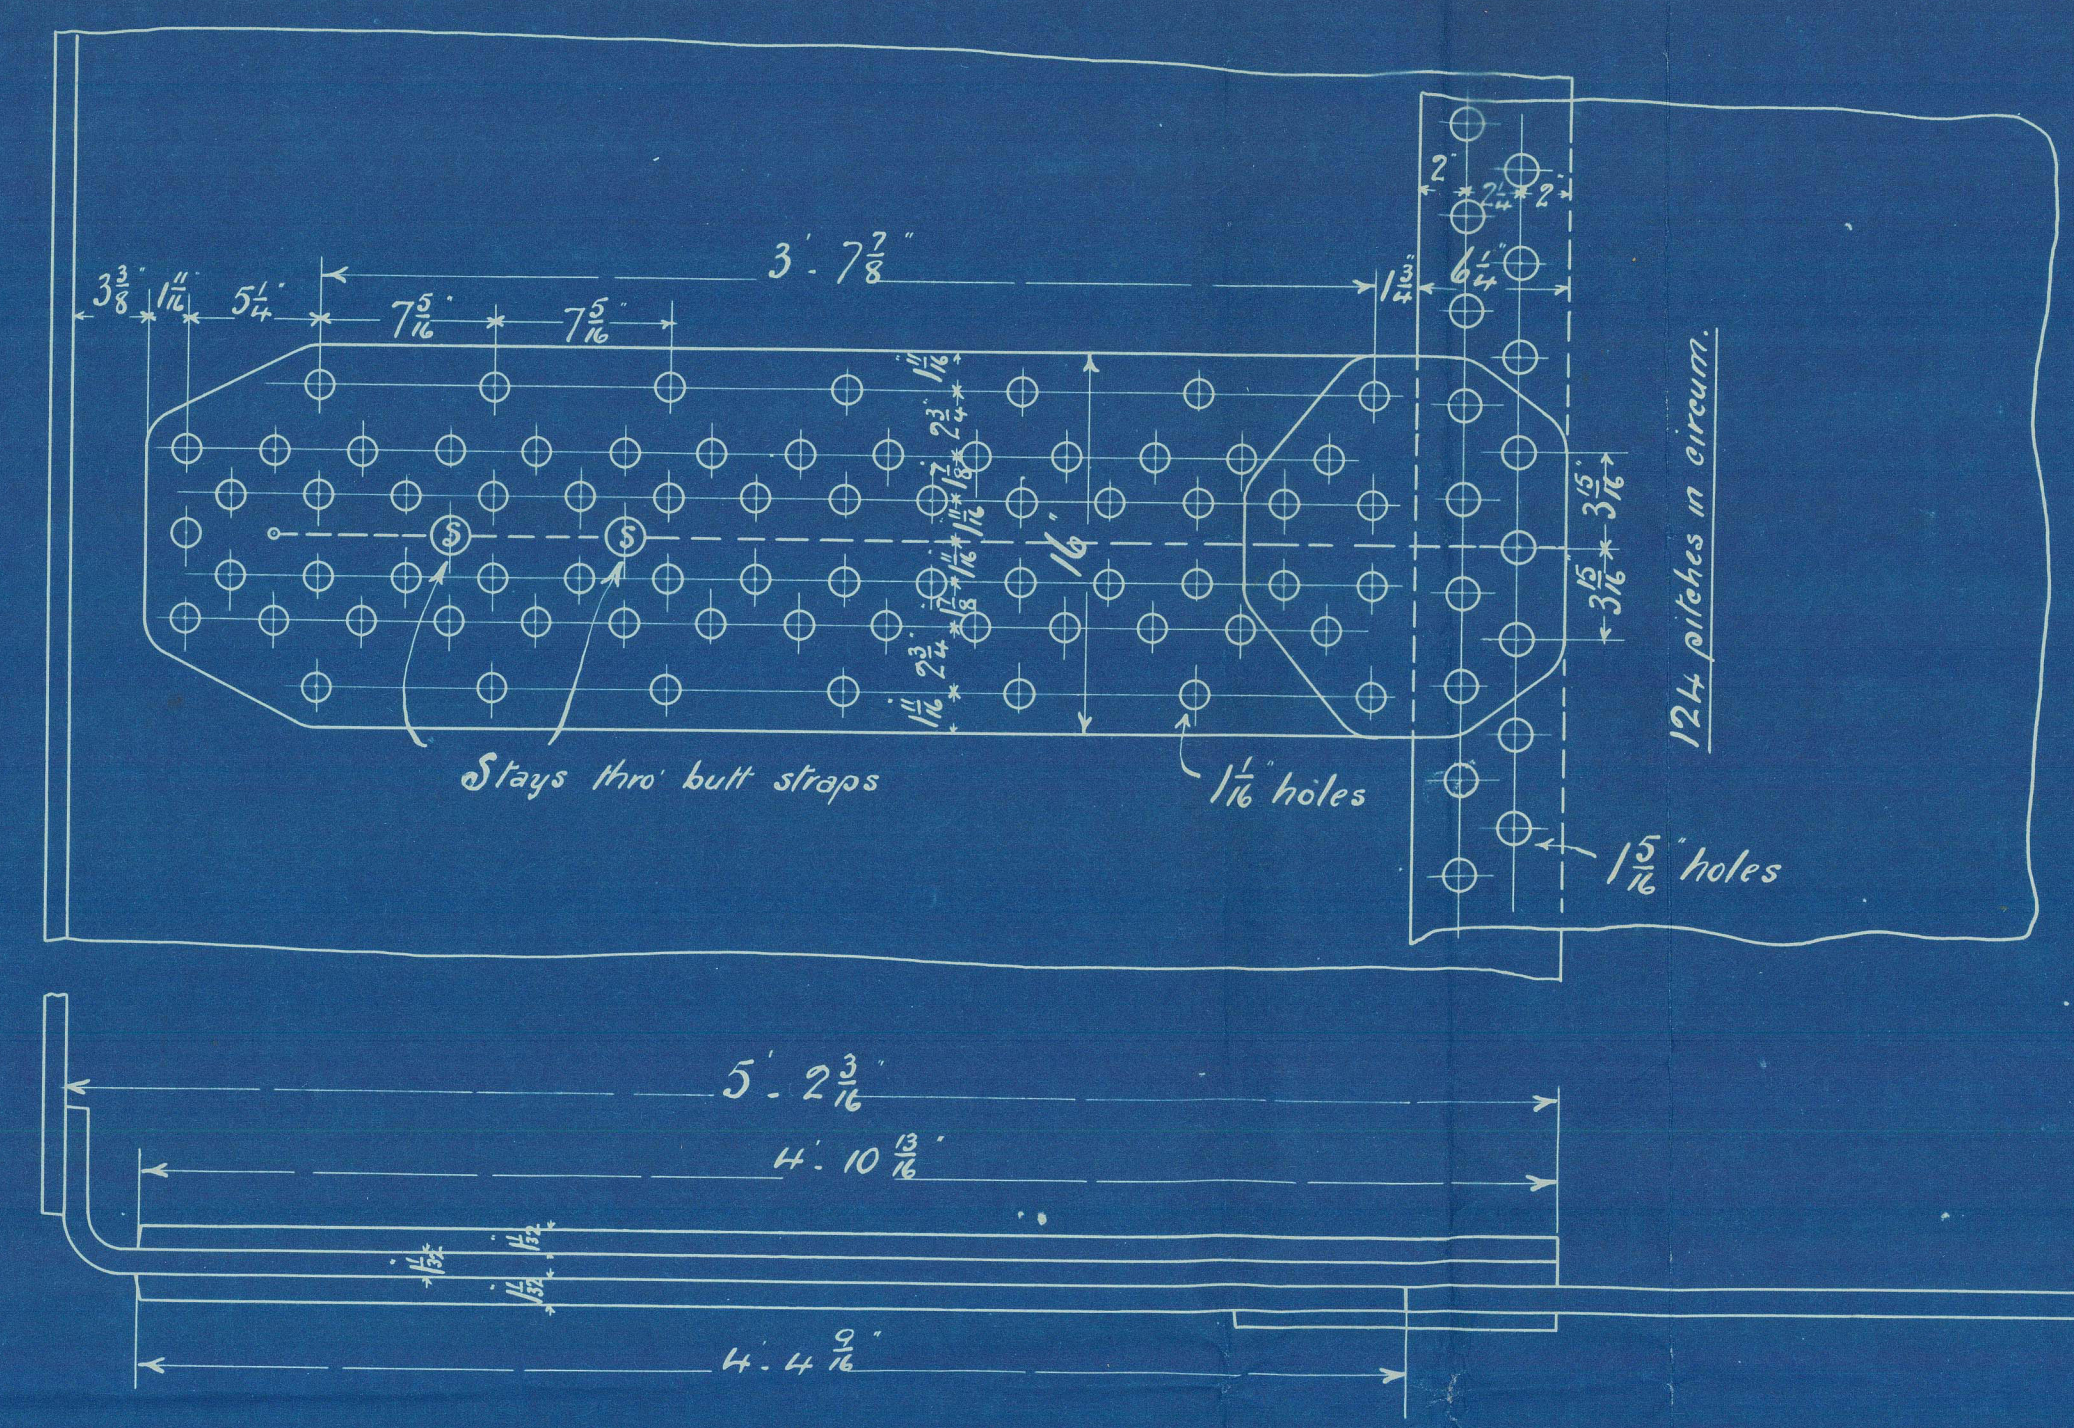

RETAIN

La Constructora
Naval Española
Cádiz
Nos 23 & 24
A. P. 185 1/2

Hpl. Reports Nos. 11908 &
11909



No 23

2816
Lloyd's test
330 lbs
11/2
23.7.01

No 24

2820
Lloyd's test
330 lbs
11/2
14.8.01

Lt. Pedro Luis Lacave



©2021

Lloyd's Register

W 812-0067