


24-7-13
31-7-13

S. S. N° 505.

LENGTH B.P. 383'-6", BREADTH EXT. 52'-0", DEPTH M.L.D. 29'-6".

SCALE $\frac{1}{8}$ " = 1 FOOT.

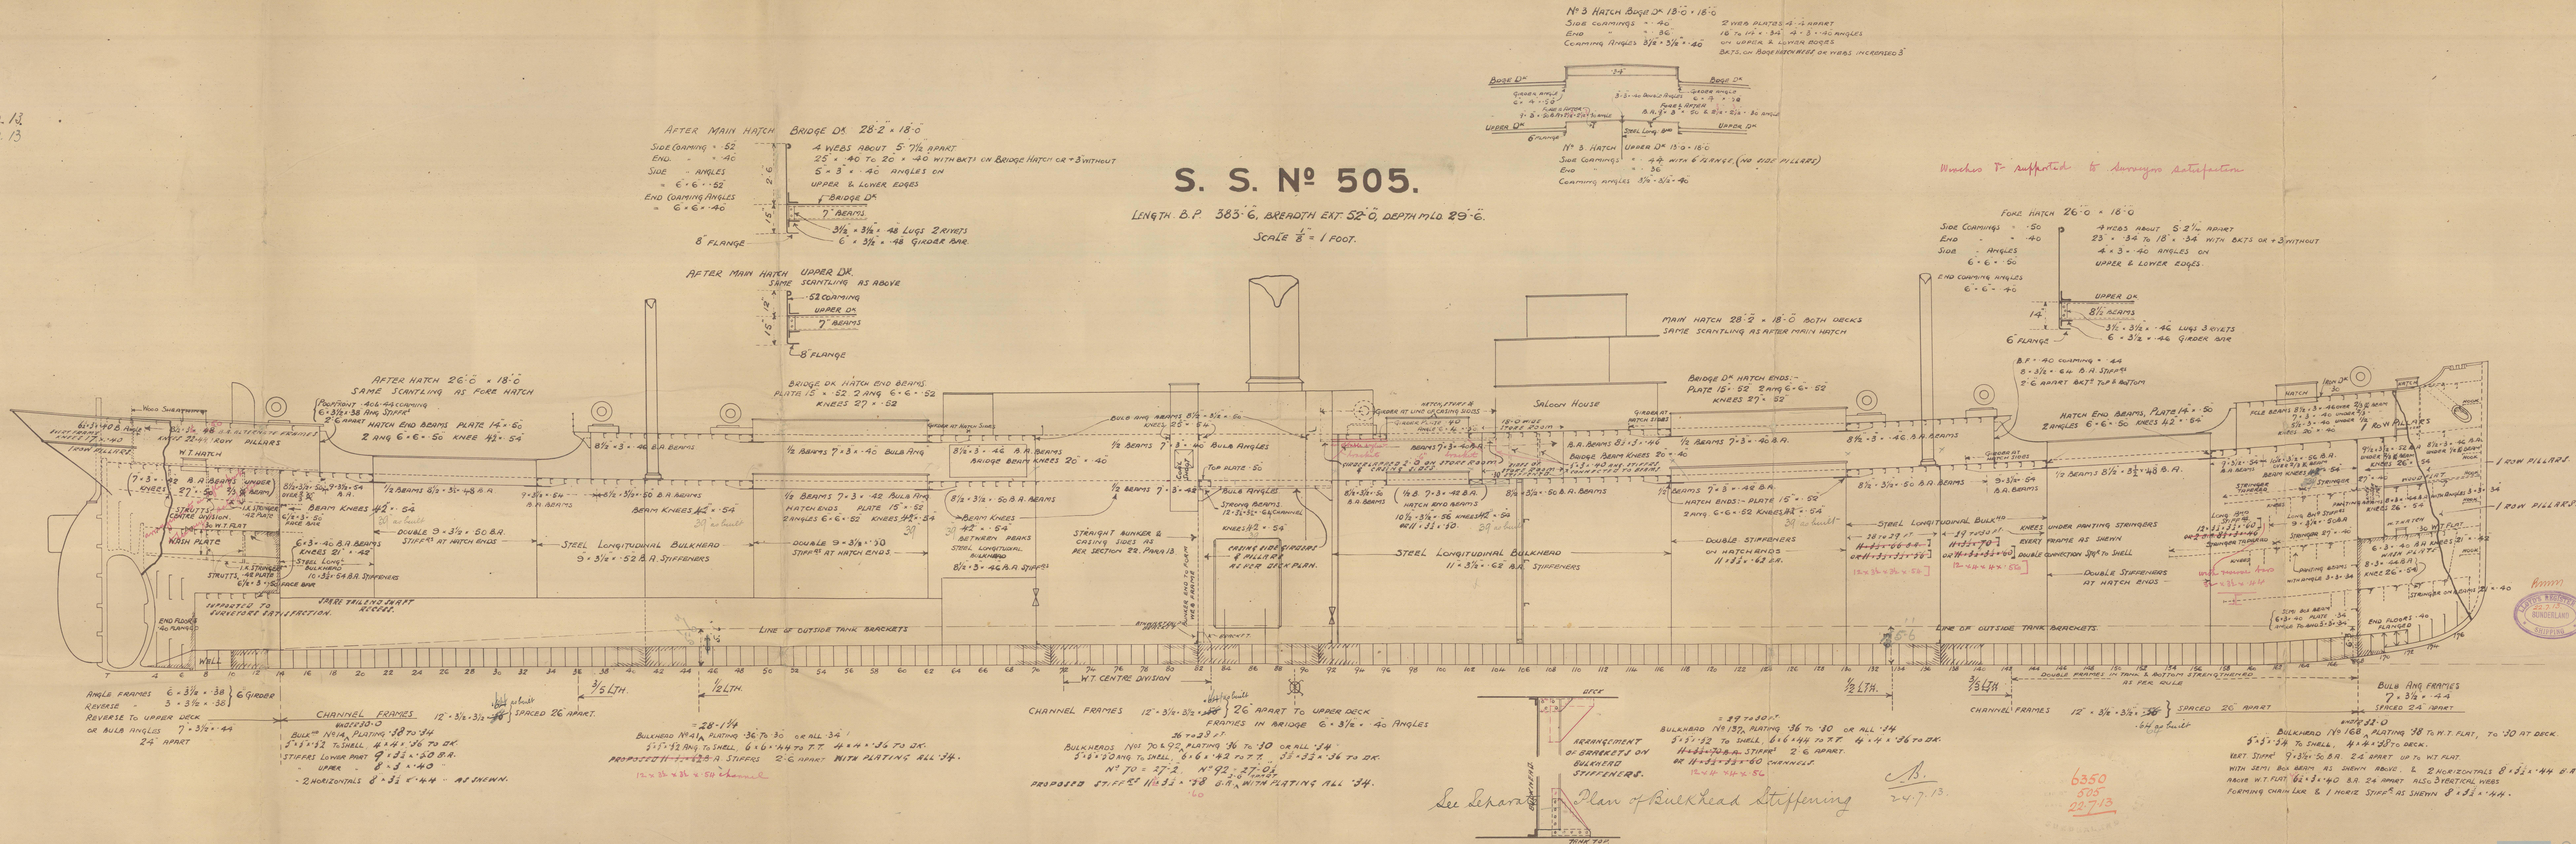

See separate Plan of Bulkhead Stiffening

6350
505
22-7-13




W813-0007

Amended Profile

No. 505

L. L. Thompson

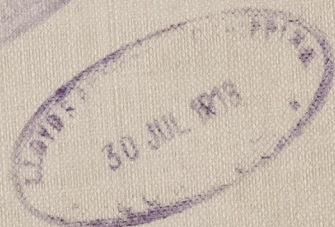

REMAIN

S. S. Mercantile

Lloyd's Register Foundation