


POSITION OF BUTTS ARE APPROXIMATE.



6378.
505.


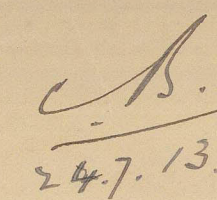


N. 505.

Deck Plans

Amended plans.

J. L. Thompson & Sons

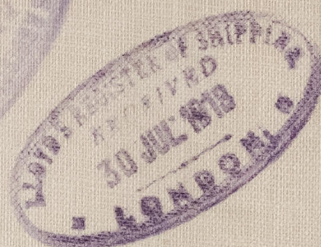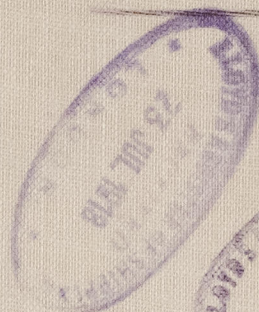

S.S. Lucerna

Slack No 26068

RETAIN



© 2021

Lloyd's Register
Foundation