


Nº 16.  
VAPOR PARA CARGA  
ESCALA  $\frac{1}{300}$

16.4.0

1600-118M

Strong hull angles  
 with bulk angles  
 30° off

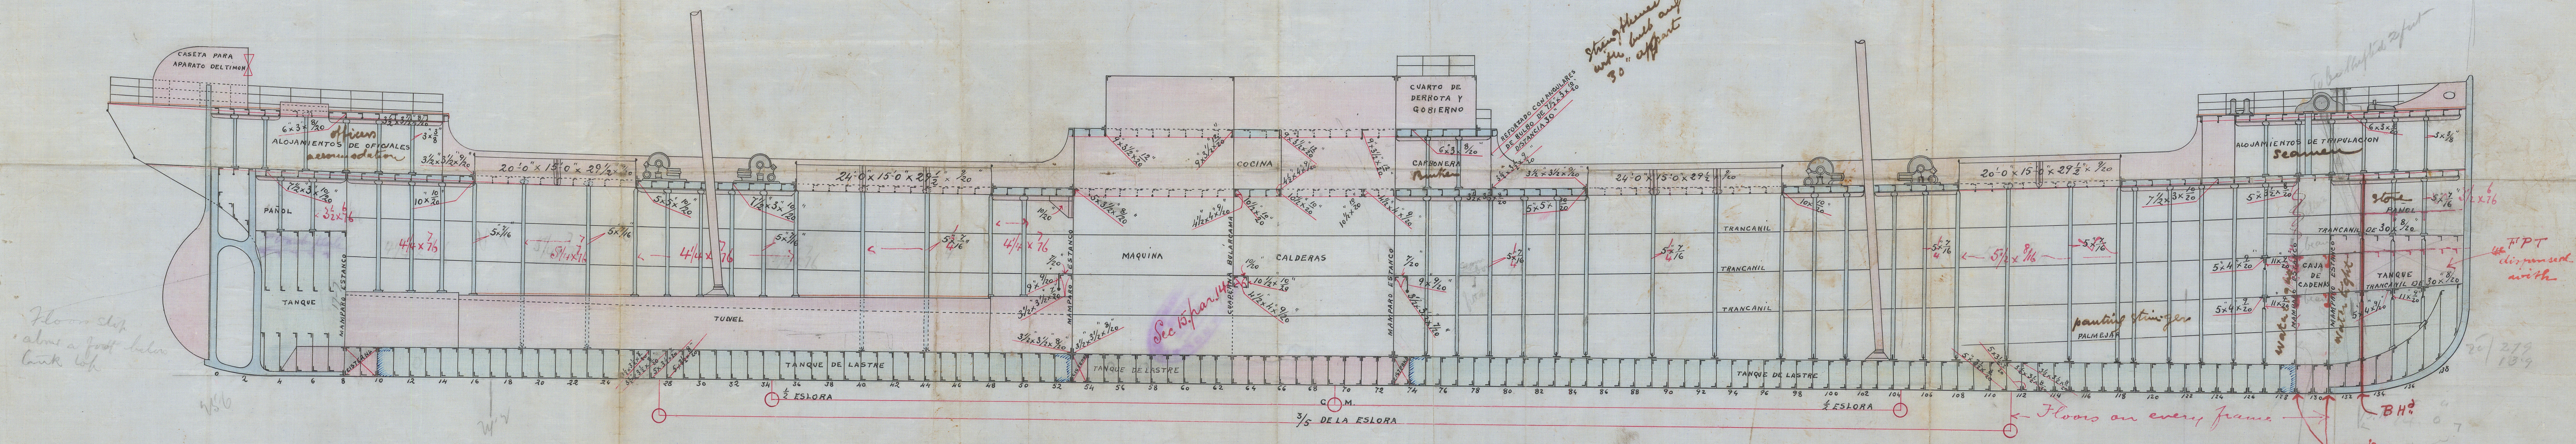

Floors ship  
 about a foot below  
 bulk top

RETAIN

16.4.0  
 24/12/03  
 16/4/07

Floors on every frame

BH's removed &  
 4 beams fitted  
 instead.

W814-0091



badij 290

AGRAVAPOR

