


7.8.09

— N^o 253. —
PROFILE AND DECK PLANS.
— SCALE $\frac{1}{8}$ " = 1 FOOT. —

28/7/09
155

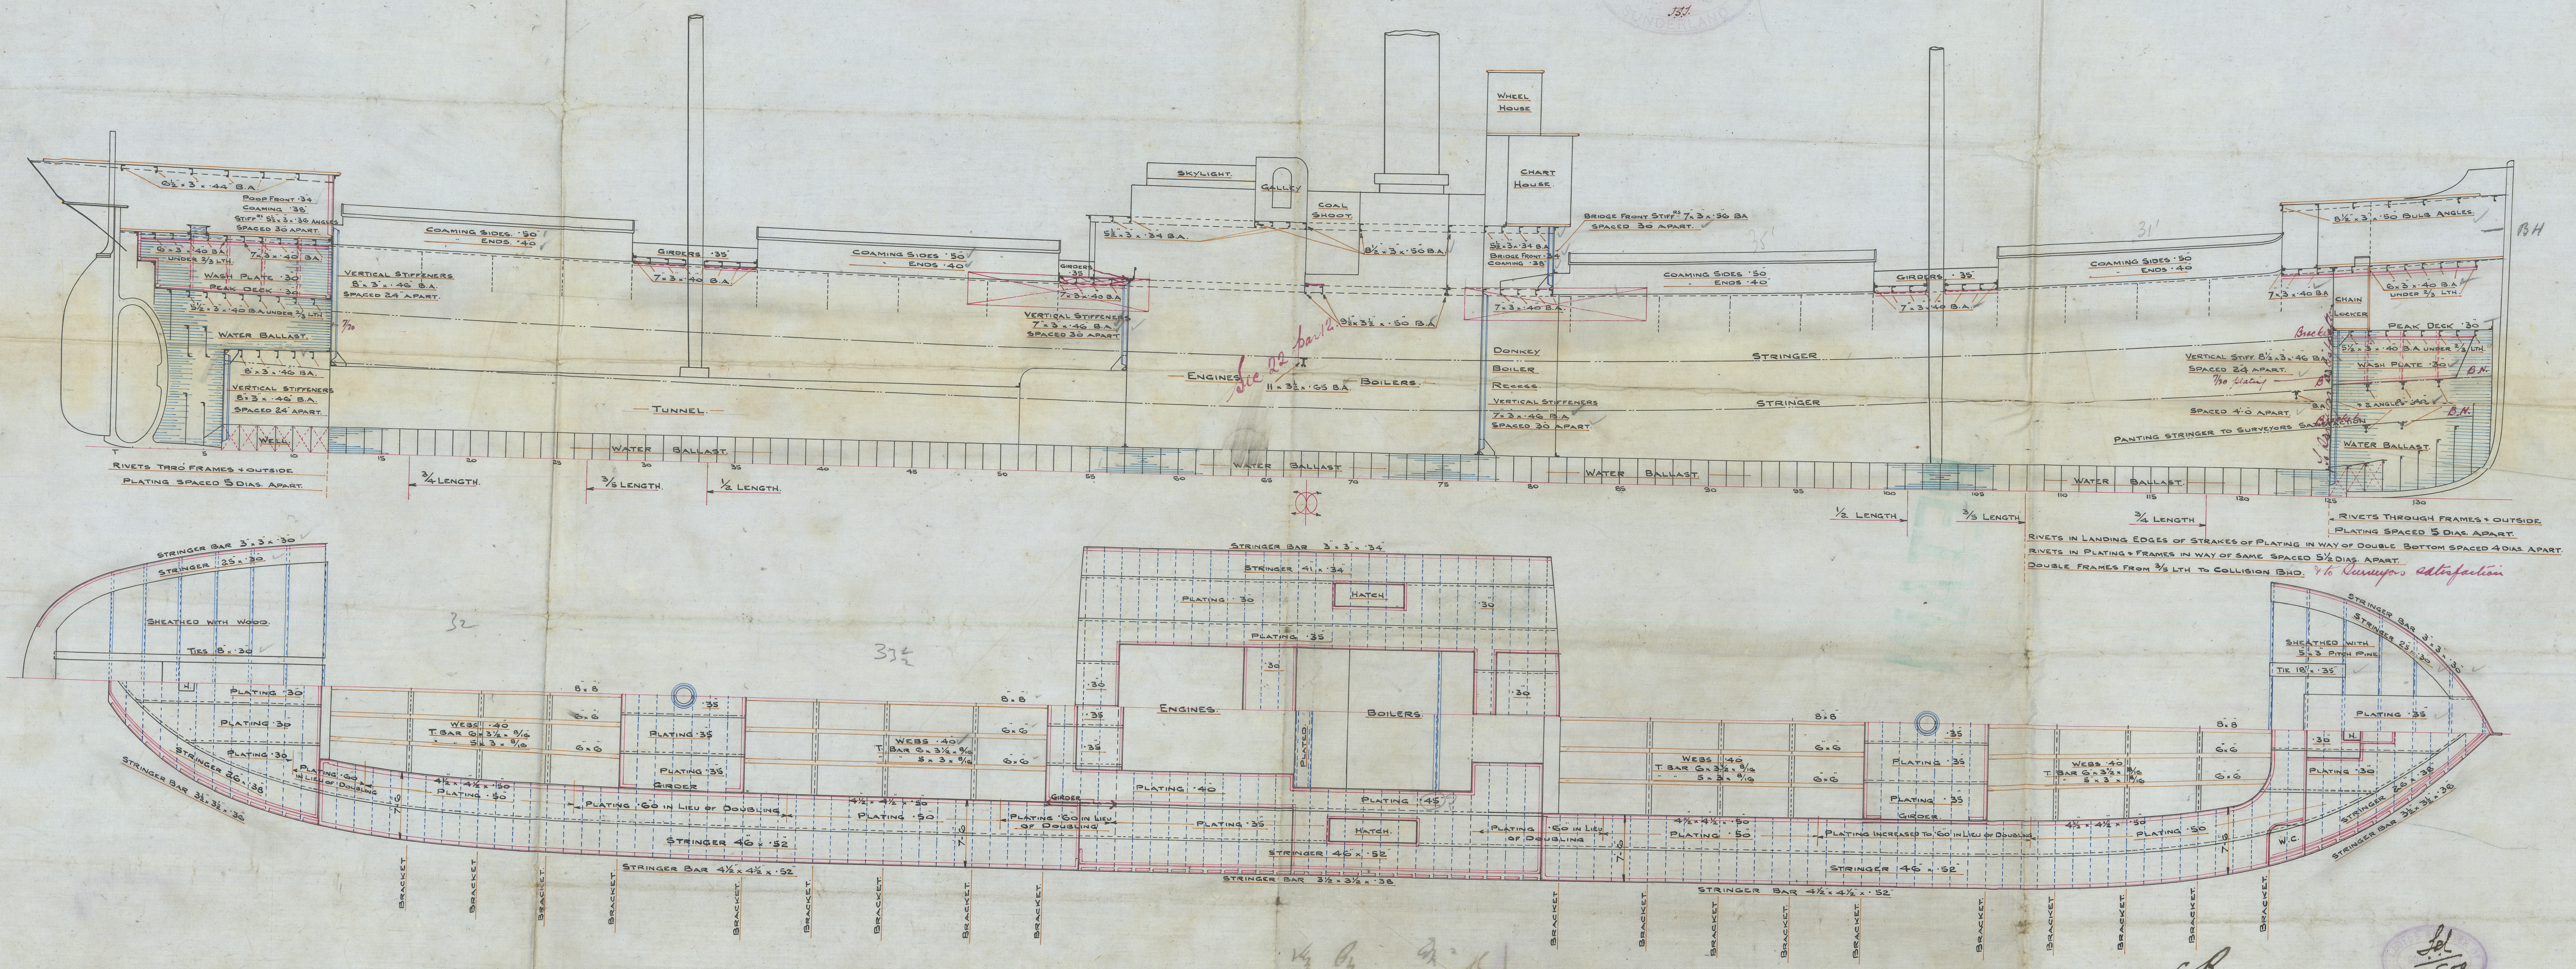

RIVETS THROUGH FRAMES + OUTSIDE PLATING SPACED 5 DIAS. APART.
RIVETS IN LANDING EDGES OF STRAKES OF PLATING IN WAY OF DOUBLE BOTTOM SPACED 4 DIAS. APART.
RIVETS IN PLATING + FRAMES IN WAY OF SAME SPACED 5 1/2 DIAS. APART.
DOUBLE FRAMES FROM 3/8 LTH TO COLLISION BNG. 4% Curvature satisfaction

C.B.
7.8.09

28/7/09

Truman L.P. Austin Survey

Profile + drill plan

No. 253

Sta. Report No 24444

"Largo"



© 2020
W85-0018

Lloyd's Register
Foundation