


Midship Section
(as built)
S. S. "Landonia"
Thrs for The Clyde S.S. & Eng. Co.
No. 317
Grk Rpt. No. 17184.

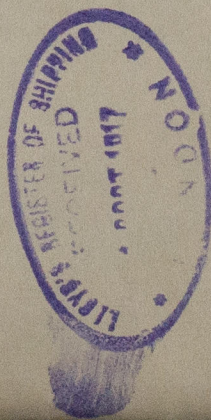

© 2020

Lloyd's Register
Foundation

W625-0143