

WORKING PRESSURE - 90 LBS PER SQ. INCH

118 PLAIN TUBES 2 1/2" EXT. DIA⁸ 1/4" THICK SWELLED 1/8" AT FRONT END

TENSILE STRENGTH OF SHELL PLATES - 28 TO 32 TONS \square

" " " " Tube " - 26 to 30 " "

" " " ALL OTHER " 26 TO 30 " "


STEEL PLATES AND RIVETS IRON LAPWELDED TUBES

HEATING SURFACE 265 GRATE SURFACE 14

BLAKE PATENT BOILER - 12'-6" x 5'-6" x 90 LBS

SCALE 1" = 1 FOOT.

BOILER N^o ~~3112.~~ 3133

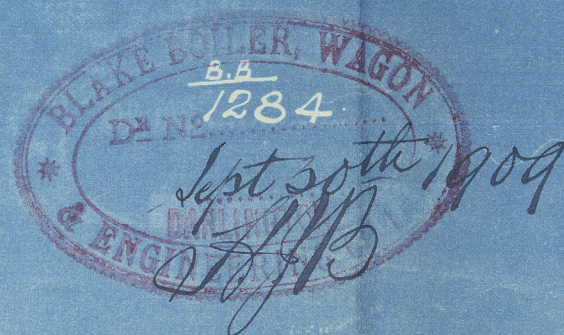


Duplicate of approved place

10.8.09

Blake Patent Boiler
No. 3133

for
S. P. Austin House Ltd
S.S. No. 251

90 lbs h.p.

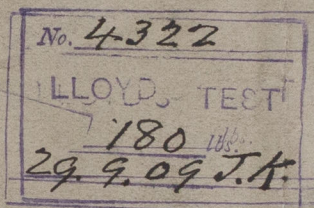

Mar. Rpt. No. ~~3493~~
5981

'Lady Helen'
Old No. 24263

RETAIN

W 830-0137



© 2020

Lloyd's Register
Foundation