

27/1/15

SCALE 1 INCH TO A FOOT

ISO. LIB^S W. P.

TENSILE OF MATERIAL

2 Main Boilers

Messrs Blair & Co Lim?



No 1828

for

Messrs Repner & Sons

S.S. No 503

Working Press 180 lb

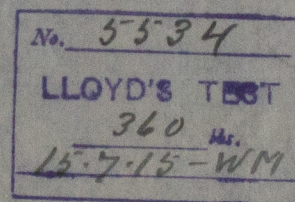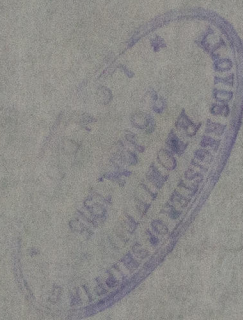

S.S. Napluwood

Mab Rpt. No 9105.

RETAIN

W835-0029 ²/₂



© 2020

Lloyd's Register
Foundation

From BLAIR & CO., Ltd.,

STOCKTON-on-TEES.

For Enclosure to

Messrs Lloyd's Register
Engineer Surveyors
Middlesbrough

W835-0029 1/2