


# LONGITUDINAL SECTION FOR SCREW CARCO STEAMER. N<sup>o</sup> 265.

TO CLASS 100 A1 AT LLOYDS (STEEL.)

SCALE 1/4" = 1 FOOT.

1.12.05  
7.12.05

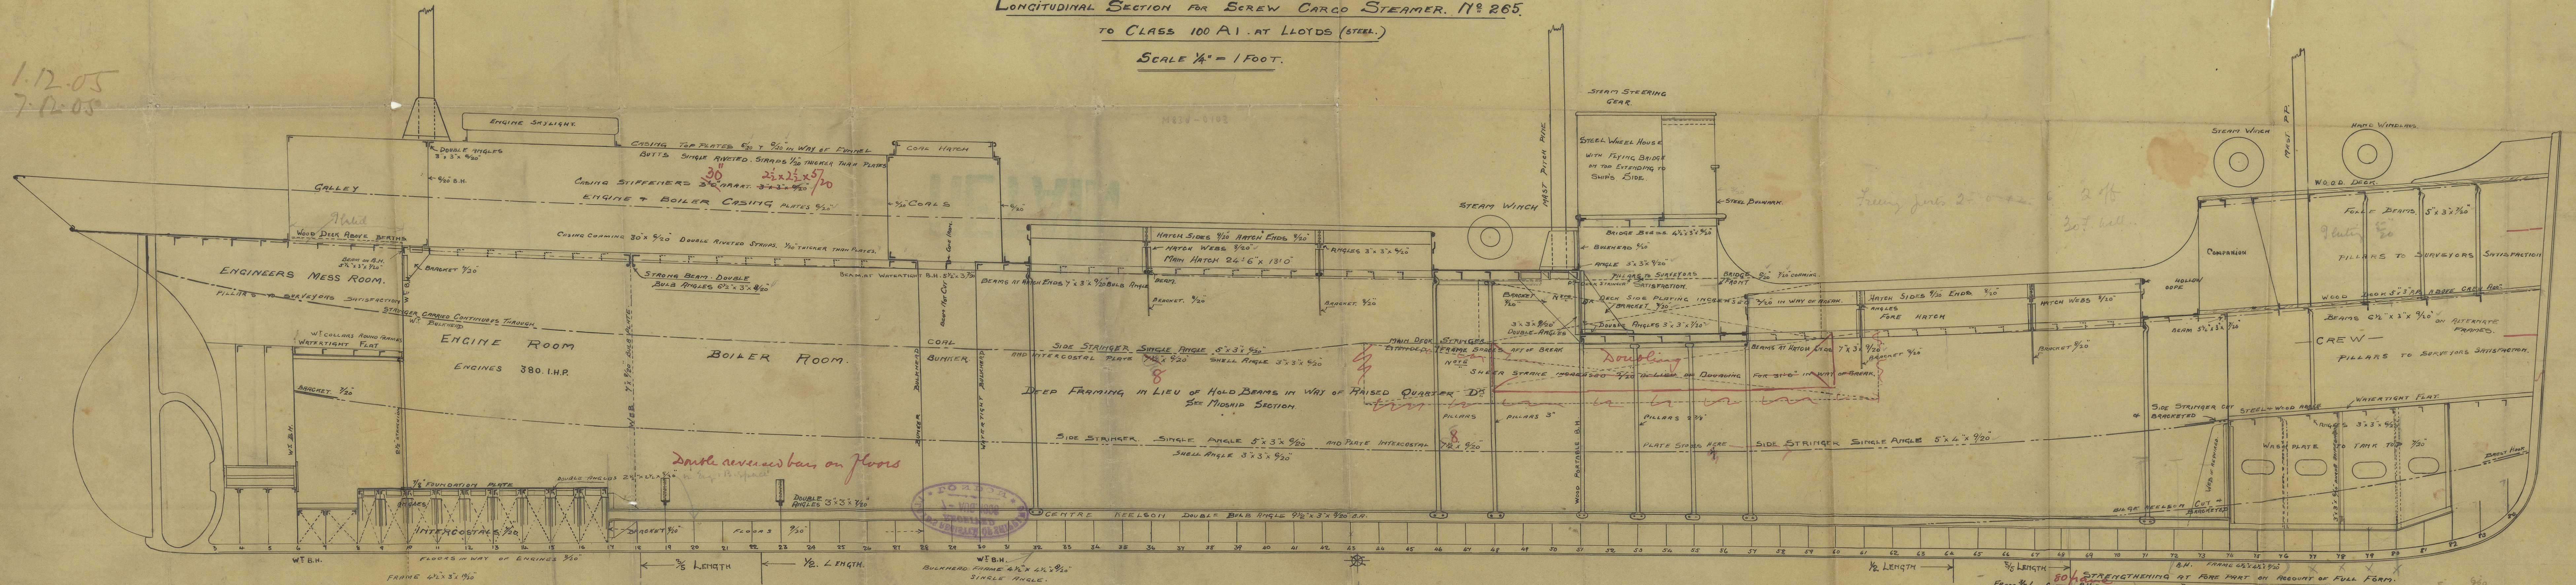

80% STRENGTHENING AT FORE PART ON ACCOUNT OF FULL FORM.  
FROM 1/8 L TO 1/2 L FRAMES DOUBLED FROM BILGE TO BILGE. FRAMES AT THIS PART 4 1/2" x 3 1/2" 9/20 BY FRAMES 3 1/2" x 2 1/2" 9/20  
FROM 1/2 L TO 3/4 L RIVETS IN THE LANDING FLOES OF B STAKE SPACED 4 DIAM. APART C 10 C 3  
FROM 3/4 L " " RIVETS IN THE PLATING AND FRAMES IN WAY OF A STAKE AND B STAKE 5 1/2" DIAM. APART C 10 C 3

or 2nd 2nd line  
C.F. 1/12/05  
12.8.05  
J. Rogers 100 x C. 8




J. Guthrie & Co. L.

S.S. No. 265

Profile

S.S. "Marion"

Abt Rpt. 8929

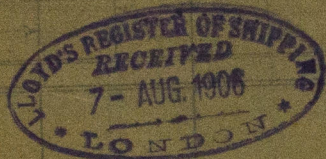

© 2020

Lloyd's Register  
Foundation

W839 0103