

# MIDSHIP SECTION

N° 368 SS

SCALE 1/2" = 1 FOOT

TO CLASS 100 A1 AT LLOYDS

| EQUIPMENT                     |        |
|-------------------------------|--------|
| 92-66 x 460-6                 | 433    |
| POOP 46 x 7.5 x 75            | 258.75 |
| BRIDGE 124.37 x 96 x 15       | 742.45 |
| POOP 41 x 7 x 75              | 231.00 |
| SALPOON HOUSE 20 x 7 x 5      | 14.32  |
| HOUSES & CASING 78 x 7.75 x 5 | 282.75 |

45122-20

EQUIPMENT

|                 |         |  |
|-----------------|---------|--|
| 2 BOWER ANCHORS | 77 CWTs | Stockless                                    |
| 1 " "           | 652     | "  |
| 1 STREAM        | 22      | EX STOOD                                     |
| 1 KEDGE         | 10      | "  |
| 300 PATHWAYS    | 2 1/2   | STUD CHAIN CABLE (2 1/2 PER SPEC)            |
| 120             | 5       | STREAM WIRE                                  |
| 110             | 5 1/4   | STEEL WIRE TOWLINE 2 1/2 IN DIAM 15 1/2 TONS |
| 1 @ 90          | 3 1/2   | " "  |
| 1 @ 90          | 3 1/2   | " "  |
| 2 @ 90          | 8       | MANILA WARPS                                 |
| 2 @ 90          | 8       | MANILA WARPS                                 |


BRIDGE STRINGER BUTTS  
LAPPED & TREBLE RIVETED.

NUMERALS

BREADTH = 57.75  
DEPTH = 34.91  
92-66 = TRANSVERSE No  
462-6 LENGTH  
45513 = LONGITUDINAL No

PROPORTIONS

DEPTHS TO UPPER DECK = 13.45  
BRIDGE " = 10.85

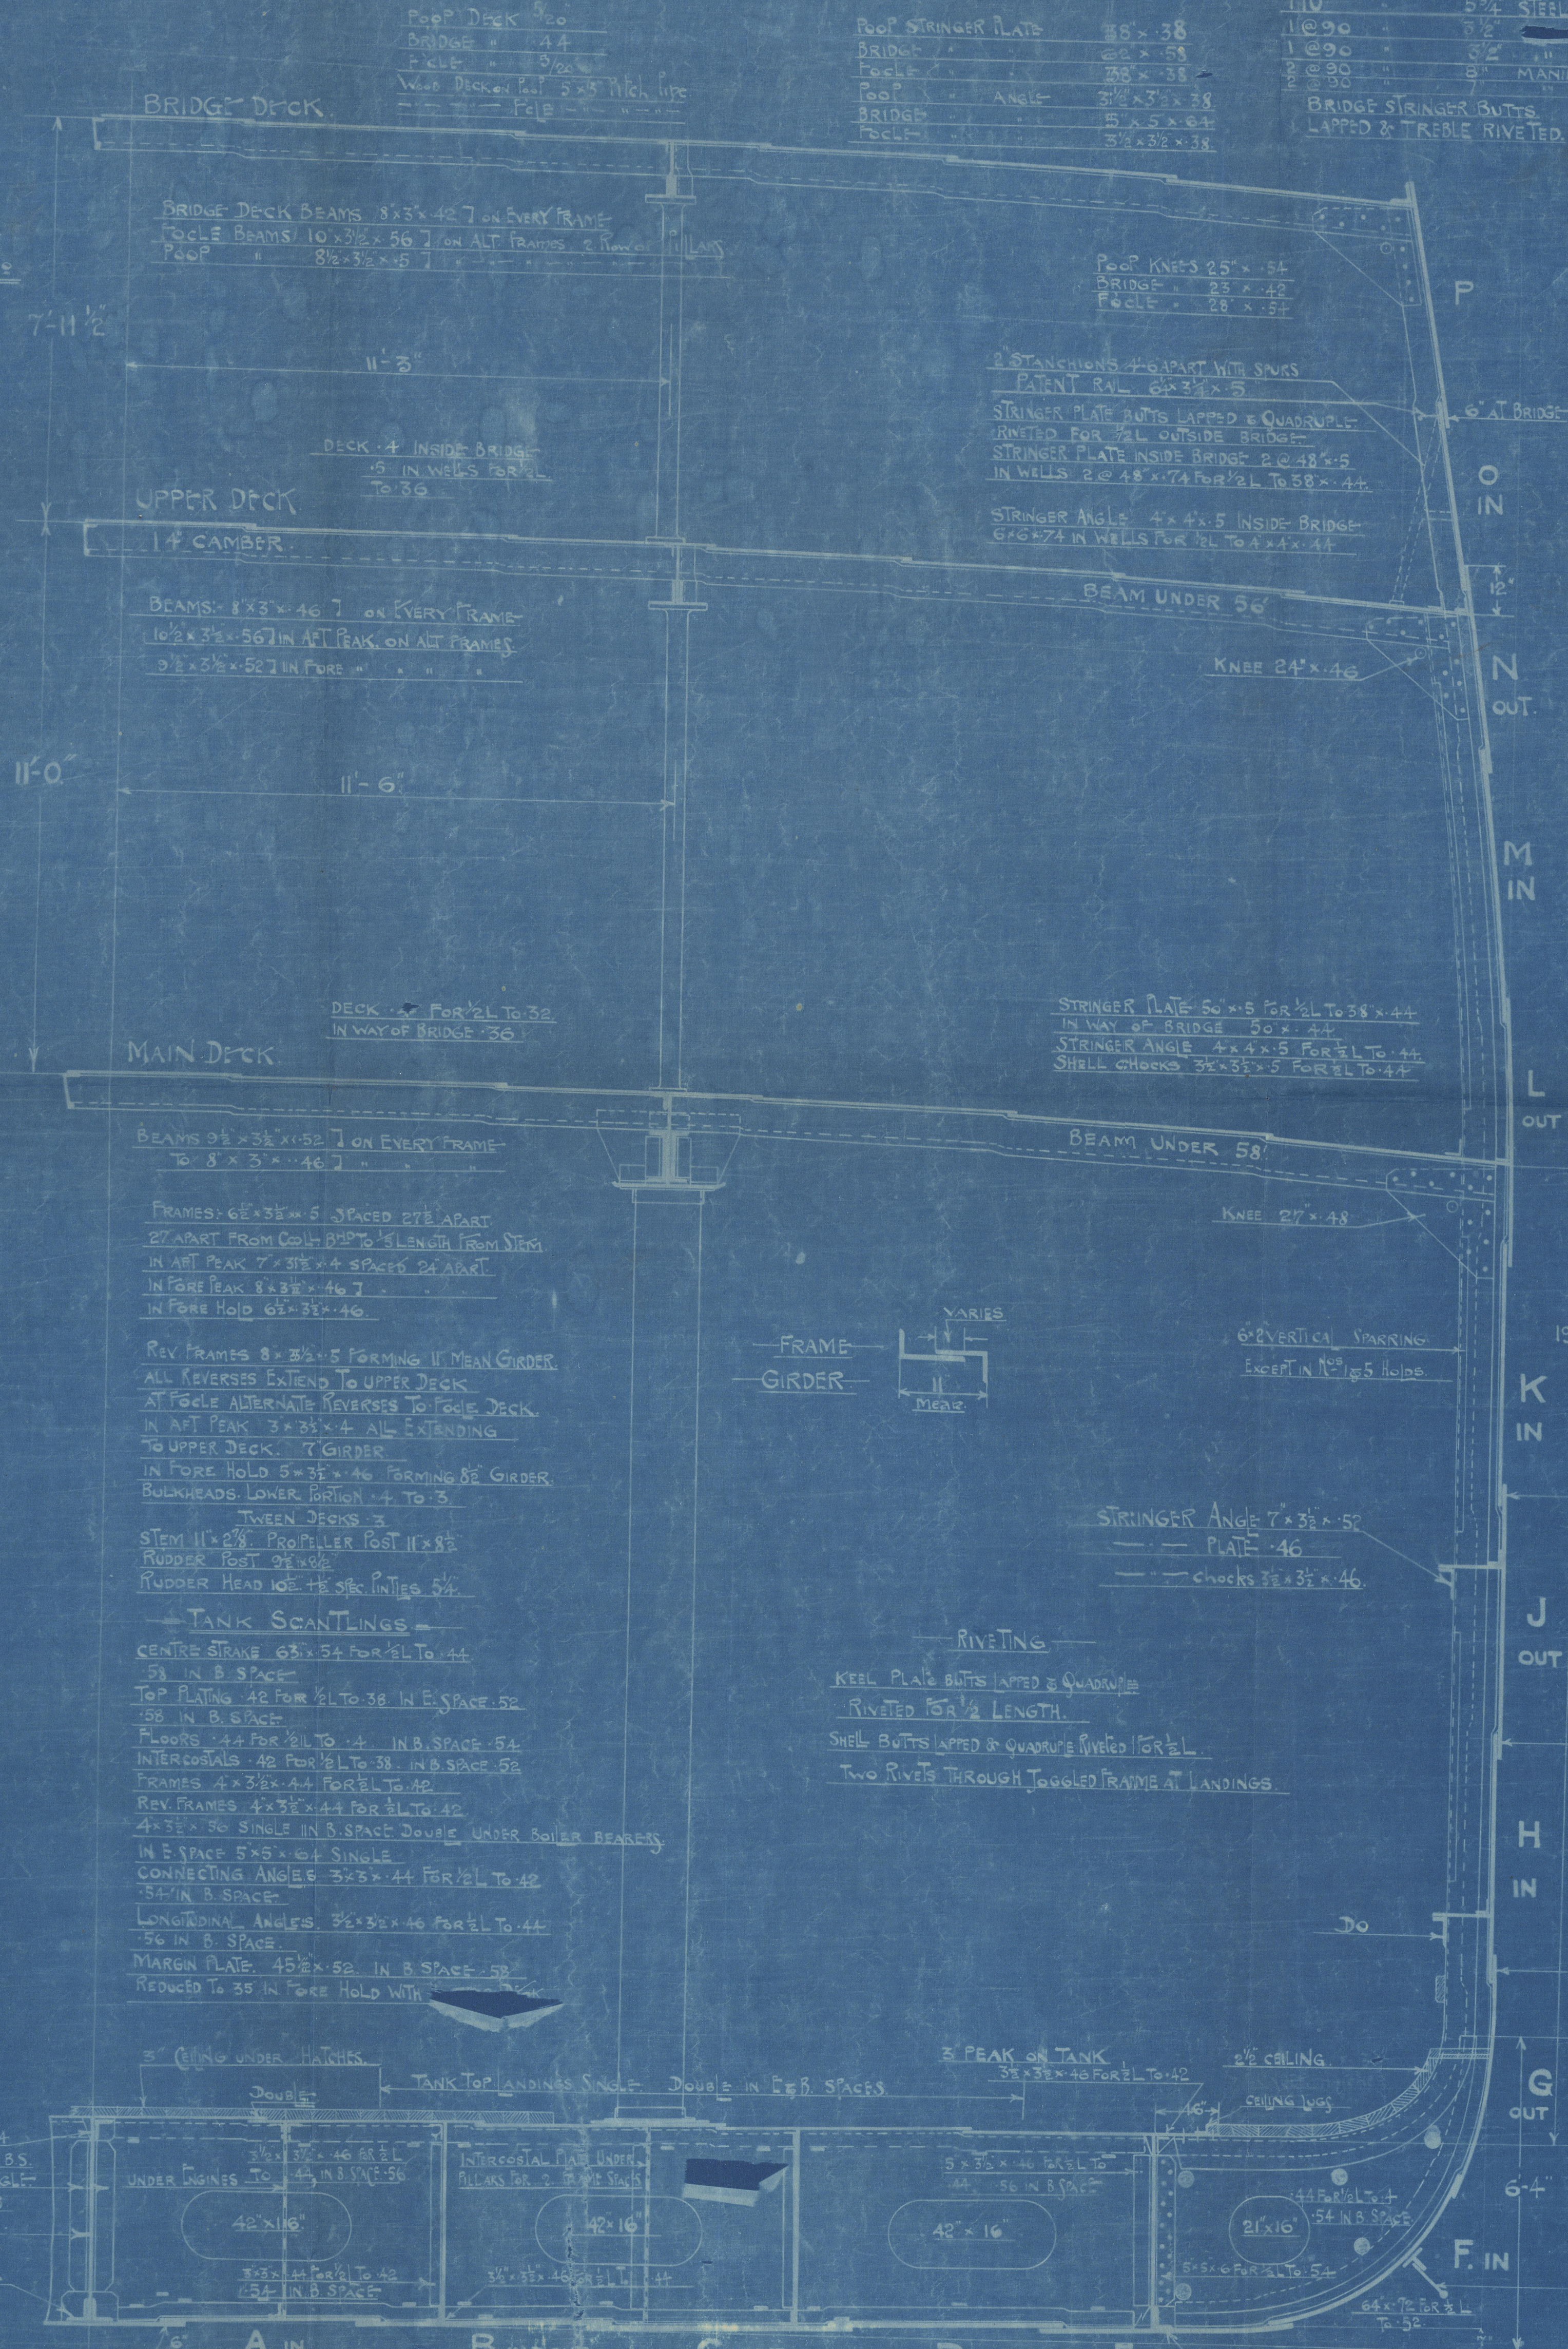

POOP 46  
BRIDGE 59 x 76 1/2 at ENDS  
POOP 44  
BRIDGE SHEERSTAKE  
LAPPED & QUADRUPE RIVETED  
POOP 44  
BRIDGE 7 BUTTS LAPPED & 4 R. PLATING  
FILE 44  
SHEERSTAKE 49 x 16 FOR 1/2 L  
TO 48 AT ENDS IN WAY OF BRIDGE 68  
CLEAR OF BRIDGE FOR 1/2 L BUTTS  
LAPPED AND 5 RIVETS  
66 x 94 FOR 1/2 L  
TO 48  
IN WAY OF BRIDGE 68  
CLEAR OF BRIDGE FOR 1/2 L BUTTS  
LAPPED AND 5 RIVETS  
66 x 68 FOR 1/2 L  
TO 48  
63 x 68 FOR 1/2 L  
TO 48  
TREBLE FOR 1/2 L IN FORE BODY  
1/5 L IN AFT BODY  
66 x 68 FOR 1/2 L  
TO 48  
TREBLE FOR 1/2 L IN FORE BODY  
1/5 L IN AFT BODY  
60 x 68 FOR 1/2 L  
TO 48  
TREBLE FOR 1/2 L IN FORE BODY  
1/5 L IN AFT BODY  
60 x 68 FOR 1/2 L  
TO 48 (52 PER SPEC)  
PROPELLER BOSS  
PLATES 82  
BULK KEEL 6 x 6 x 54 TEE  
11 x 5 BULB PLATE  
EXTENDING FOR 183 FEET

TOP ANGLE 5 x 5 x 62 TO 50 SINGLE 3 1/2 x 3 1/2 x 54  
DOUBLE IN F. SPACE 5 x 5 x 64 SINGLE 8.5  
VERTICAL ANGLES 5 x 5 x 64 FOR 1/2 L SINGLE  
3 1/2 x 3 1/2 x 44 AT ENDS IN B. SPACE 68  
C8 GIRDER 47 x 58 FOR 1/2 L TO 46  
IN B. SPACE 64  
BOTTOM ANGLES 5 x 5 x 62 FOR 1/2 L  
TO 50

KEEL PLATE 50 x 116  
FOR 3/5 L 8 AT ENDS  
A IN 52 x 72 FOR 1/2 L  
TO 52  
72 FORD  
B IN 64 x 72 FOR 1/2 L  
TO 52  
72 FORD  
C OUT 66 x 72 FOR 1/2 L  
TO 52  
72 FORD  
D IN 57 x 72 FOR 1/2 L  
TO 52  
E OUT 64 x 72 FOR 1/2 L  
TO 52  
MARGIN ANGLE 4 x 4 x 52



31/10/13  
R  
W843 0128



Midships Section  
C. C. Bunnell & Co.

N<sup>o</sup> 369

S/S - ~~MAAATR~~  
MAIZAR

GLASGOW REPORT No. 37354

W 843 - 0128



© 2021

Lloyd's Register  
Foundation