


28.10.12
16.12.12
(No 269) 19.12.12

SUNDERLAND
Messrs Austin & Sons
Profile & Deck Plans
(268) 21.10.12
No. 268
21.10.12

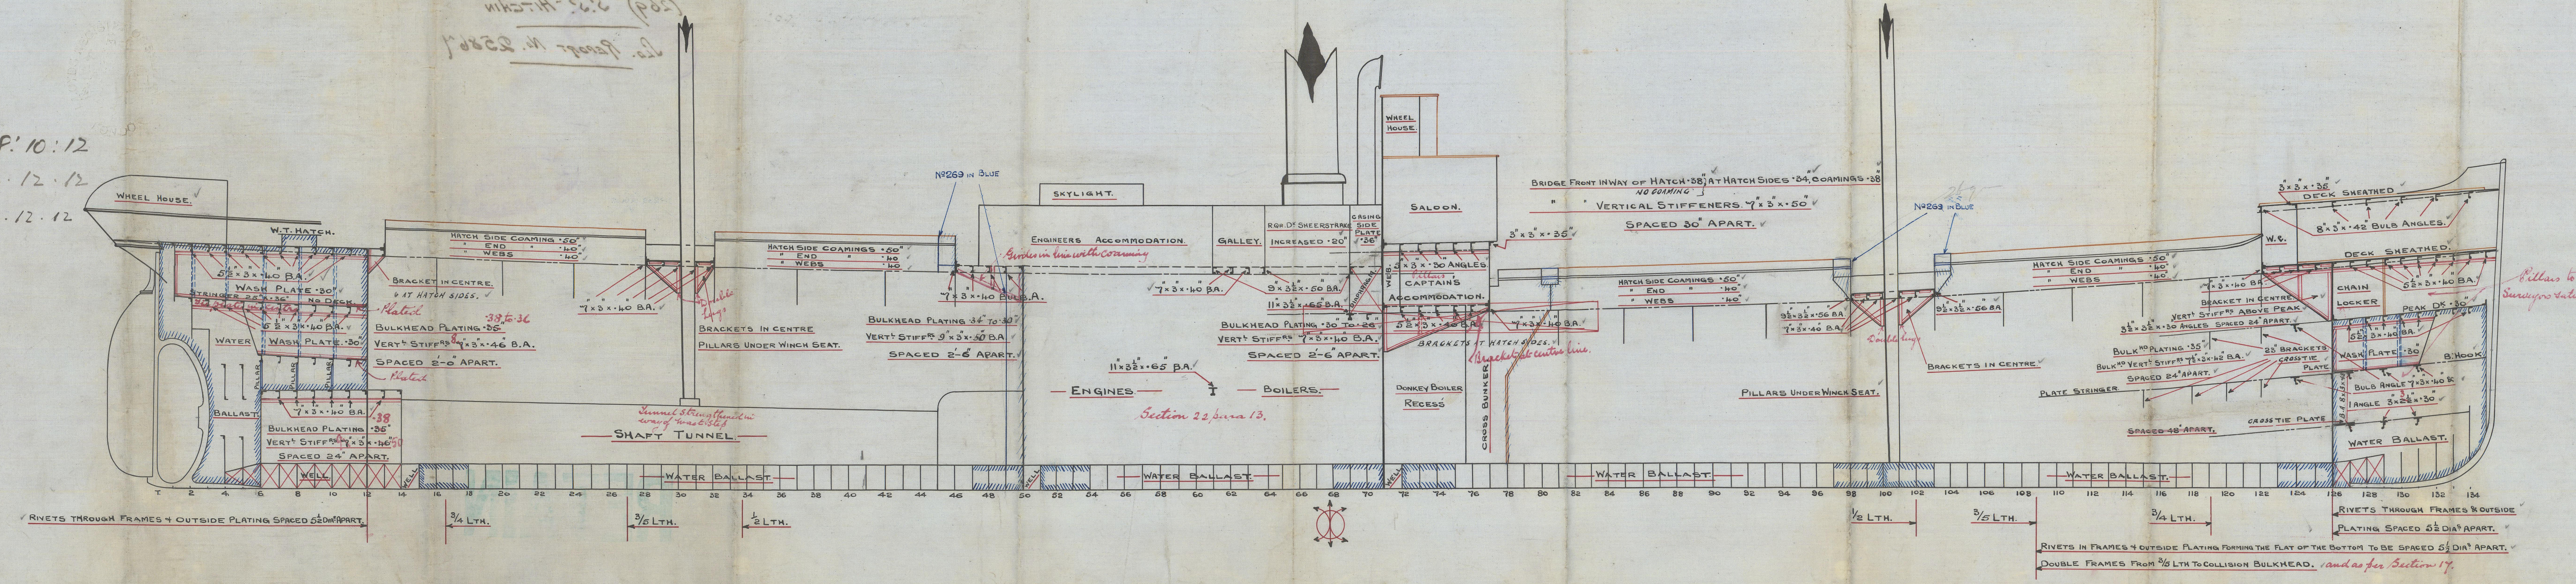


FREEBOARD PARTICULARS.

LENGTH B.P.	267'-0"
" LWL	266'-3"
BREADTH EXT.	38'-0"
DEPTH MLD.	18'-10 1/2"
" HOLD	17'-8 1/2"
SHEER FOR.	7'-6"
" 1/2 FROM FOR.	4'-2"
" AFT	3'-3"
" 1/2 FROM AFT	1'-10"
LENGTH R.Q.D.K.	139'-0" x 4'-6"
" BRIDGE	11'-9" x 7'-5"
" F.C.L.	28'-0" x 7'-5"
COEF. OF DISP.	.78.
U.S. TONNAGE (APPROX)	1485.

- No 268 -
PROFILE & DECK PLANS.

SCALE 1/8" = 1 FOOT.

R.Q.D.K. TYPE, DEEP FRAMES. NO CEILING ON TANK TOP. CARGO BATTENS TO BE FITTED.

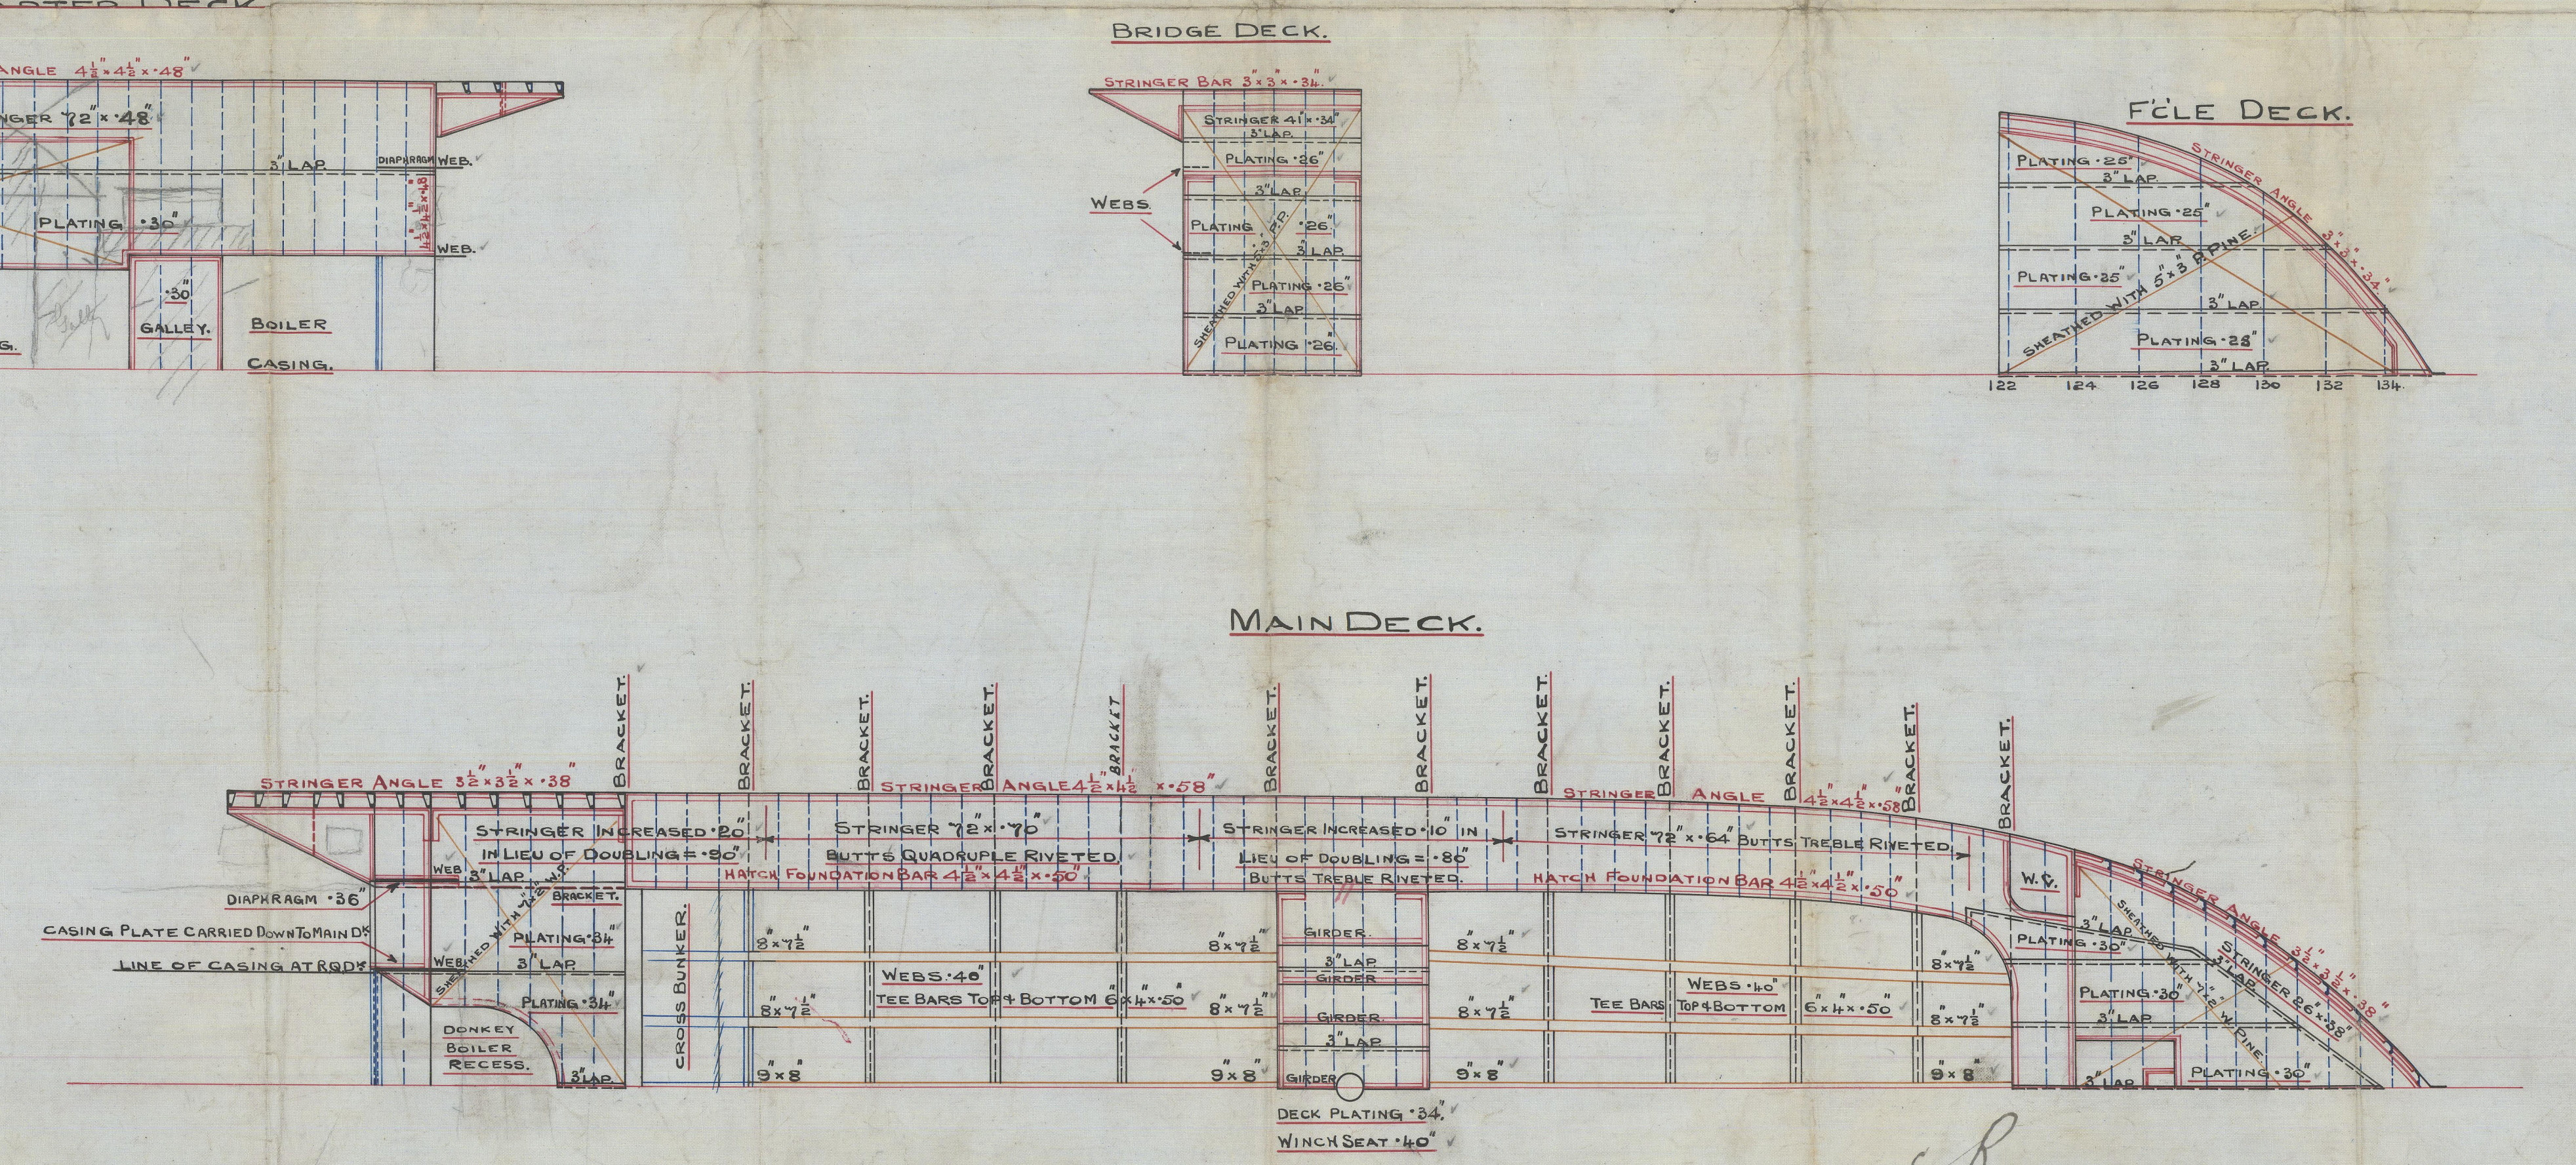

MESSRS AUSTIN'S 268


No. Report- No 25459

(269) S.S. "HITCHIN"

Lab. Report No. 25867

Lloyd's Register
Foundation

W8470223