

W853-0125

Richardsons
Westgarth H^o

308

SUNDERLAND.


Northumbria S/B6^o

176

duplicate of

300

306

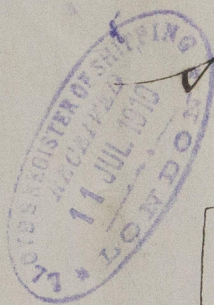

J. L. Messina

LLOYDS TEST
N^o 2868
360 LBS.
28-10-10 F.J.S.

SUNDERLAND. Rpt. No. 24731

RETAIN

Lloyd's



© 2021

Lloyd's Register
Foundation