


21-11-10  
7-12-10

N<sup>o</sup> 578  
PROFILE AND DECK PLANS  
DIMS 255'-0" x 35'-0" x 17'-4" M<sup>o</sup>

Scale 8" = 1' 00"

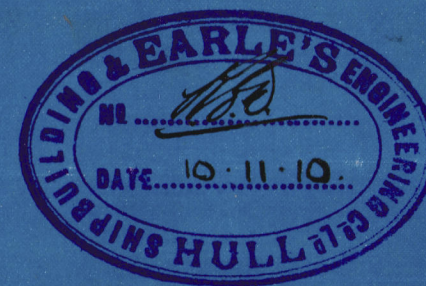


MODIFICATIONS BY EARLE'S S.-E.G. LTD.  
SHOWN IN BLACK PRINTING UNDER LINED.





Sketch of masts  
to be submitted  
6-12-10.

Sketch of Hatchways  
showing end beams side coaming  
to be submitted

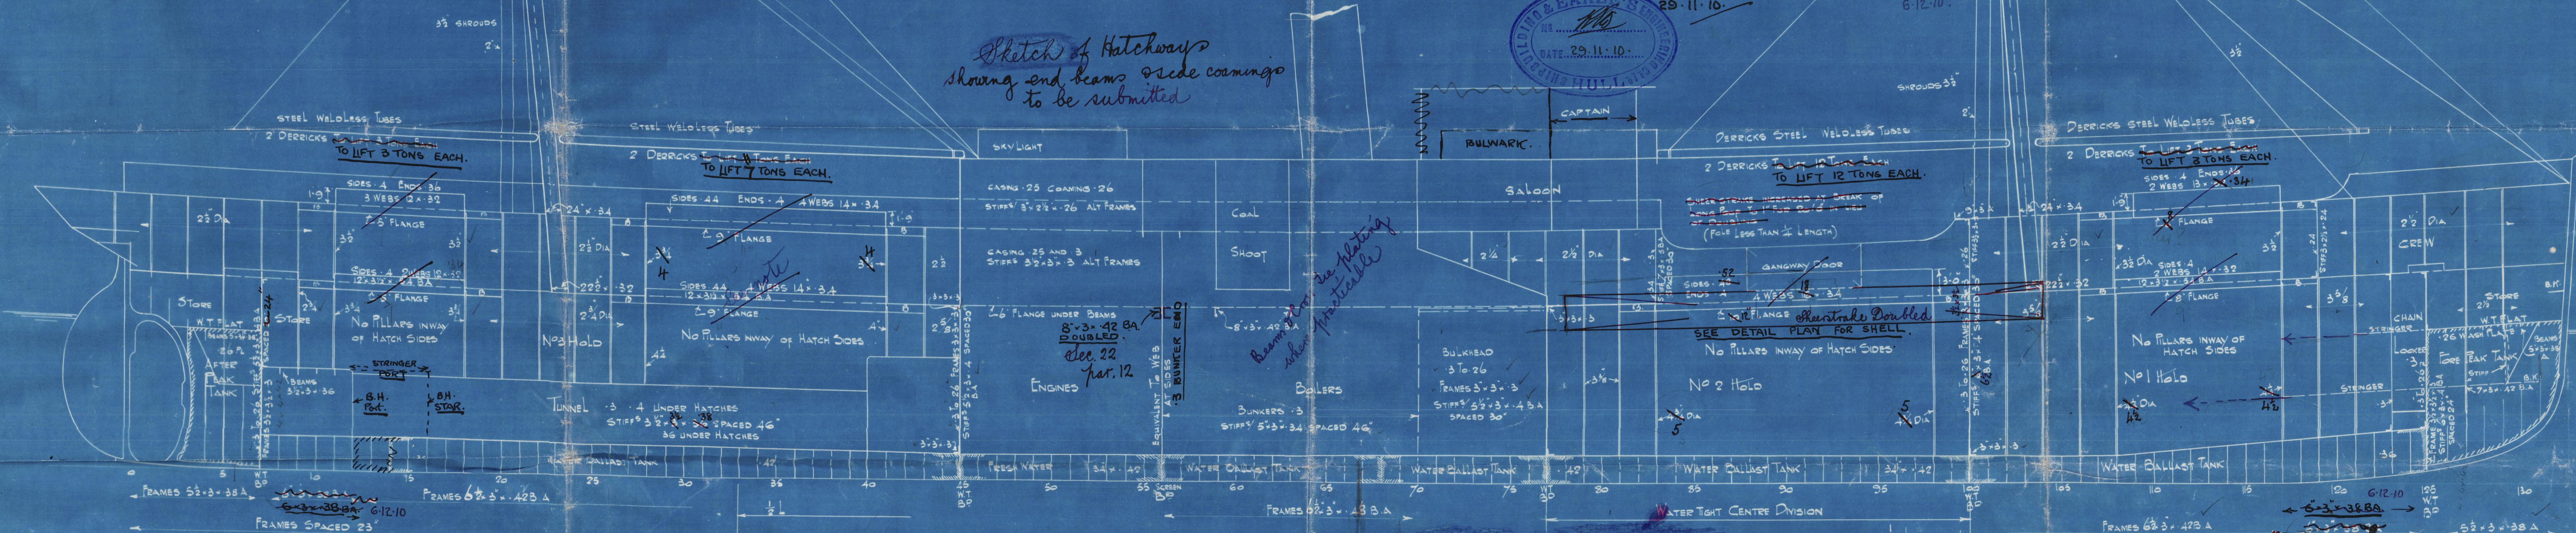


ROOF DECK




FILE DECK

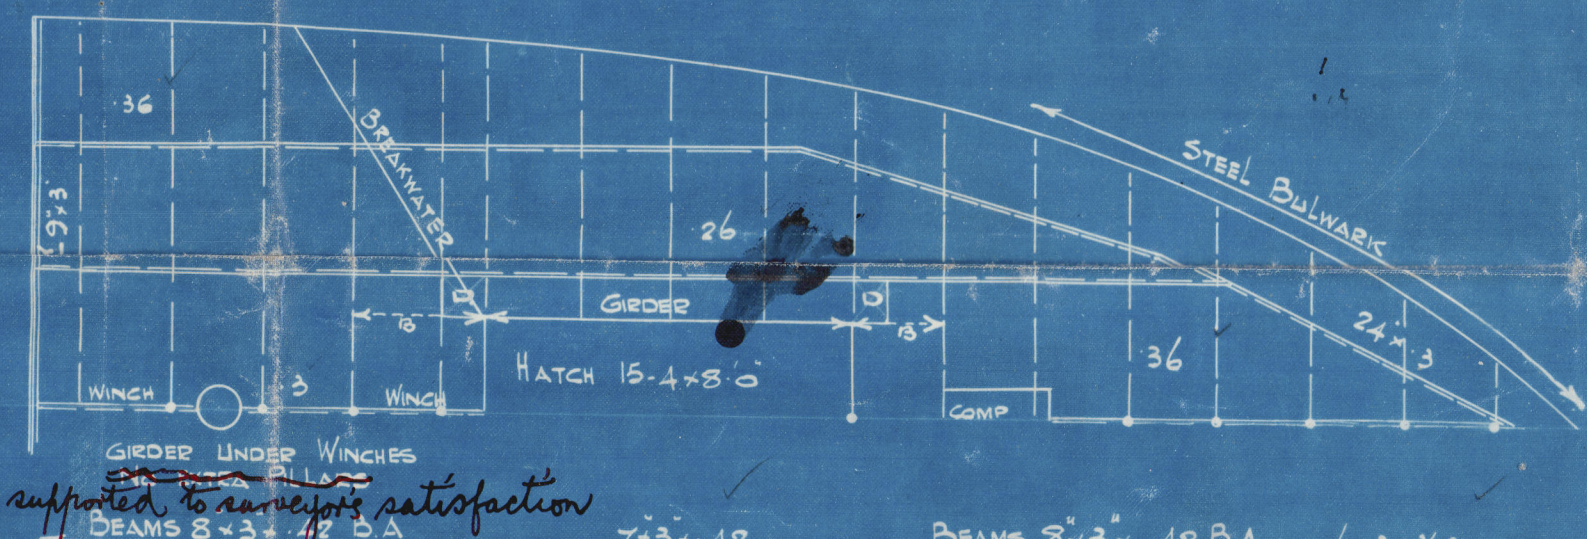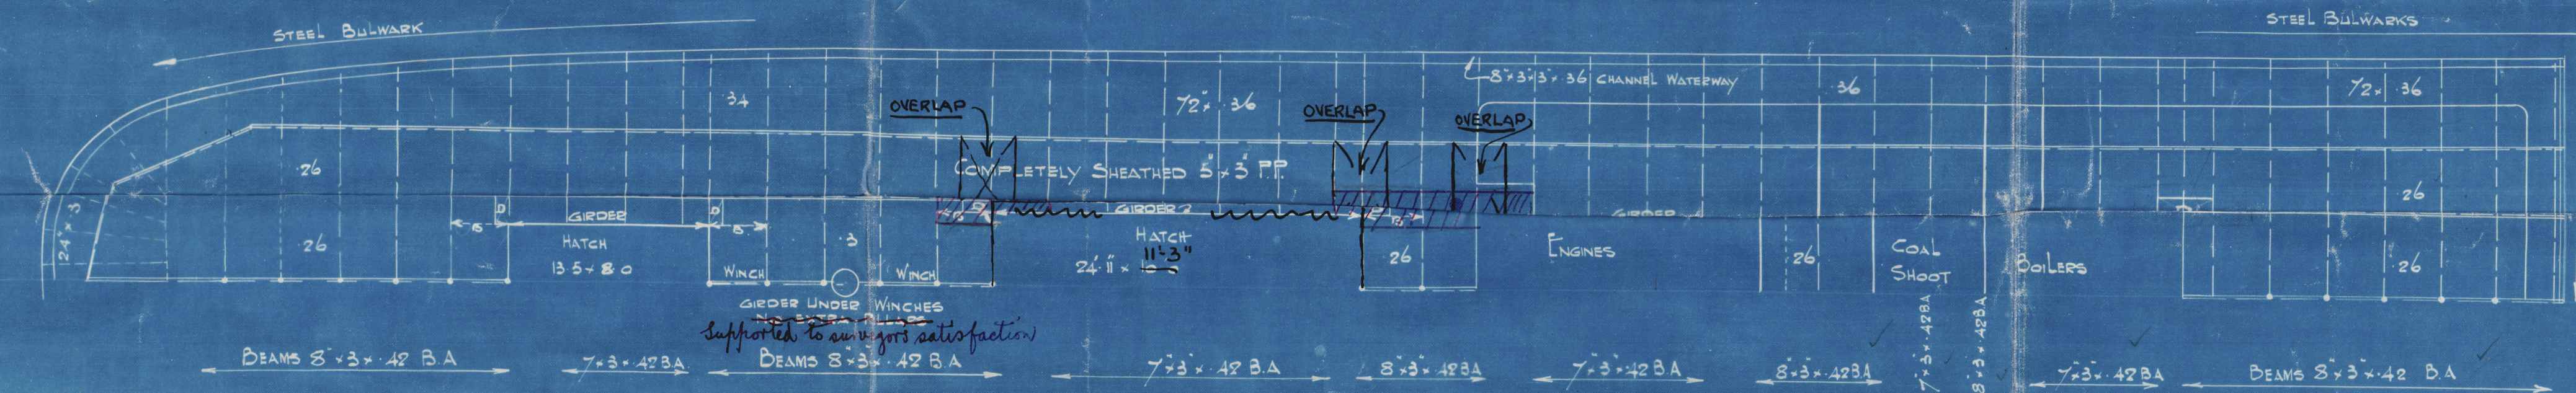

MAIN DECK

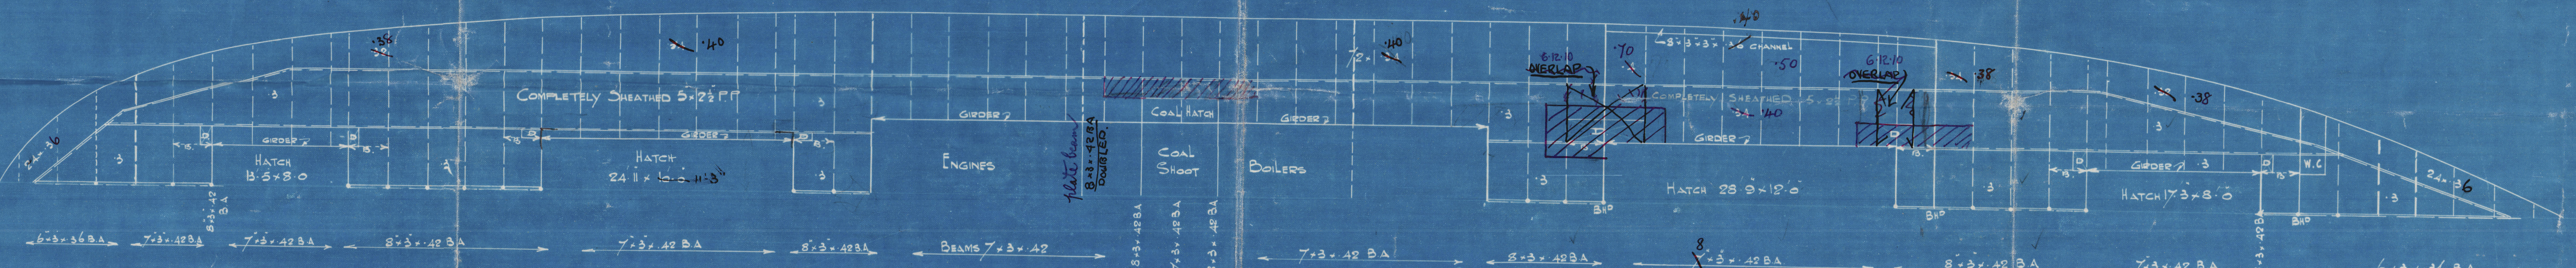

TANK TOP

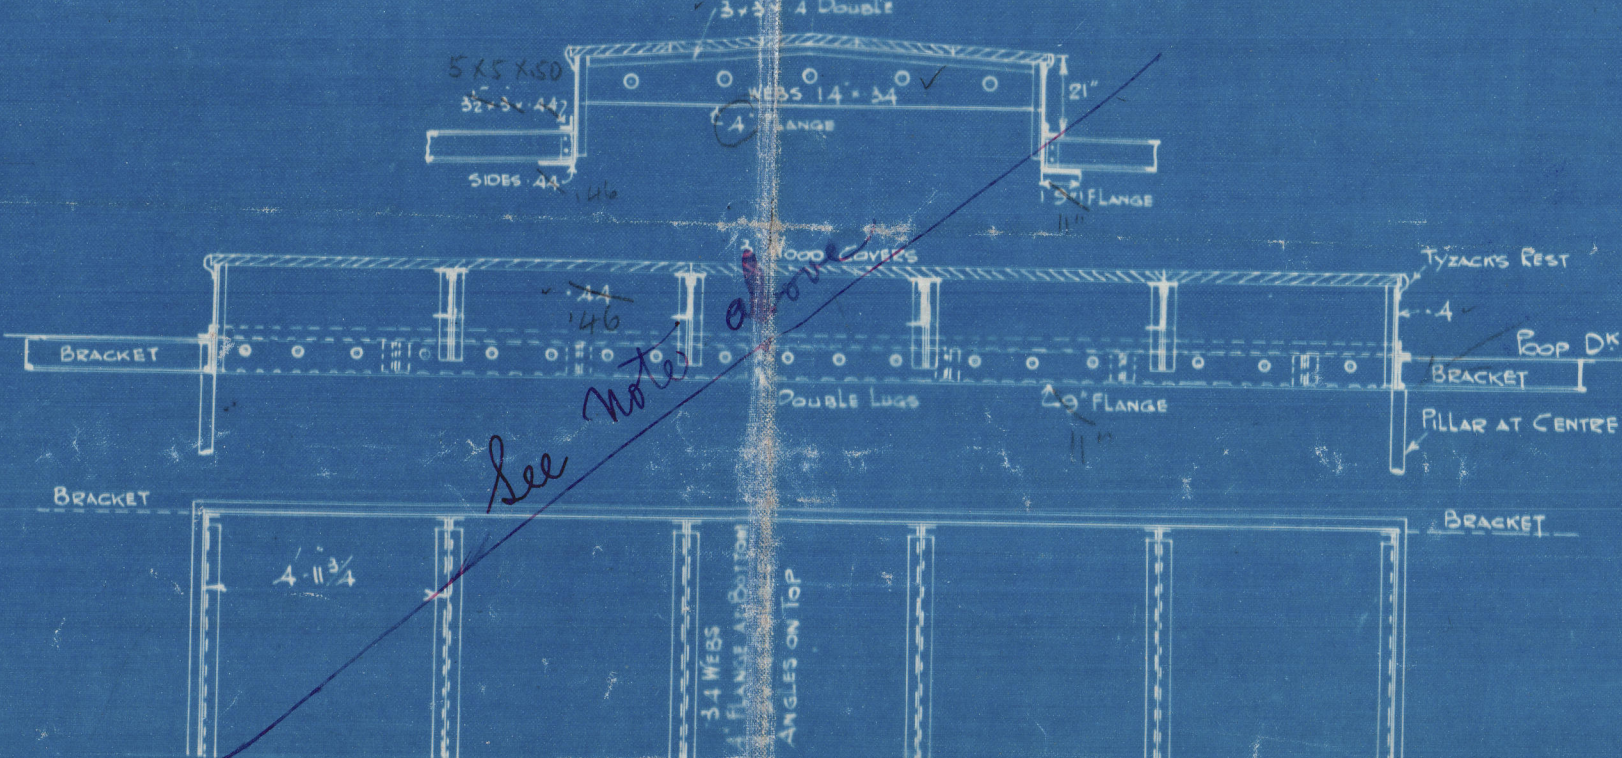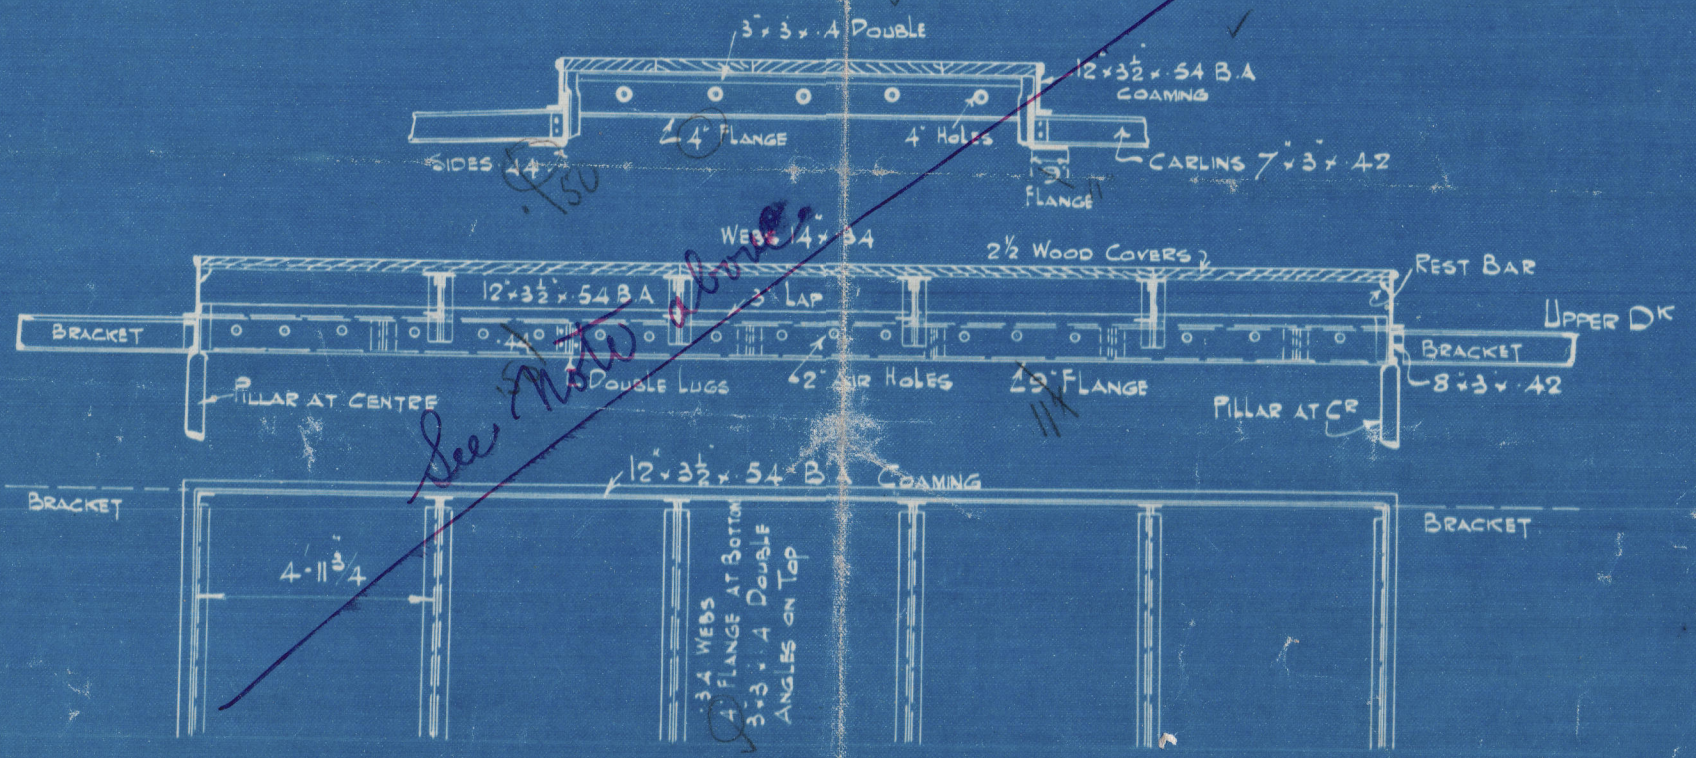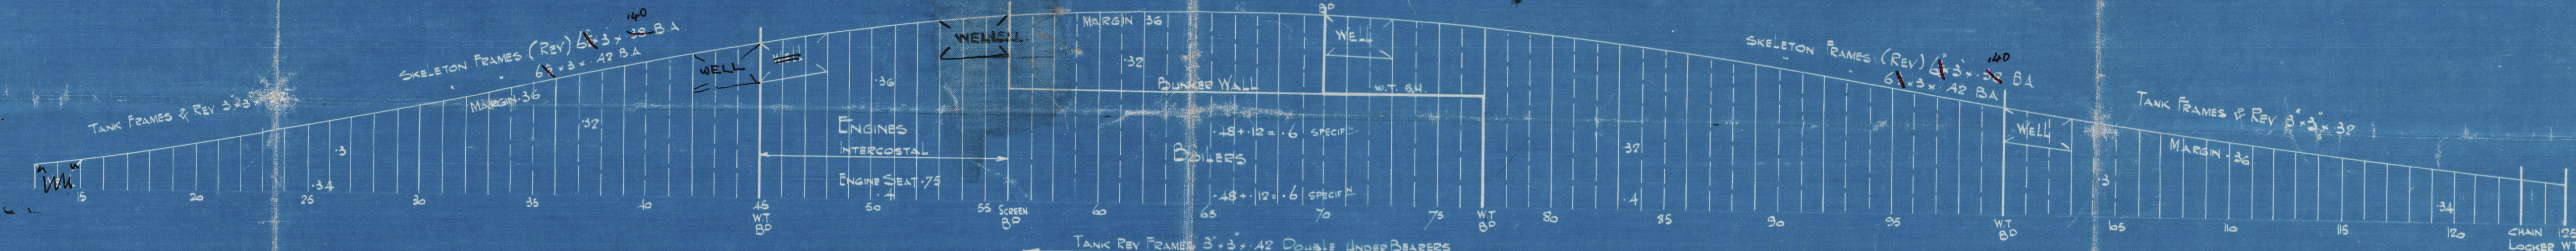




C.F.  
21-11-10



W864-0072

Earle's S. & E. Co.  
No. 578.

Profile and Decks

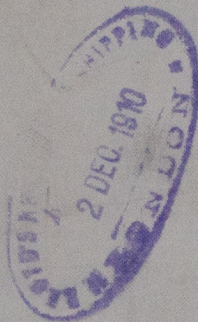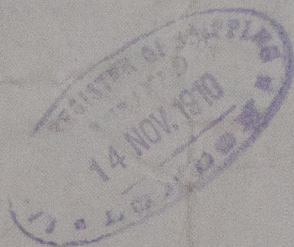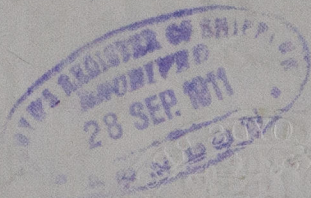

J. H. Arrogate

Hull Rpt No:

24 241.

RETAIN



© 2020

Lloyd's Register  
Foundation



Lloyd's



© 2020

Lloyd's Register  
Foundation