

For the information of Surveyors and the Committee only.

RECEIVED  
NOV 17 1915  
LLOYD'S REGISTER,  
MIDDLESEX ST. LONDON, E.C. 6.

# Lloyd's Register of Shipping.

(Report on Vessel No. \_\_\_\_\_ Port \_\_\_\_\_)

## SHIP FORGINGS OR CASTINGS.

I have to report that the undermentioned Iron or ~~Steel~~ Forgings or Castings, manufactured by Sunderland Forge, of Sunderland for the Vessel No. 650, being built by Richardson Duck & Co of \_\_\_\_\_ have been inspected by me as set forth below and found to be, so far as can be seen, Sound



Forgings or Castings.

Lloyd's  
No. 6903

D. D. Williamson,  
Sunderland,


	STERN FRAME.	RUDDER FRAME.	STEM.
Material	Scrap Iron	/	Scrap Iron
Trade	Forged		Forged
Dimensions	10 1/2" x 4 1/2" & 9" x 4 1/2"		10 1/2" x 2 3/4"
Process on Inspection	Forged & Finished		Forged & Smithed
When Inspected	23-3-15 to 19-6-15		10-11-15
CASTINGS.			
on Standard Test Pieces.			
Tensile Test—			
Stress per square inch			
Elongation per cent.			
Bending Test—			
Angle before fracture			
Impact Test—			
Height from ground			
Hardening Test—			
Made according to Rules			
and found satisfactory			

SKETCHES OF FRAMES SHOWING POSITION AND DESCRIPTION OF WELDS OF FORGINGS.

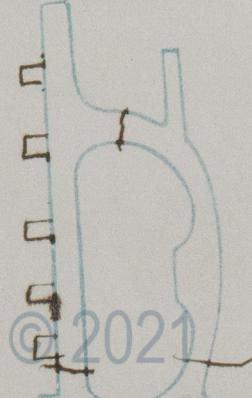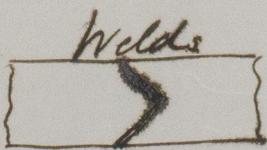

Fee (if any chargeable) £ \_\_\_\_\_  
To be paid at \_\_\_\_\_

If of Iron, state whether scrap or puddled Iron. If of steel, state whether made on the Open Hearth process.

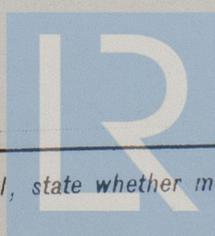

© 2021  
Lloyd's Register  
Foundation



W872-0016

Messrs Richardson Buck & Co  
No 650

Stem & stem frame


Ind. Rep. No 9606

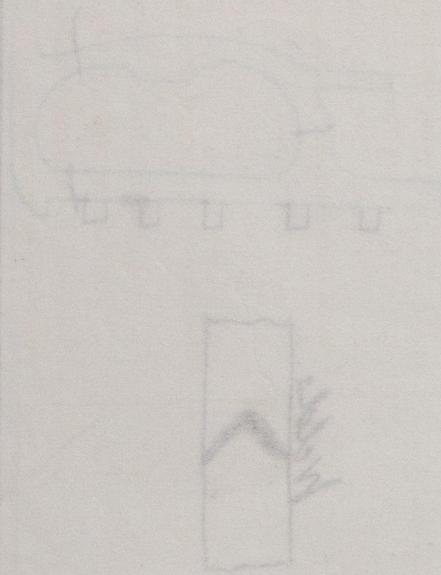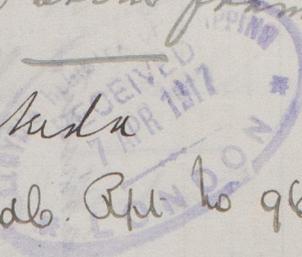

© 2021

Lloyd's Register  
Foundation