
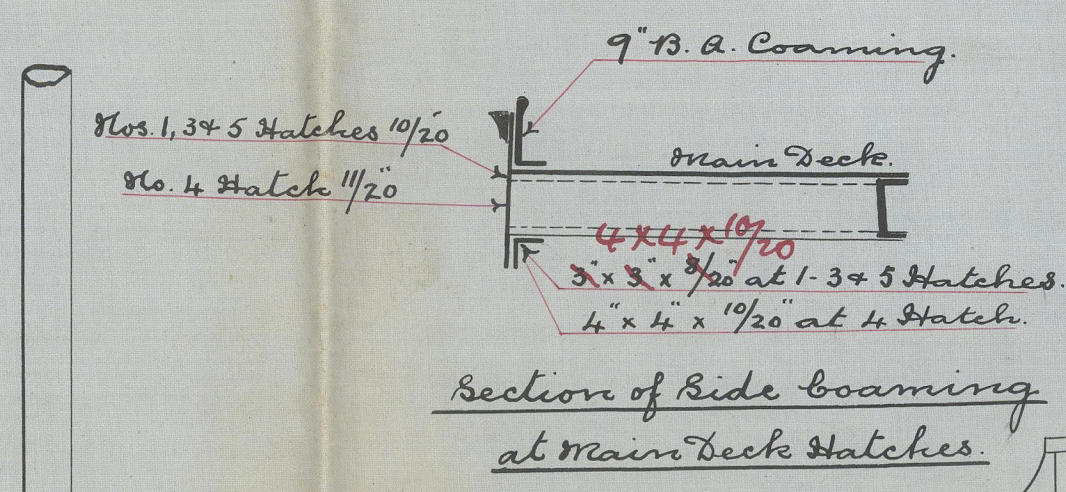
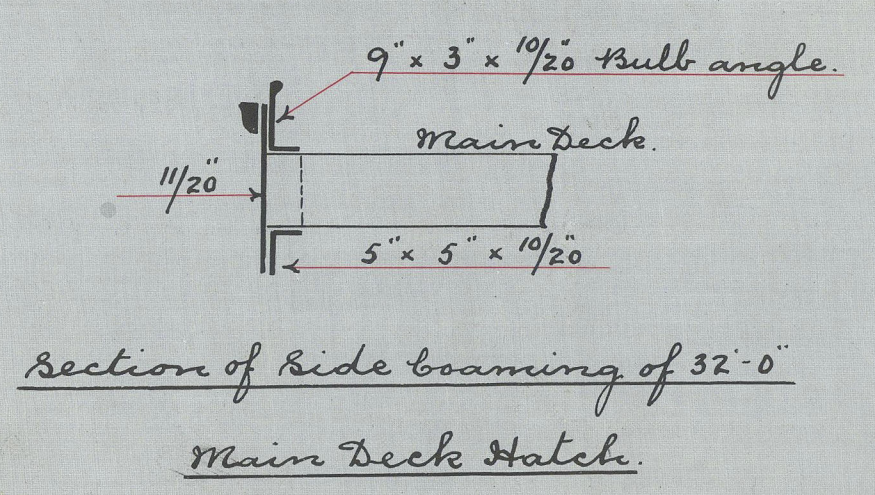
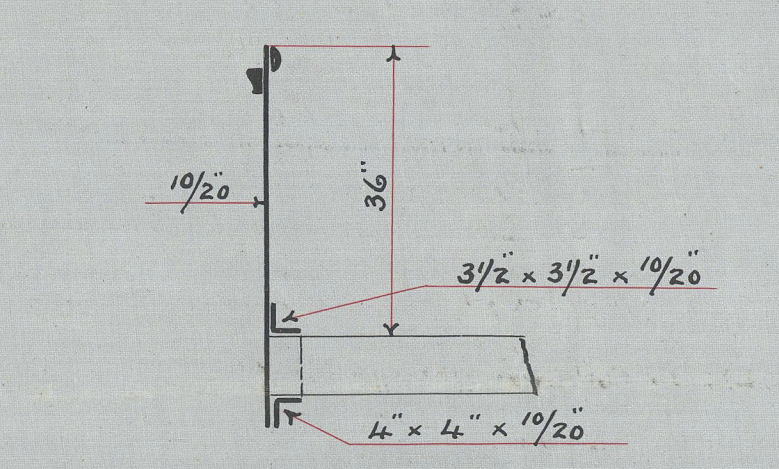


23.1.04



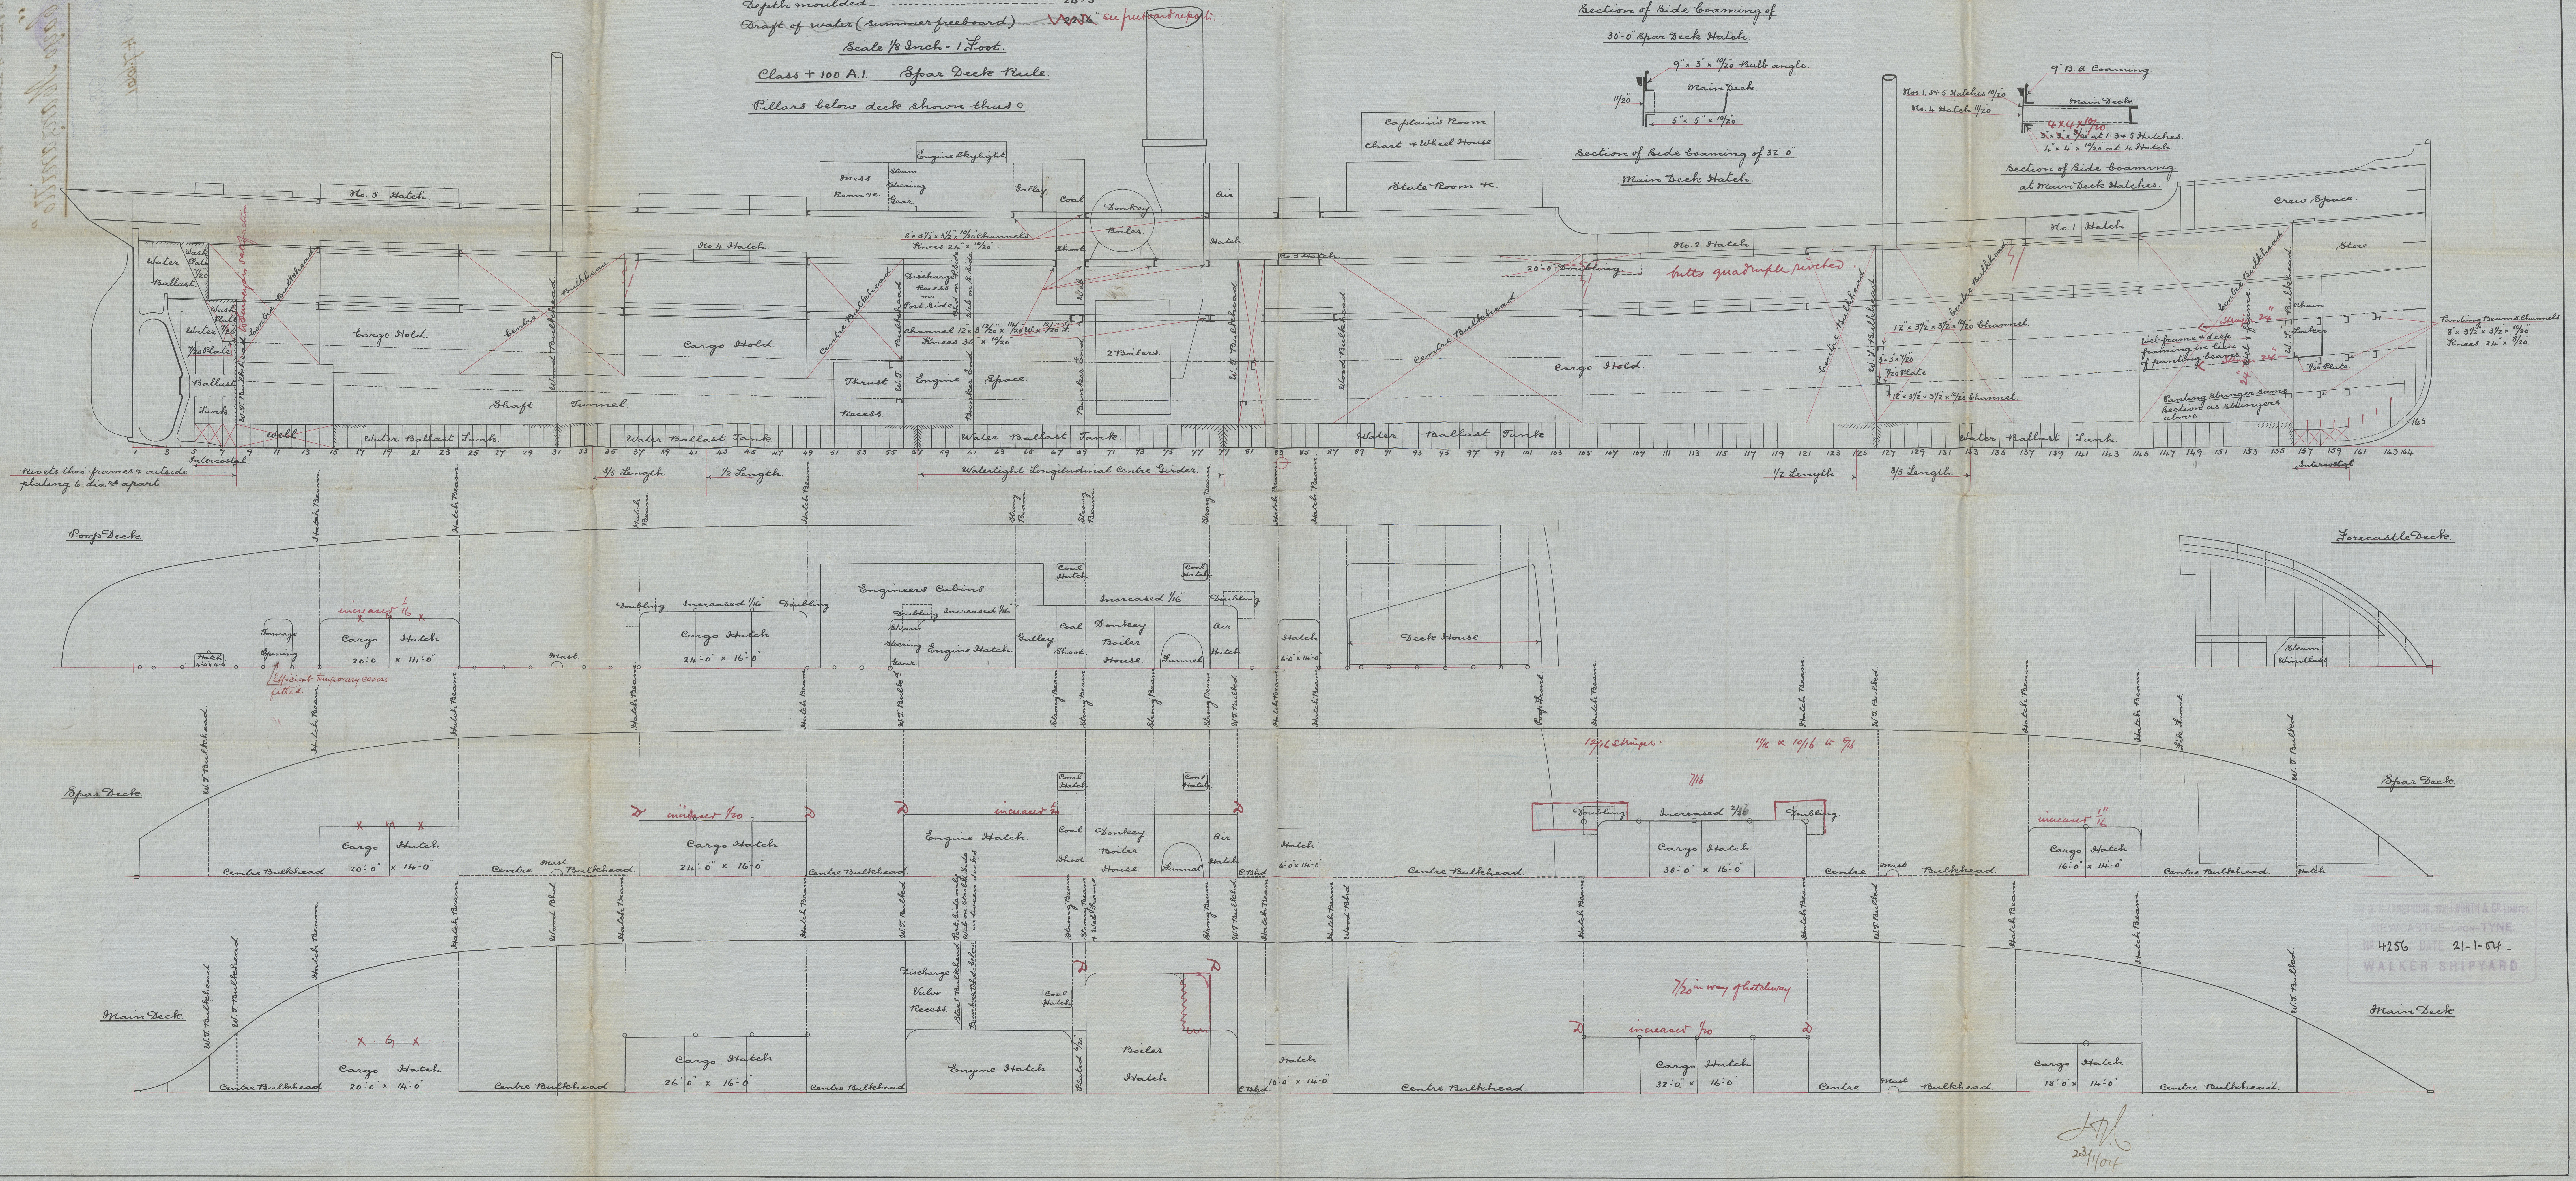

NEWCASTLE-UPON-TYNE.
WALKER SHIPYARD.
DATE 21-1-04.

23/1/04

ARMSTRONG WHITWORTH


S.S. N^o 754

PROFILE & DECK PLANS


"Cayo Manzanillo"

Newcastle Report

N^o H 7.661

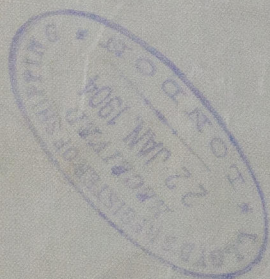

RETAIN

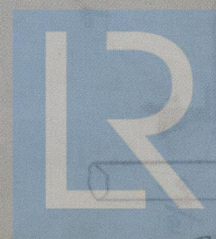

© 2020

Lloyd's Register
Foundation

WJ880-0030