









M.V. ~~THIARA~~ THIARA.

PROFILE & DECK.

DIMENSIONS - 500'-0" L.R.P. x 64'-3" B.M.D. x 37'-0" D.M.D.

SCALE - 1/8" = ONE FOOT.

ALL SECTIONS ARE N.B.S.

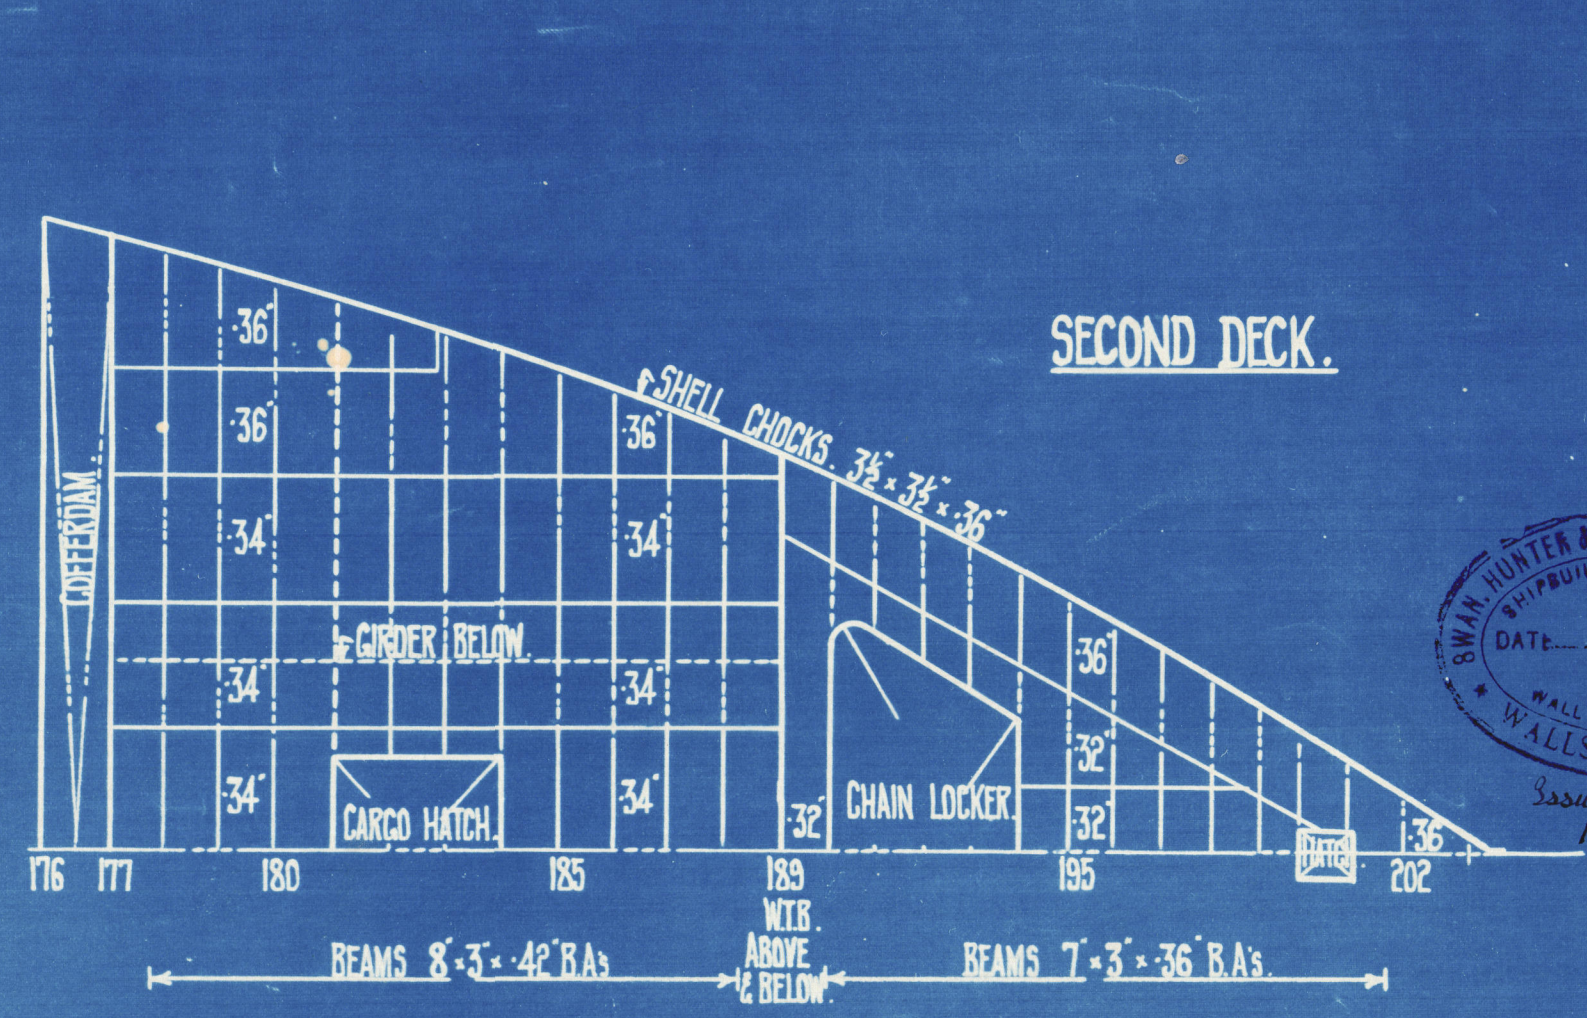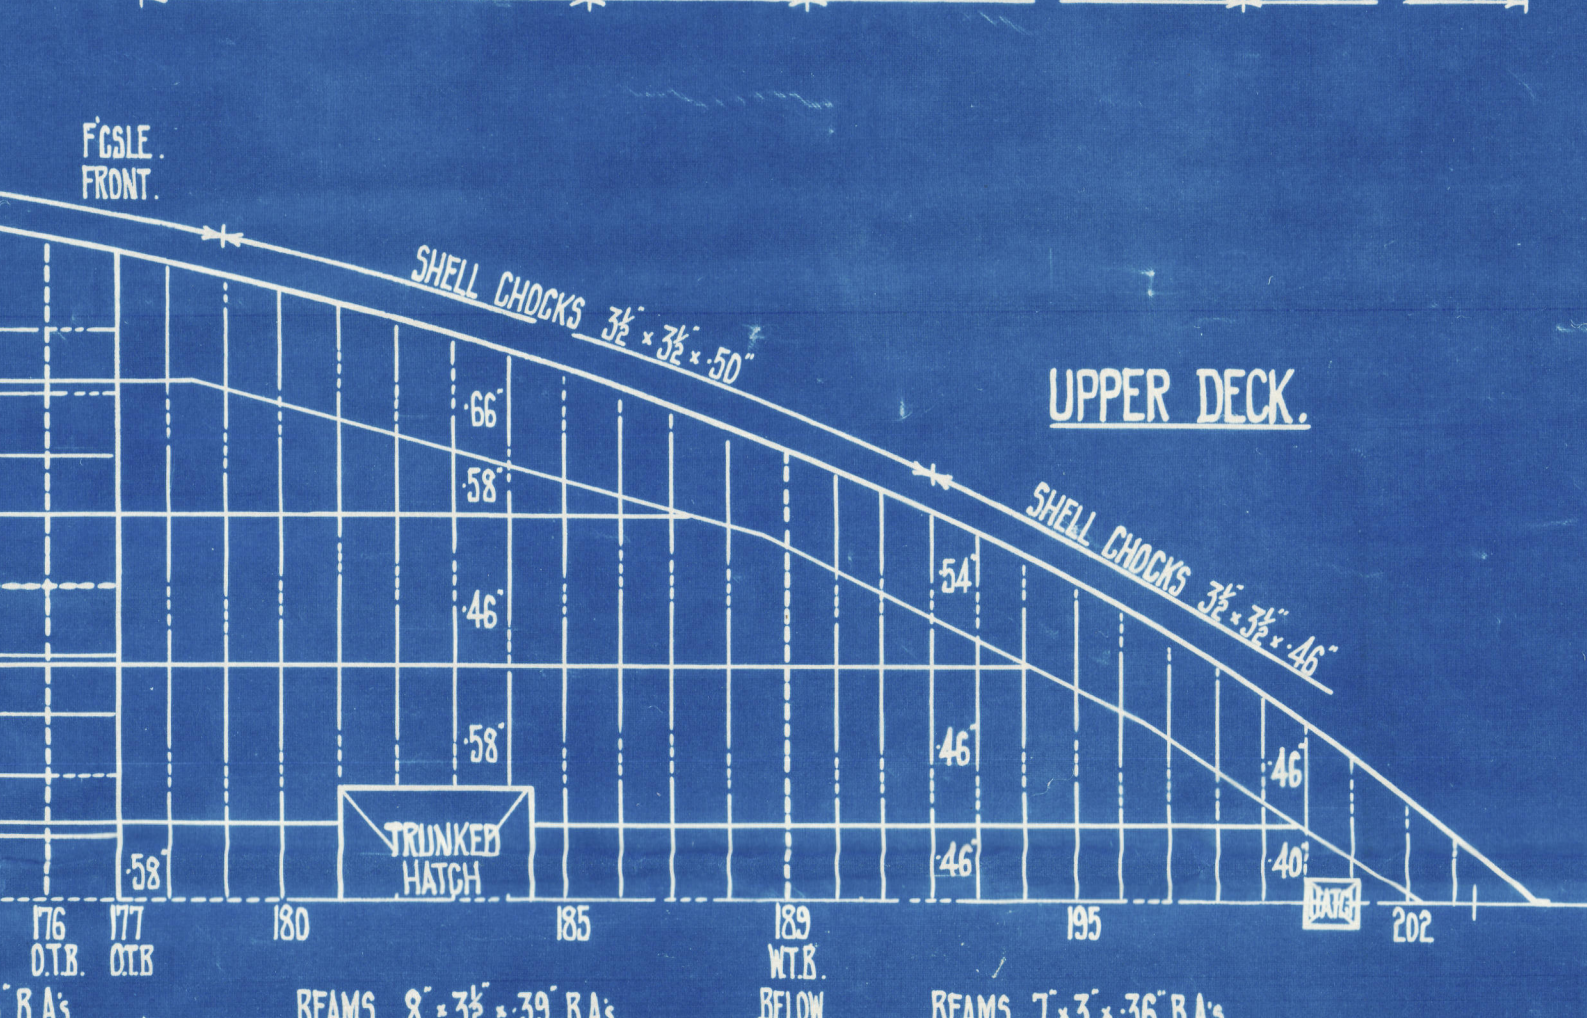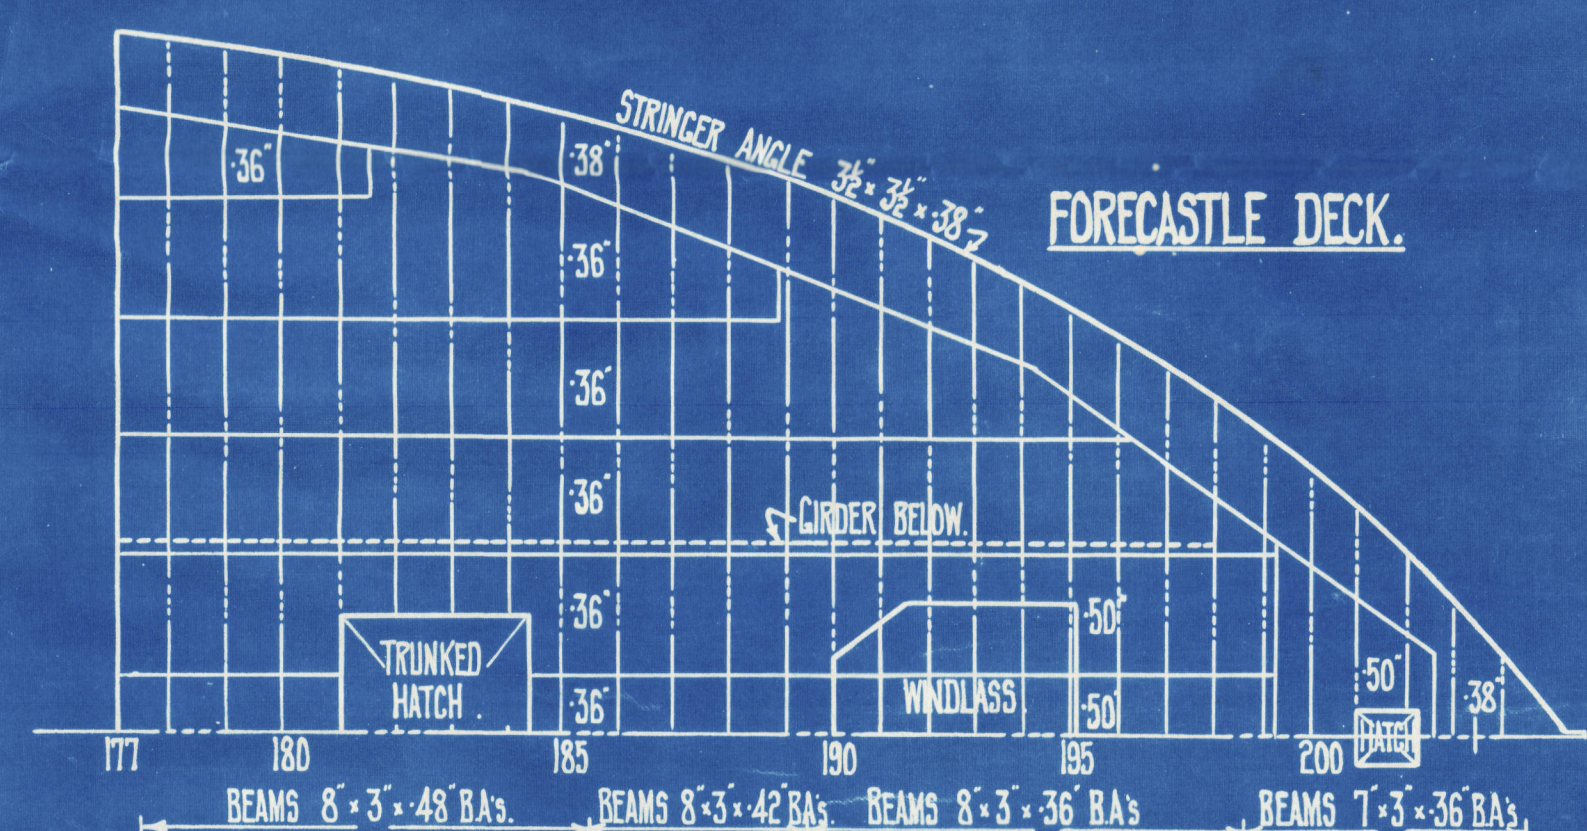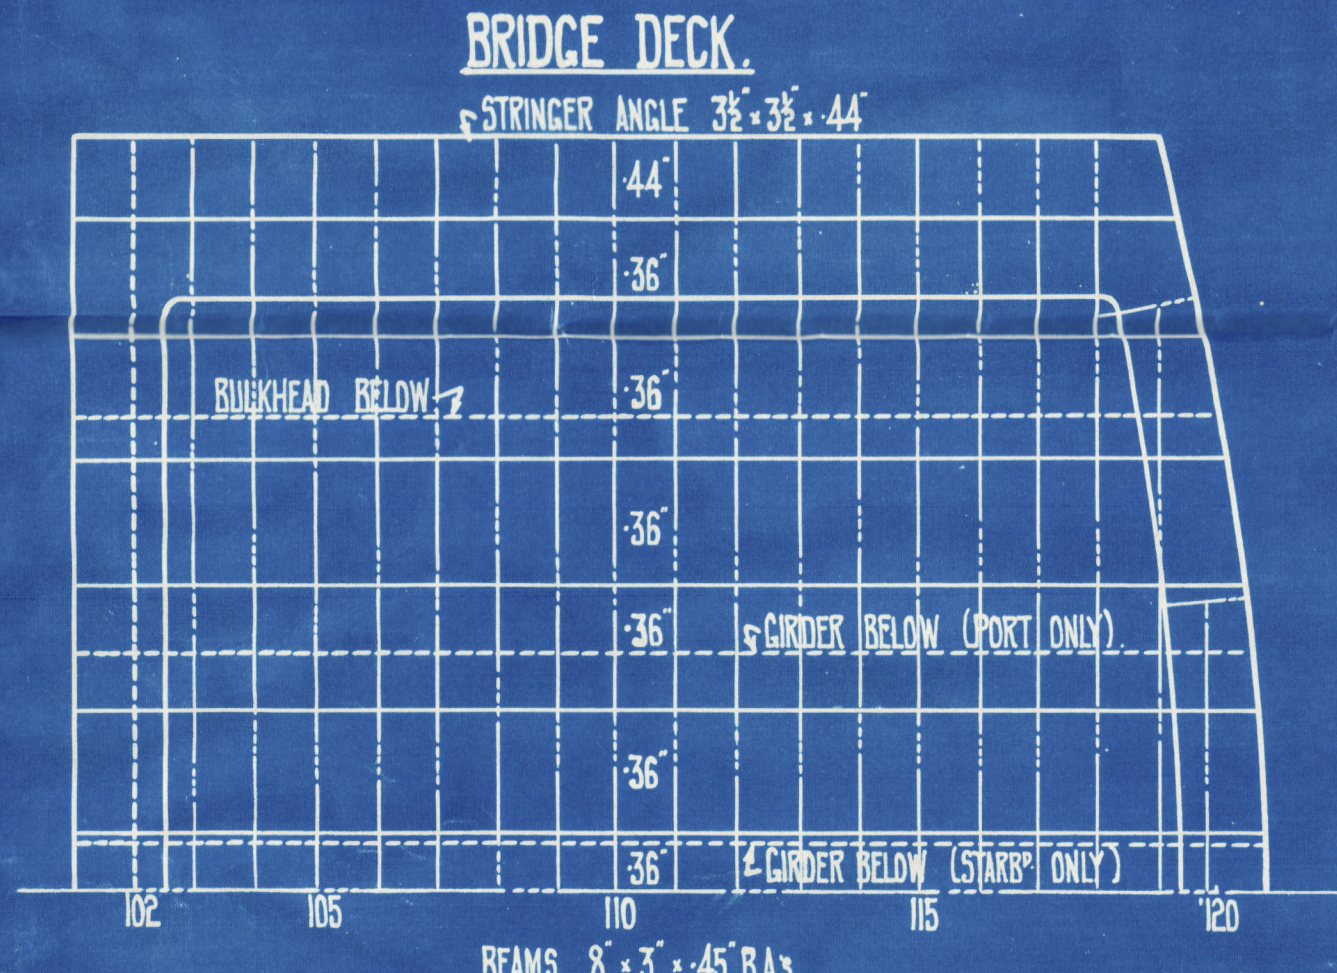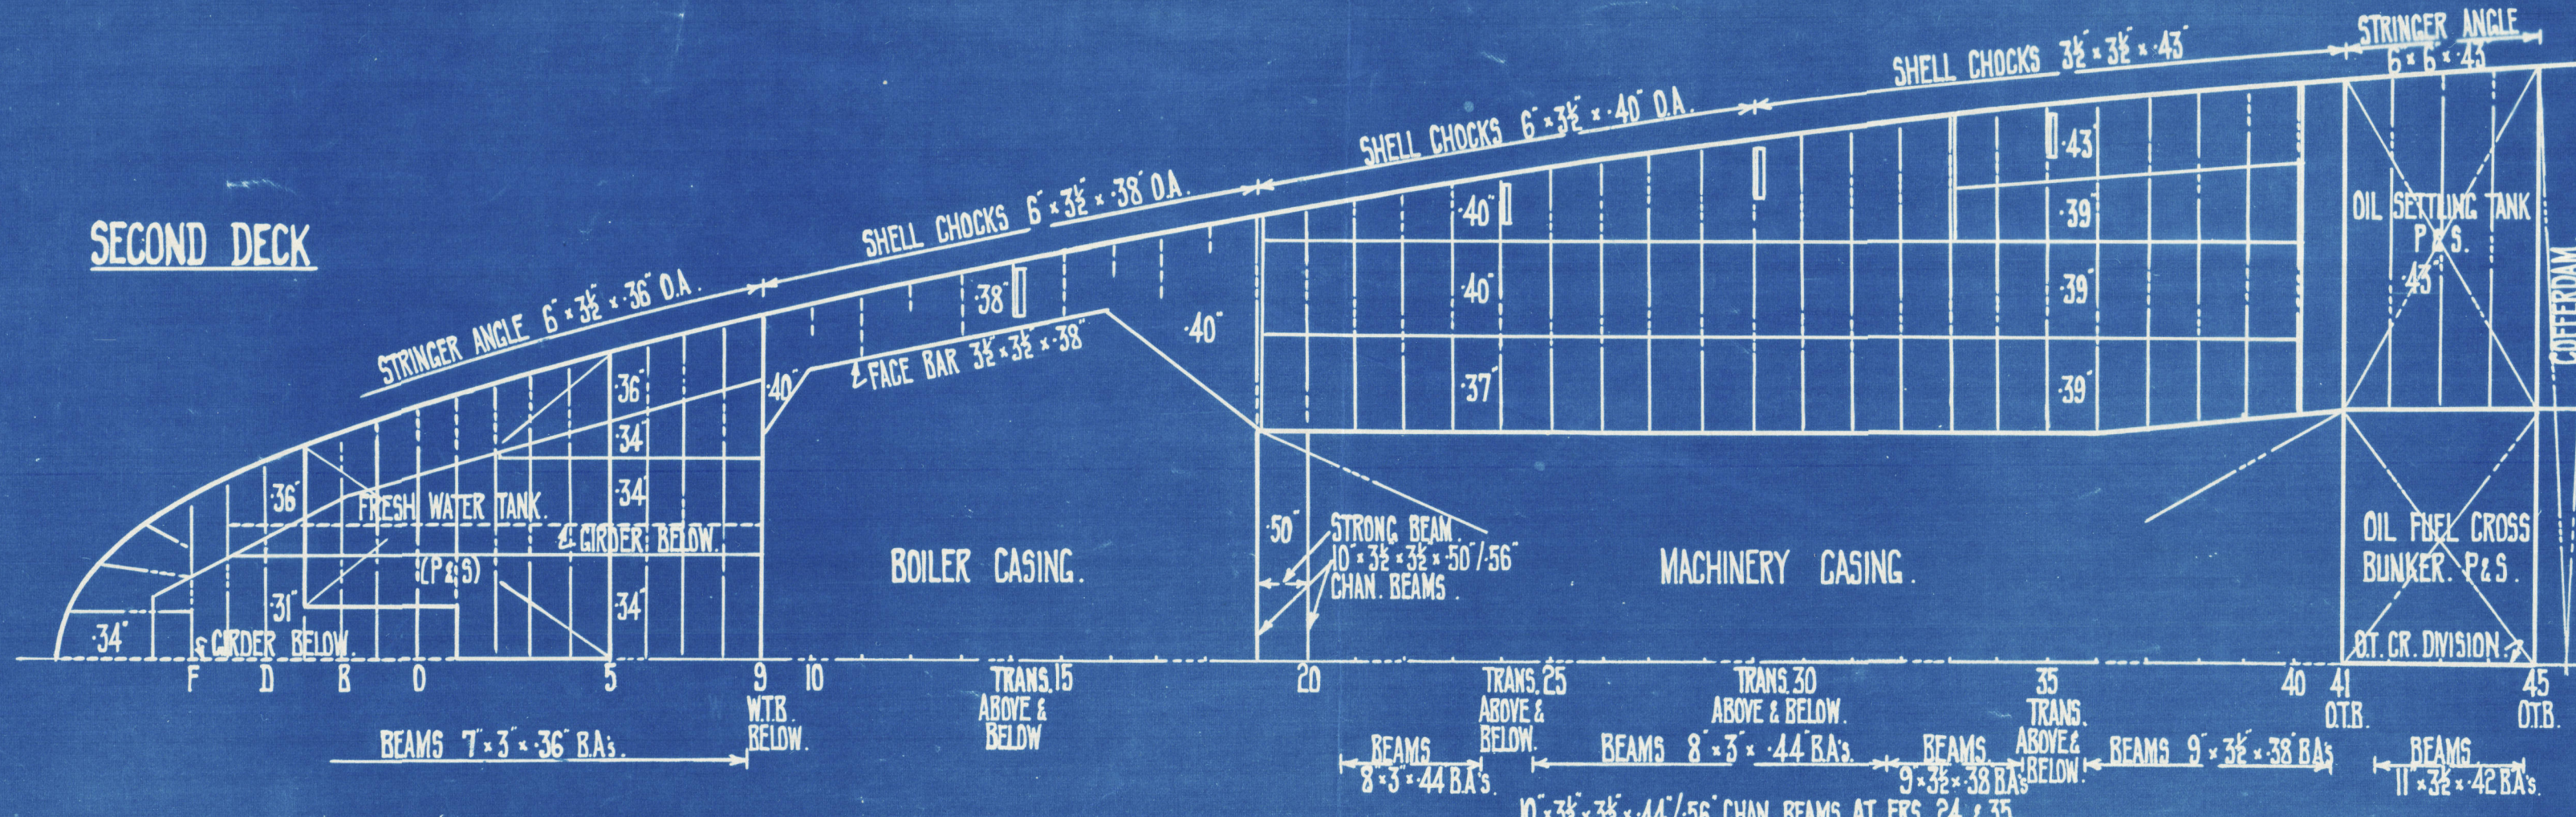 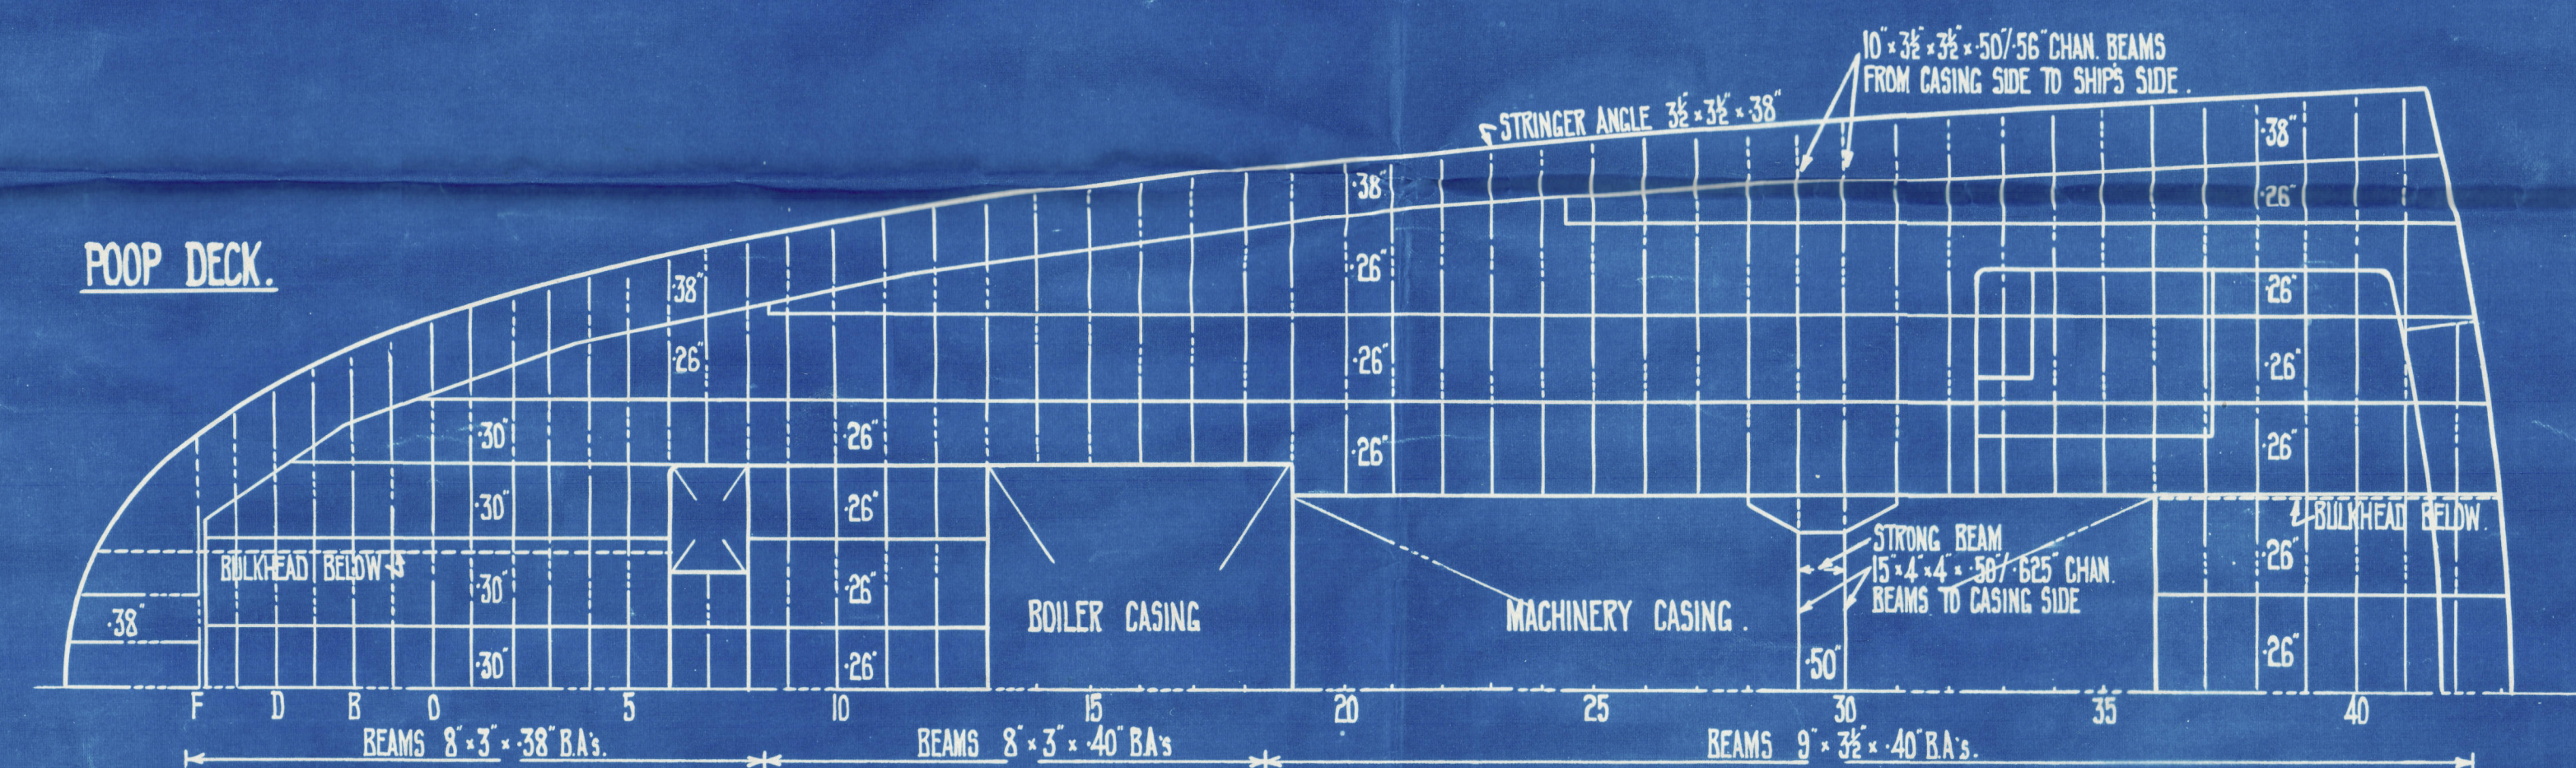 

SWAN, HUNTER, & WIGHAM
RICHARDSON LTD.

SHIP NO. ~~1561~~ 1563.

Profile & Decks.

m. v. "Thiara"

NEWCASTLE ON TYNE.

Report No. 97941.



© 2021

Lloyd's Register
Foundation

W89-0017