


Scantling Profile & Deck Plan S.S. N°121

SCALE $\frac{1}{4}'' = 1 \text{ FOOT}$



7.8.09
16.8.09
28.8.09
9.9.09

Lloyd's register

1d

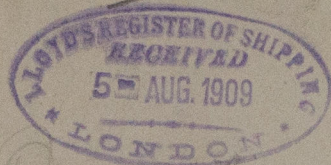

Profile

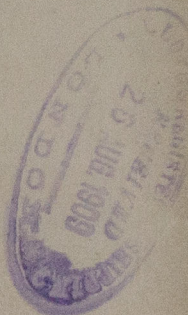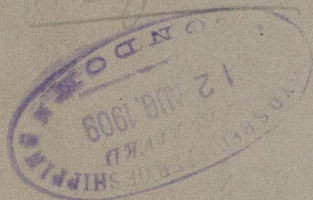

*2 sheets showing doubling
at hand etc*

*S/S Fairisle
Nov 7281*

RECEIVED

W895-0111



© 2020

Lloyd's Register
Foundation